


FORMERLY
JAMES HILL
NOW
D. RICHARD HILL

FORMERLY
H. S. & W. M. FERGUSON
NOW
MYRON A. SHOFFNER

FORMERLY
THOMAS FERGUSON
NOW
MYRON A. SHOFFNER

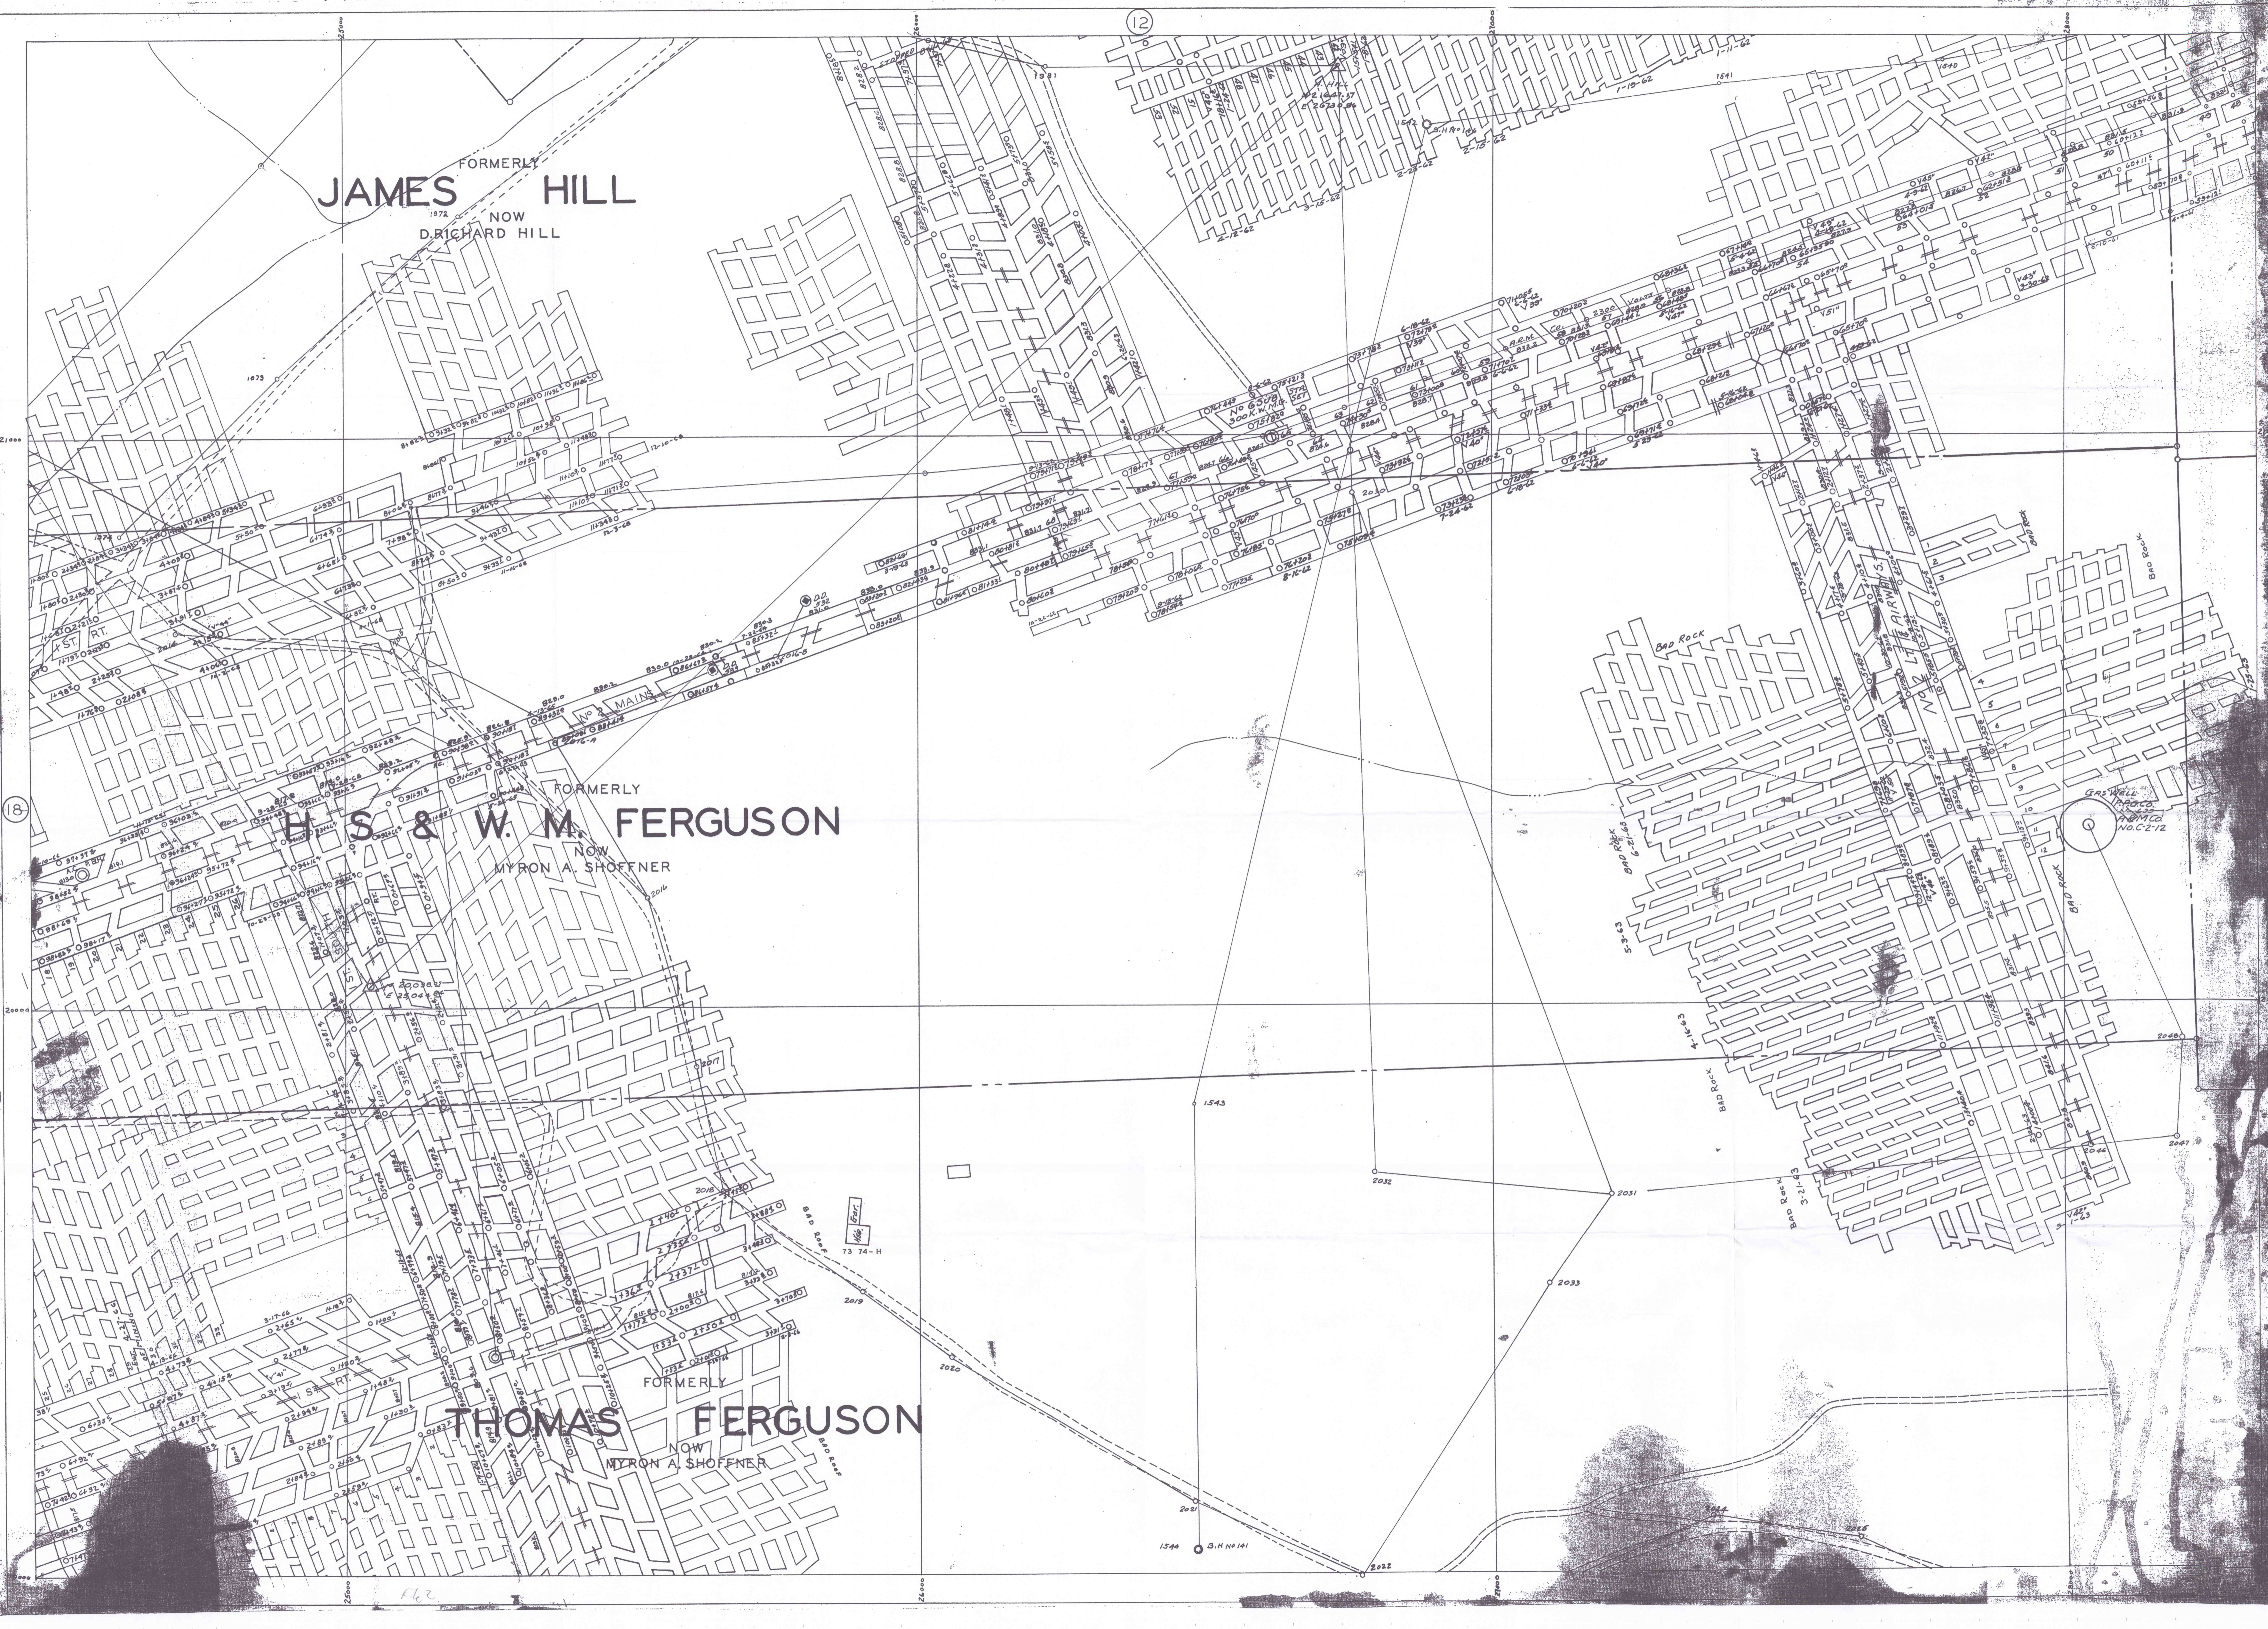

(18)

(12)

(11)