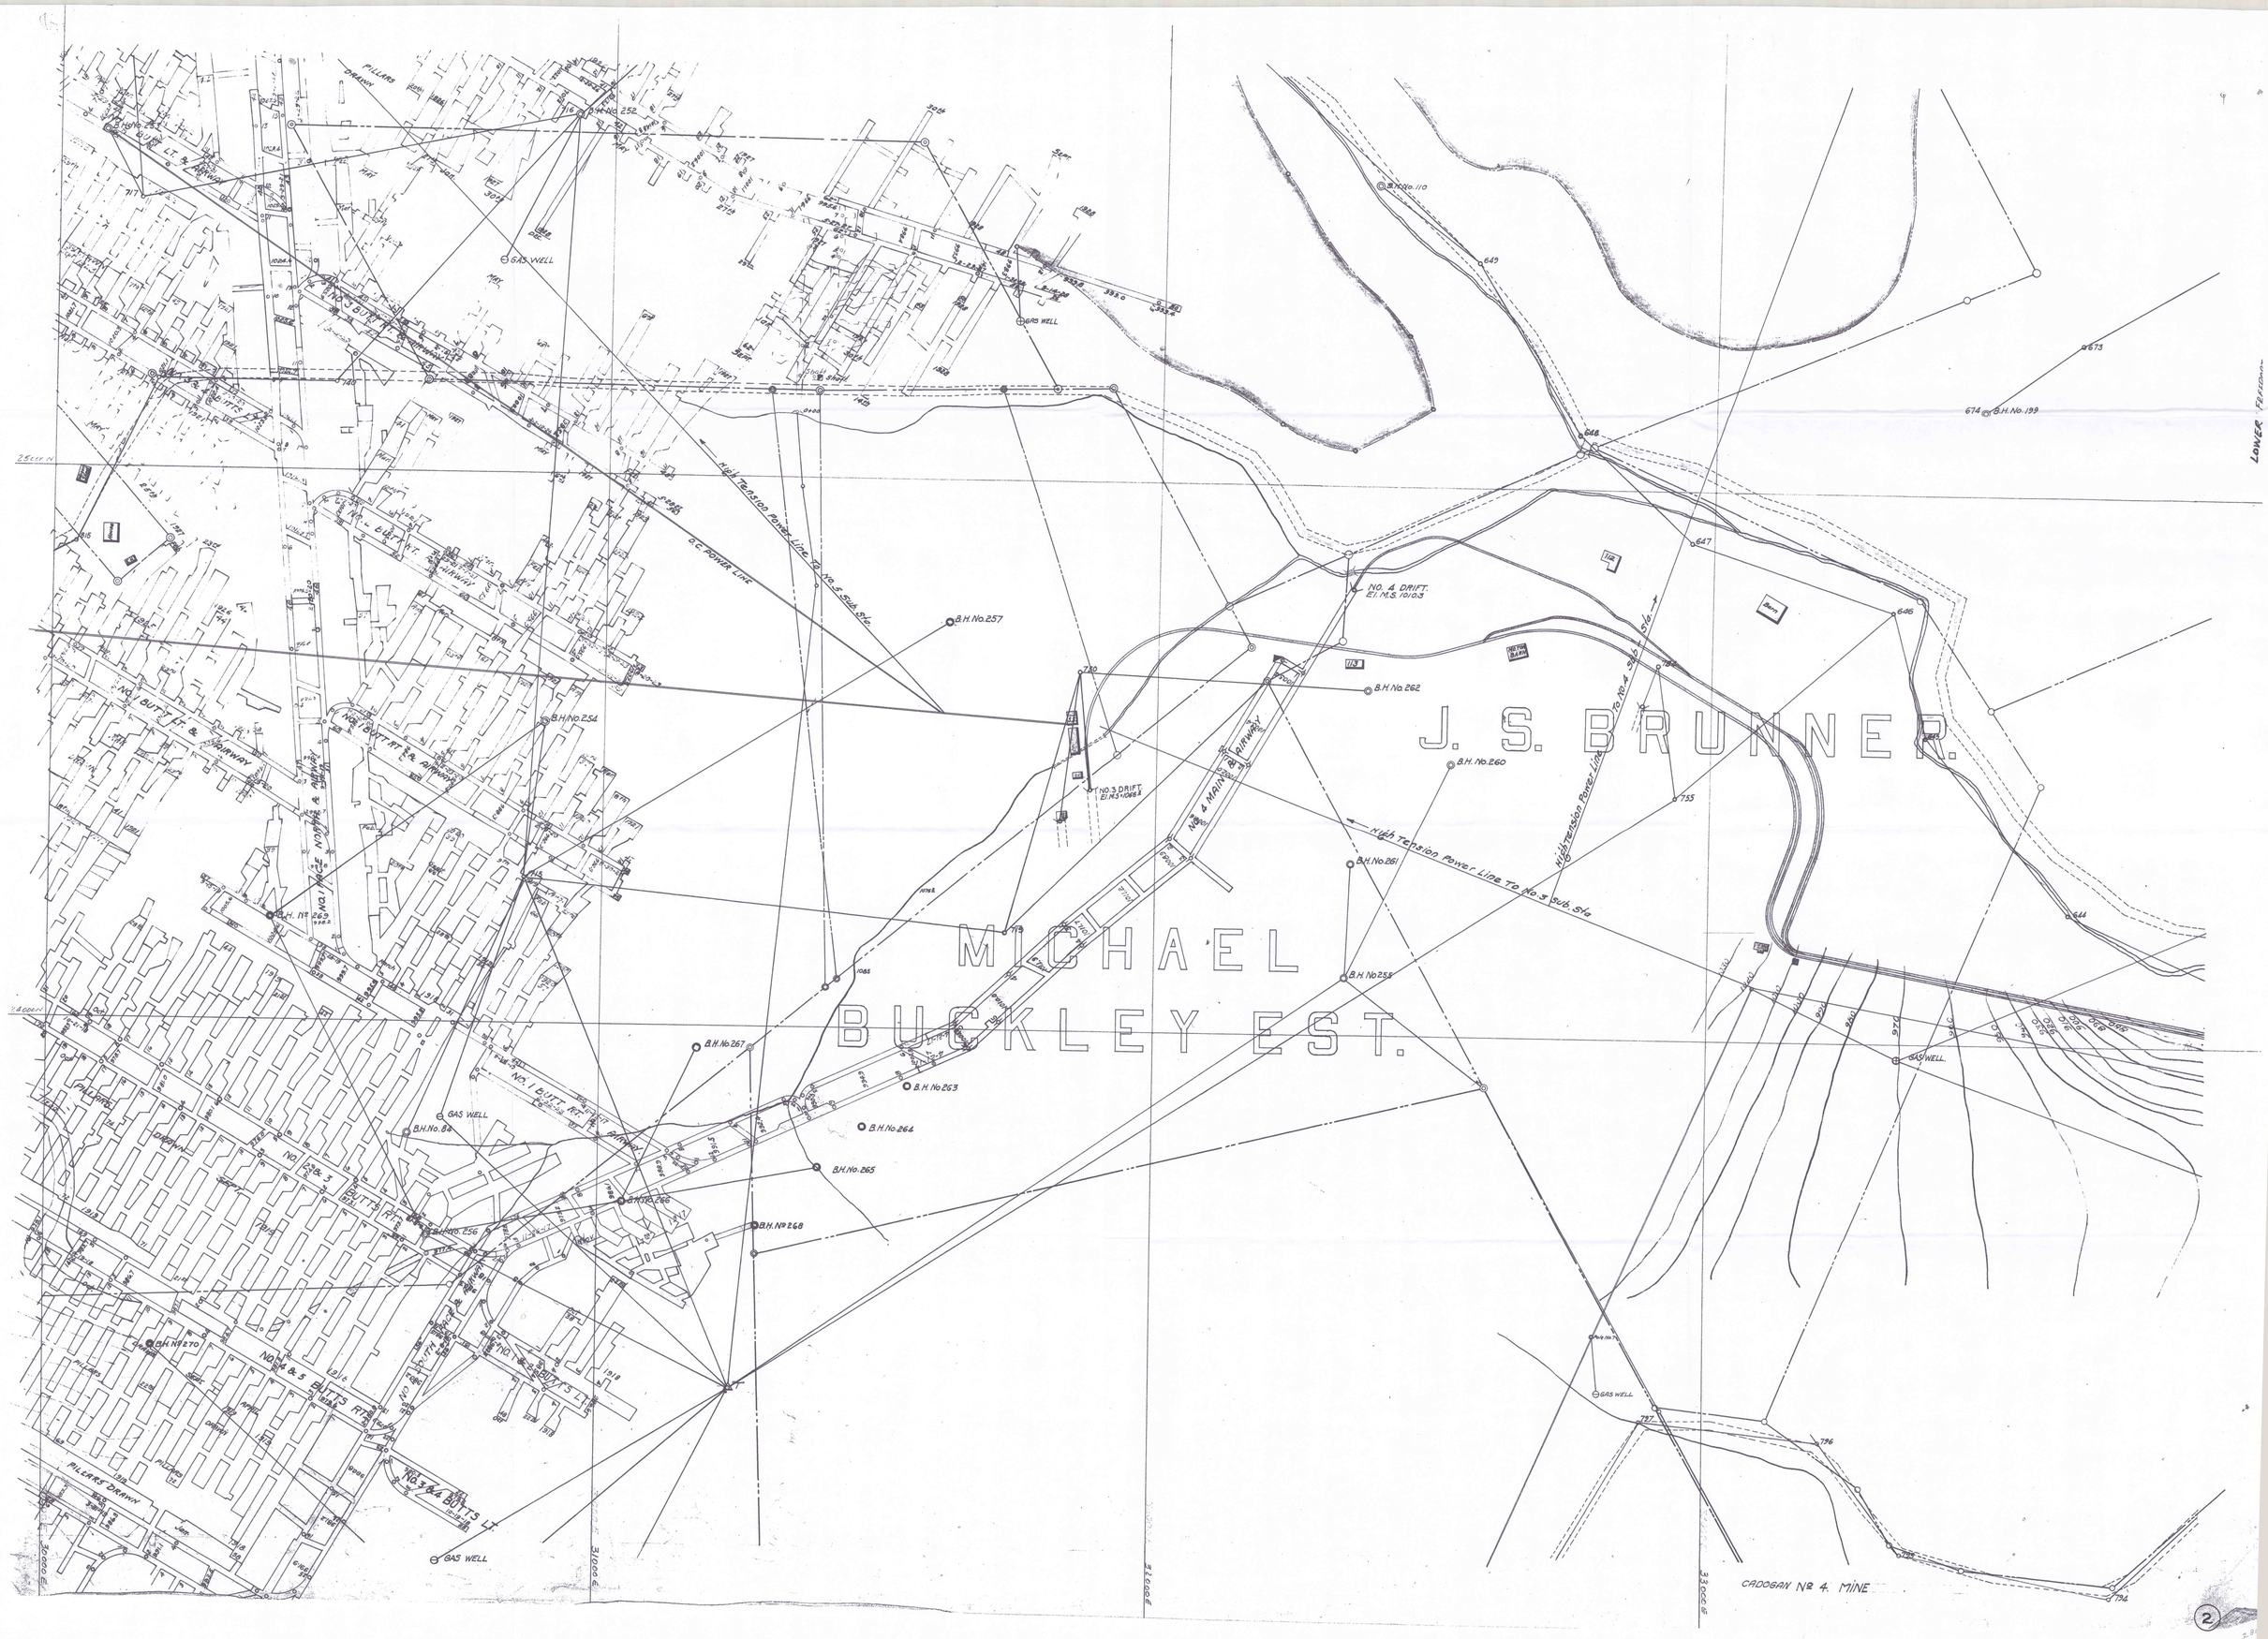
J. S. BRUNNER.
MICHAEL BUCKLEY EST.
CADOGAN No 4. MINE
LOWER
High Tension Power Line To No. 5 Sub. Sta.
High Tension Power Line To No. 3 Sub. Sta.
High Tension Power Line To No. 4 Sub. Sta.
D.C. POWER LINE
NO. 4 DRIFT. El. M.S. 1010.3
NO. 3 DRIFT. El. M.S. 1066.3
NO. 4 MAIN & AIRWAY
NO. 1 BUTT. RT. & AIRWAY
NO. 1 BUTT. LT. & AIRWAY
NO. 2 & 3 BUTTS RT.
NO. 4 & 5 BUTTS RT.
NO. 3 & 4 BUTTS LT.
PILLARS DRAWN
GAS WELL
B.H. No. 252
B.H. No. 254
B.H. No. 257
B.H. No. 262
B.H. No. 260
B.H. No. 261
B.H. No. 255
B.H. No. 267
B.H. No. 263
B.H. No. 264
B.H. No. 265
B.H. No. 268
B.H. No. 84
B.H. No. 256
B.H. No. 270
B.H. No. 199
B.H. No. 110
2