


2" X 30"

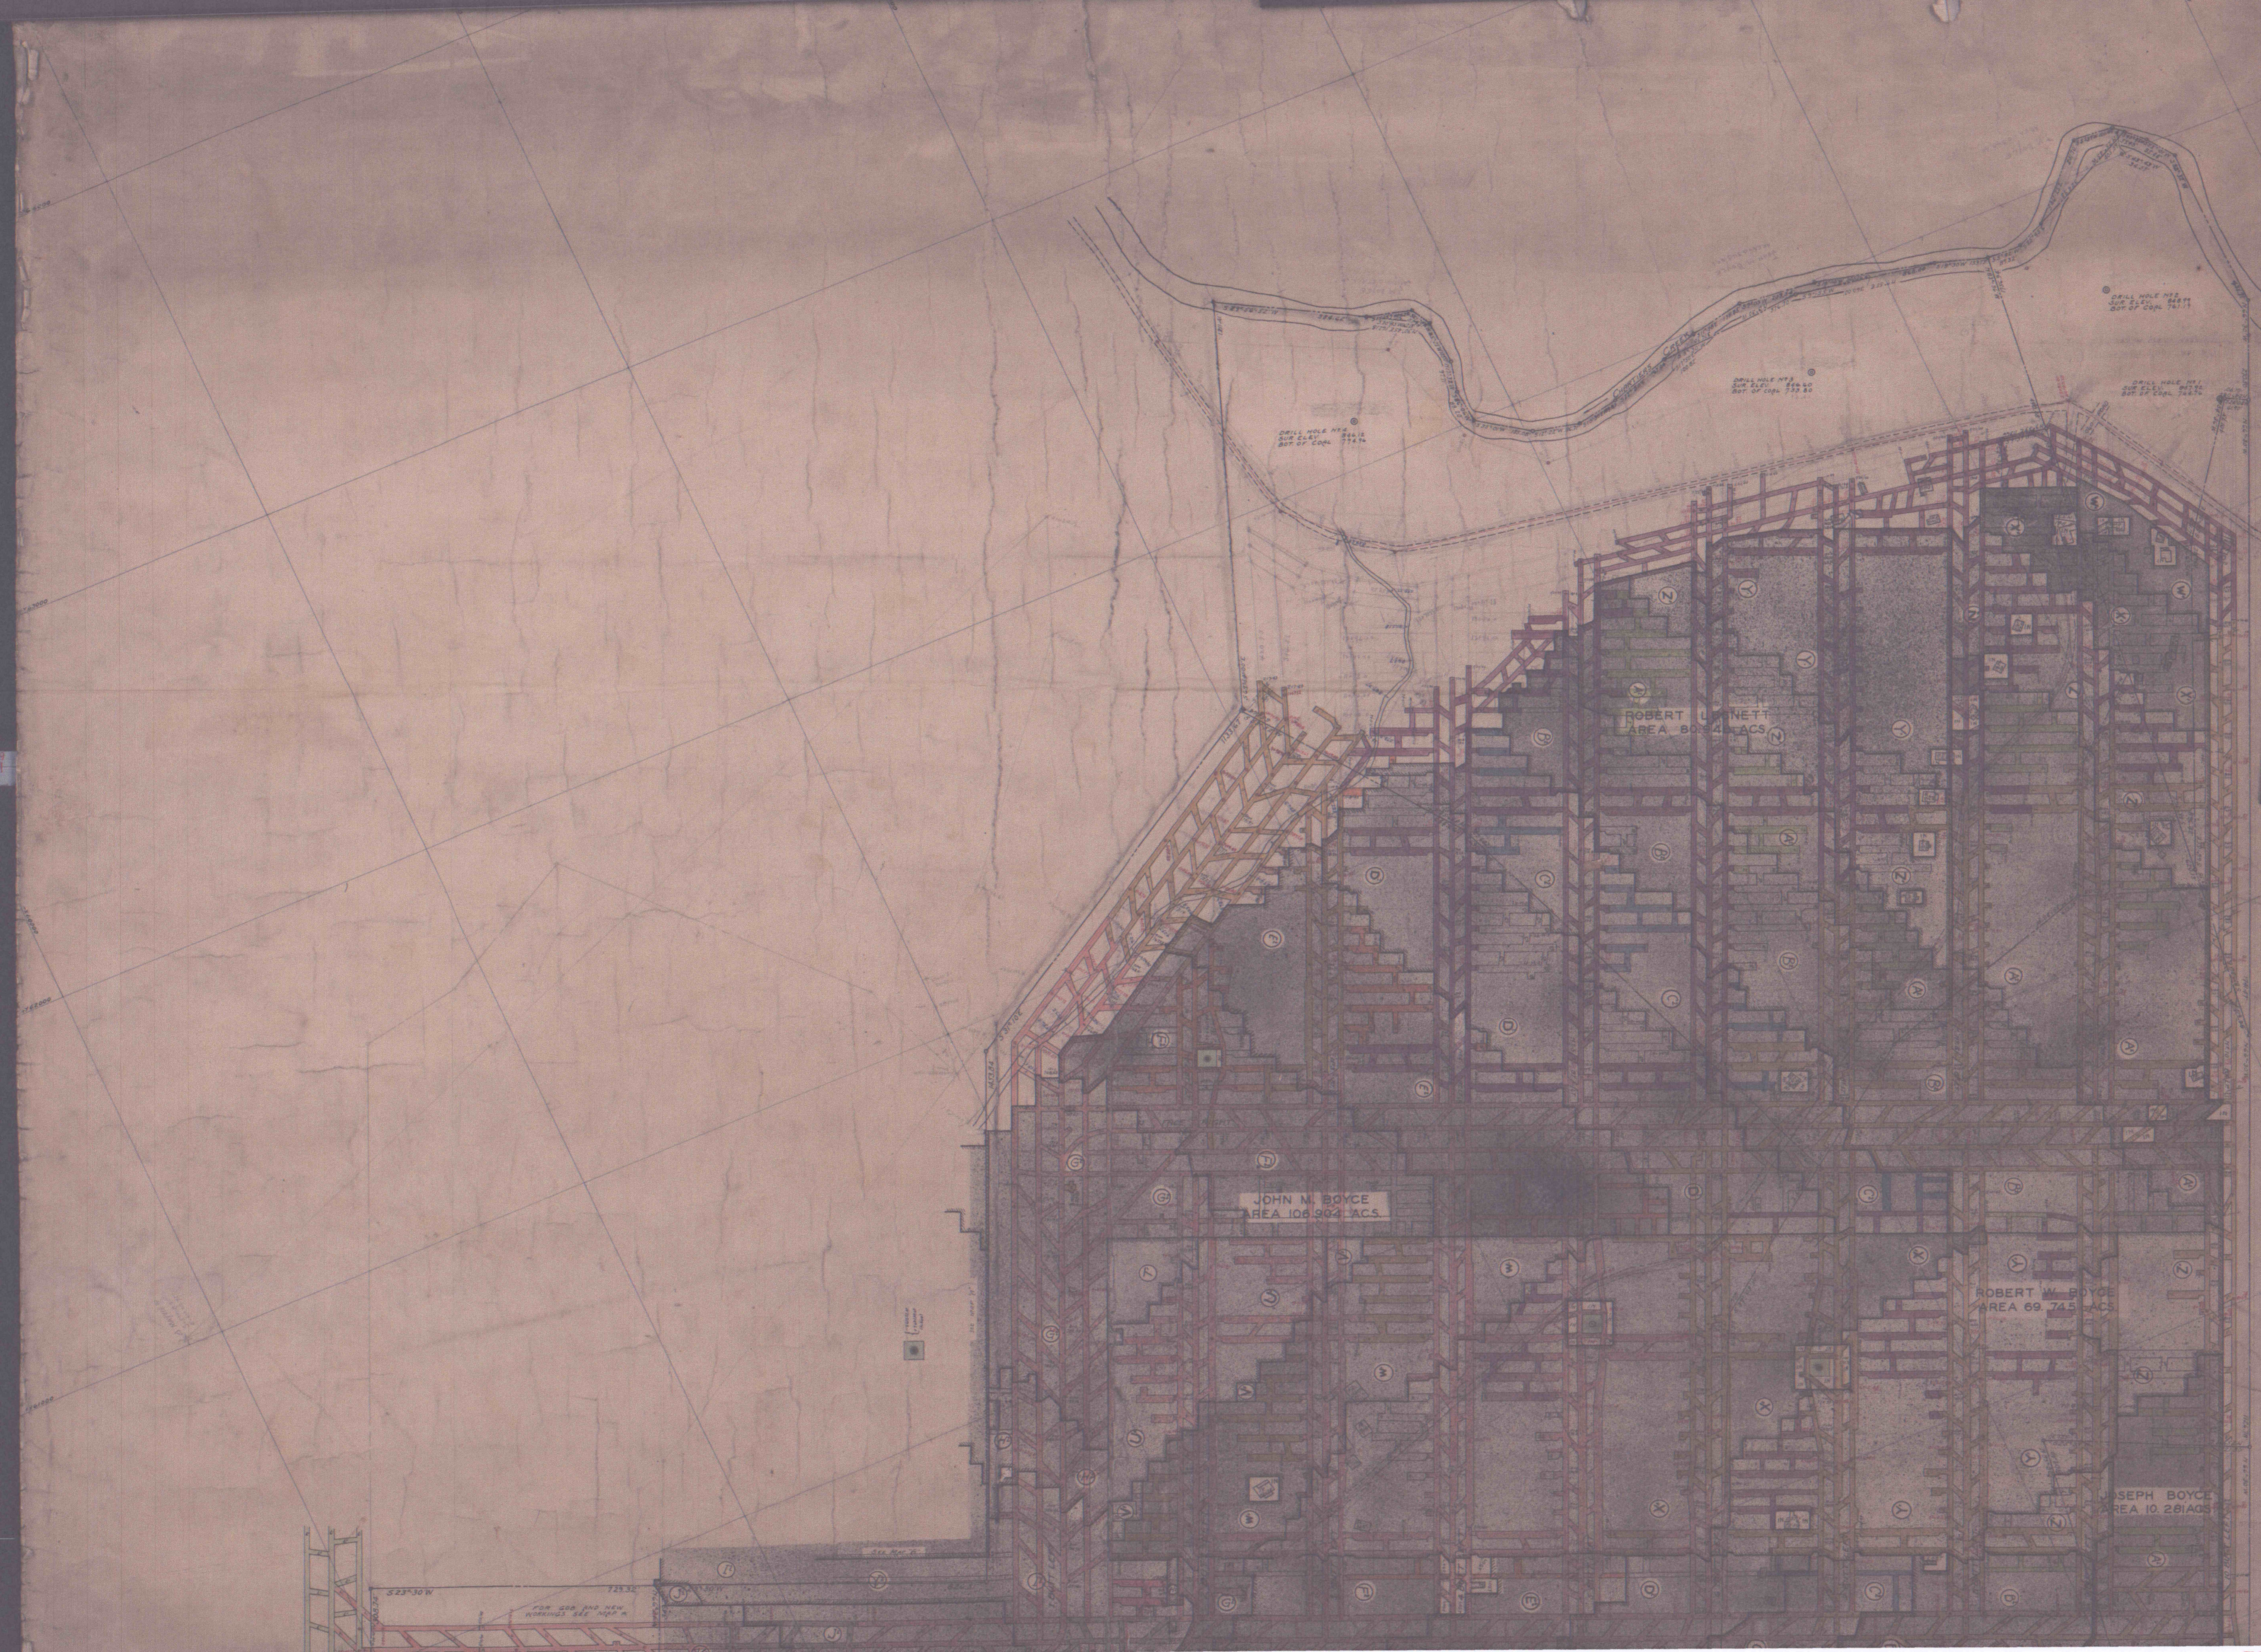

386913

11