


PIERCE MINE
AVERAGE SECTION OF COAL-

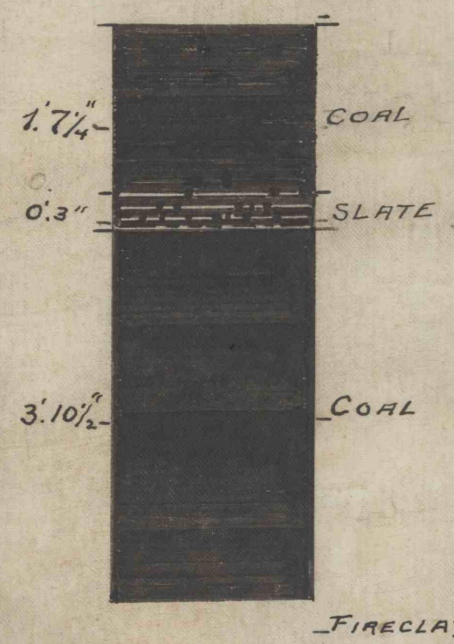

**OF THE
Portage Colliery**

SHOWING CONNECTION WITH, AND GANGWAY OF THE
Pierce Colliery
NEAR
Portage, Cambria Co. Pa.

SCALE-1 INCH=100 FEET
W. M. FRASER, Engr
ALTOONA, Pa.
FEBRUARY 1892
OCTOBER 1901

PORTAGE MINE
COAL AT "B.C."



MARCH 12 1892