

CLYDE DINGER

L. W. DINGER

PATRICK KENNEDY

GERALDINE CRAFT






RICHARD McDIVITT

RICHARD McDIVITT

PATRICK KENNEDY

PATRICK KENNEDY

WAYNE Mc GREGOR

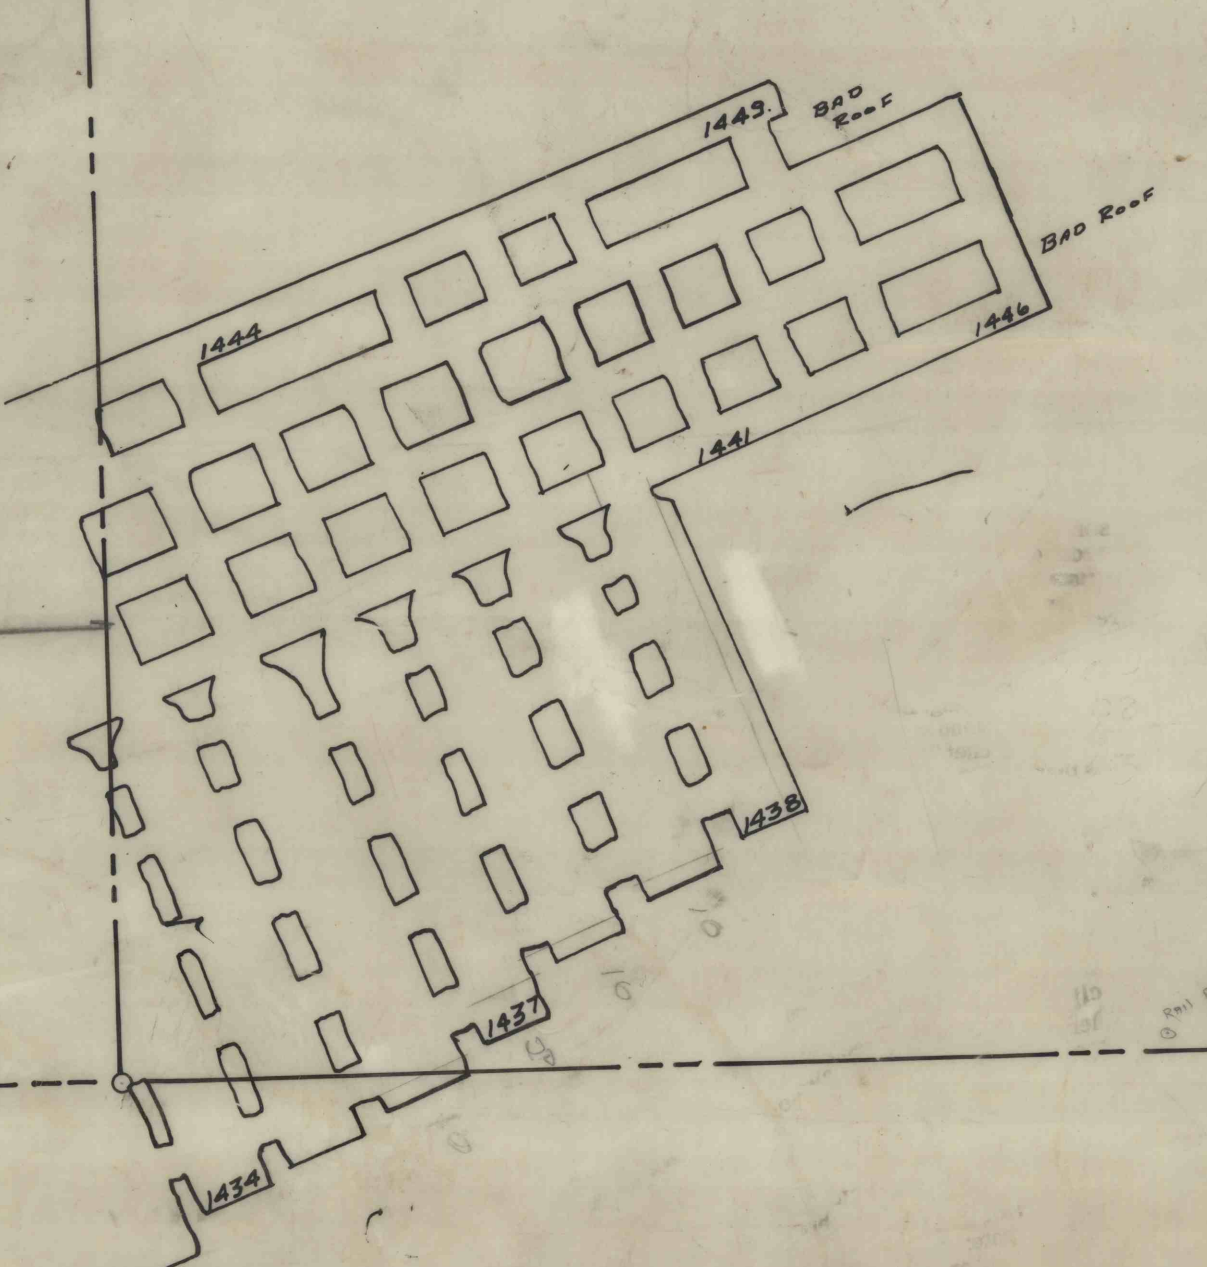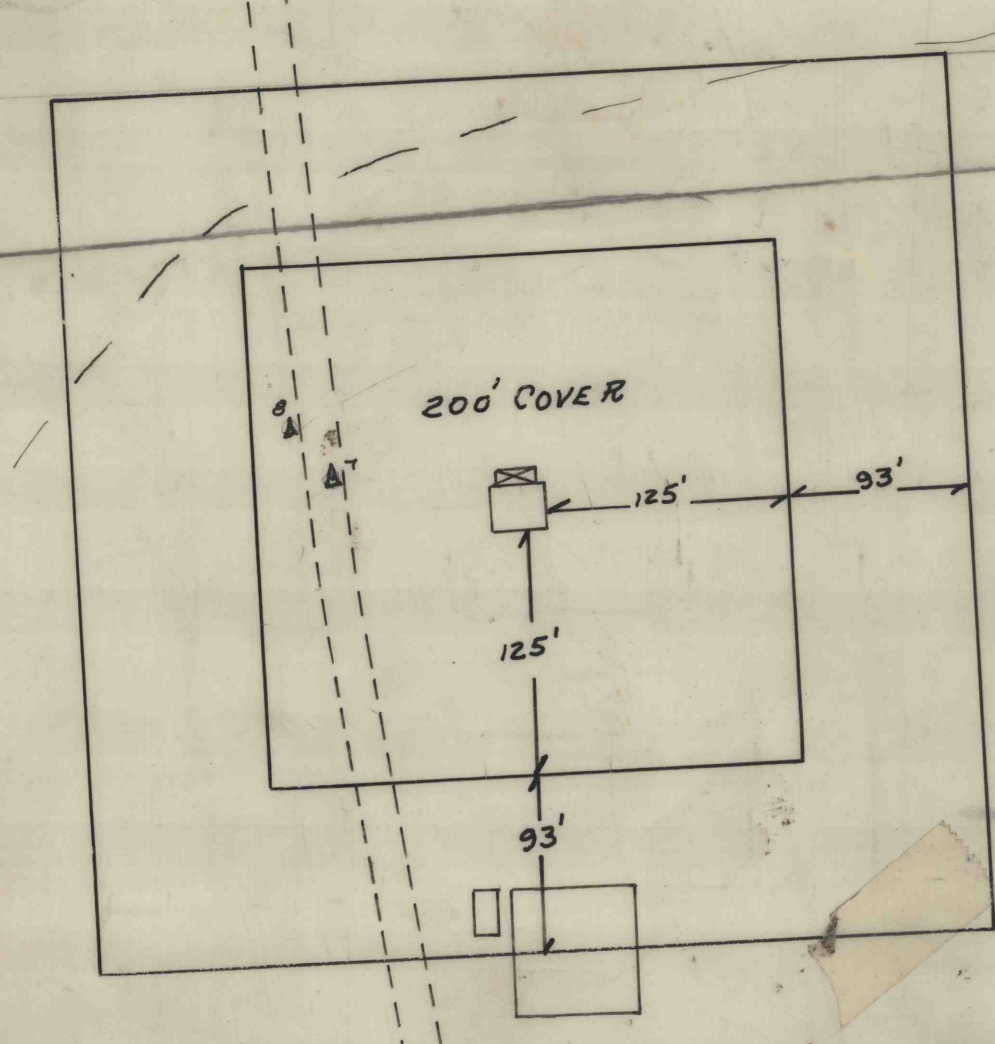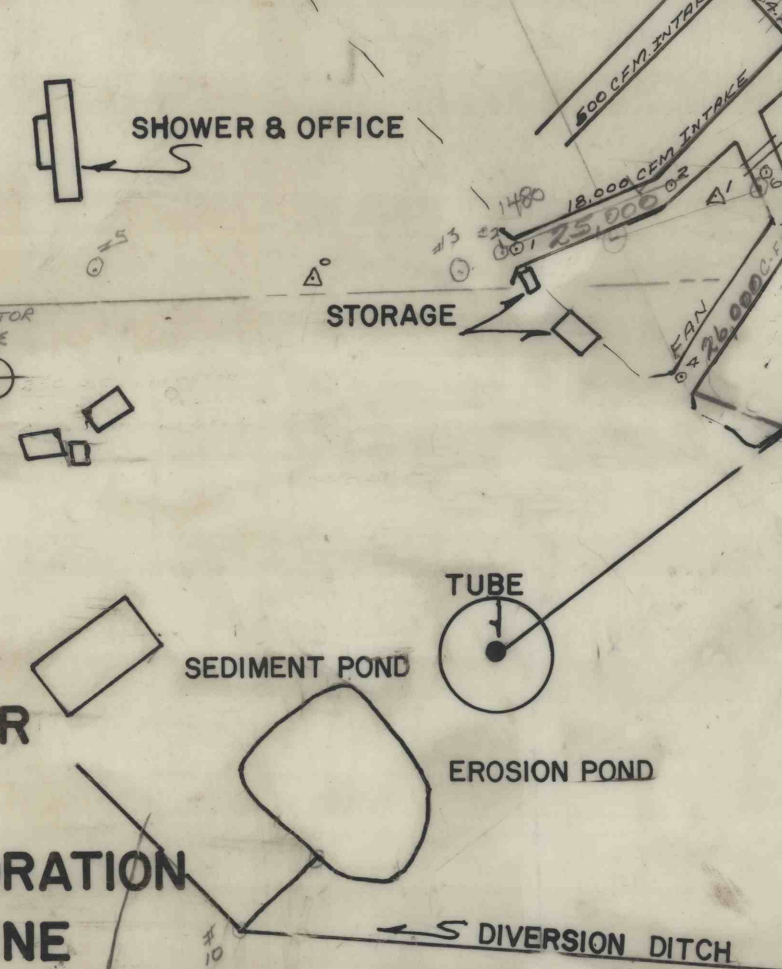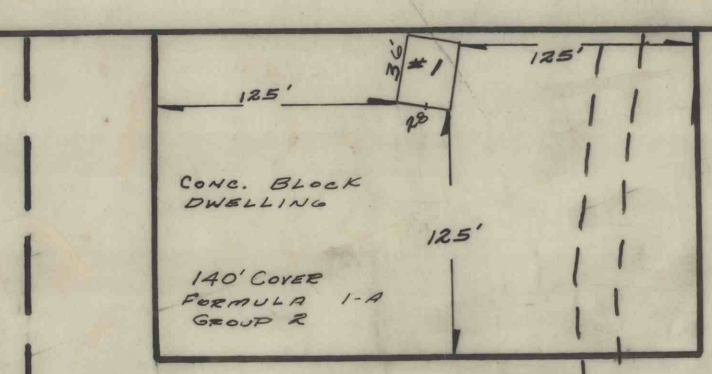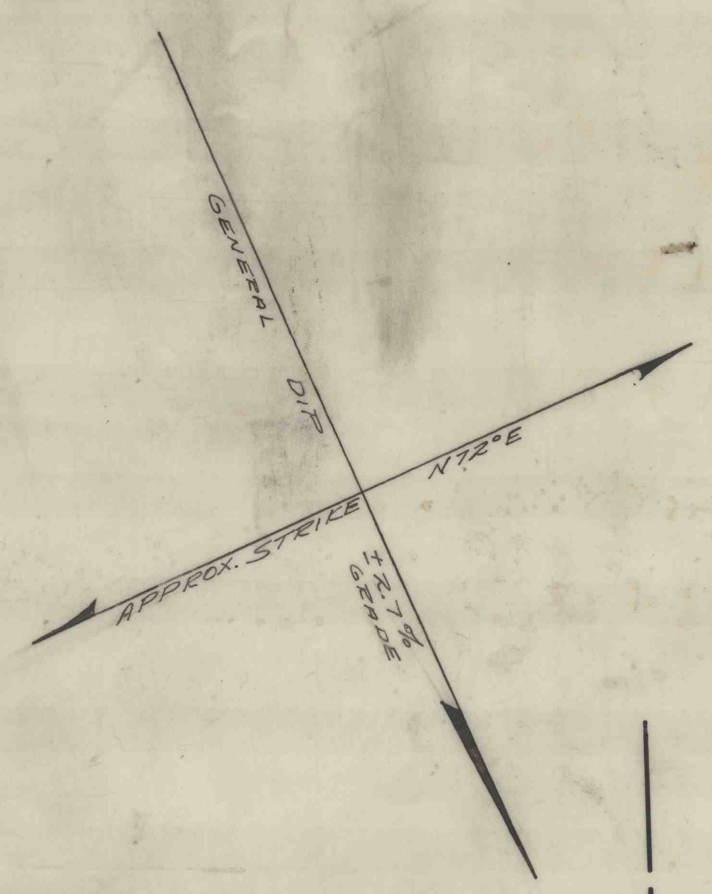

MINE MAP FOR
PLATEAU CORPORATION
FAIRVIEW #5 MINE
PORTER TOWNSHIP, JEFFERSON COUNTY
PENNSYLVANIA

1/20/1970 scale: 1"=100'

LEGEND

- CONTEMPLATED MINING 4-5-8 TO 10-5-8
- SUPPORT AREA
- PROTECTED STRUCTURES
- MINING COMPLETED
- LIMITS OF PERMIT & MINE