

CLYDE E. DINGER

L. W. DINGER

PATRICK KENNEDY



RICHARD Mc DIVITT

RICHARD McDIVITT

GERALDINE CRAFT

SURVEY RECORD  
 2-5-57  
 10-19-60  
 11-9-62  
 8-12-65  
 11-12-66  
 1-16-68

LEGEND  
 AREA TO BE MINED TO 7-1-70  
 MINING COMPLETED  
 ENTRIES

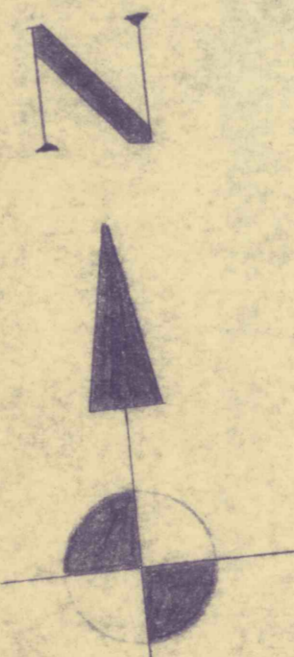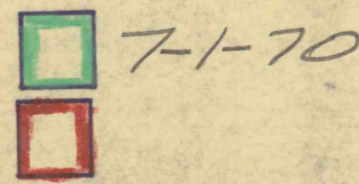

MINE MAP FOR  
 FAIRVIEW COAL COMPANY  
 1"=100' 11-12-66  
 PORTER TWP, JEFFERSON CO.  
 PENNSYLVANIA

