

L. W. DINGER

CLYDE E. DINGER

RICHARD McDIVITT

RICHARD Mc DIVITT

PATRICK KENNEDY

GERALDINE CRAFT


FAULT
7-23-63
20°E

I-308
17-33002

I-308

SURVEY RECORD
7-3-57
10-19-60
11-3-62
8-12-65
11-12-66
1-16-68

LEGEND
AREA TO BE MINED TO
MINING COMPLETED
ENTRIES

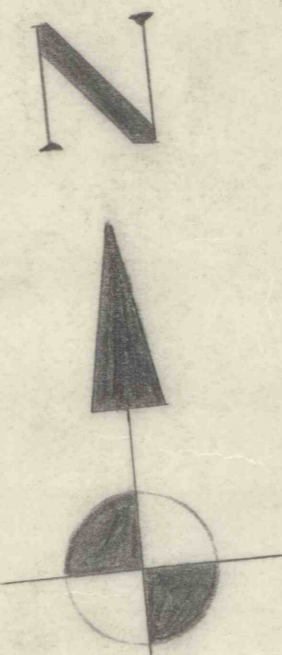

MINE MAP FOR
FAIRVIEW COAL COMPANY
1:100
PORTER TWP., JEFFERSON CO.
PENNSYLVANIA
11-12-66

