


Sheet No. 10

NATIONAL MINES CORPORATION ISABELLA MINE

LUZERNE TWP. FAYETTE CO., PA.
SCALE 1" = 100' SURVEY DATE 10-1-24

RENG. NO. PAPE028902

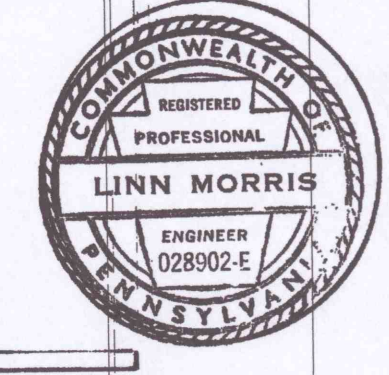

LEGEND

- CONTEMPLATED MINING
- PERMIT BOUNDARY
- PROTECTED STRUCTURES
- OTHER STRUCTURES
- MINING COMPLETED AREA
- SUPPORT AREA
- PILLARS TO BE LEFT IN PLACE

RECEIVED
DEPARTMENT OF REVENUE
HARRISBURG, PA.
JAN 10 1925
13

D.D. #42
SURFACE 770.86
BOTTOM COAL 631.69
DEPTH 139.17

D.D. HOLE #43
SURFACE 775.81
BOTTOM COAL 638.73
DEPTH 137.08

MONONGAHELA RIVER