


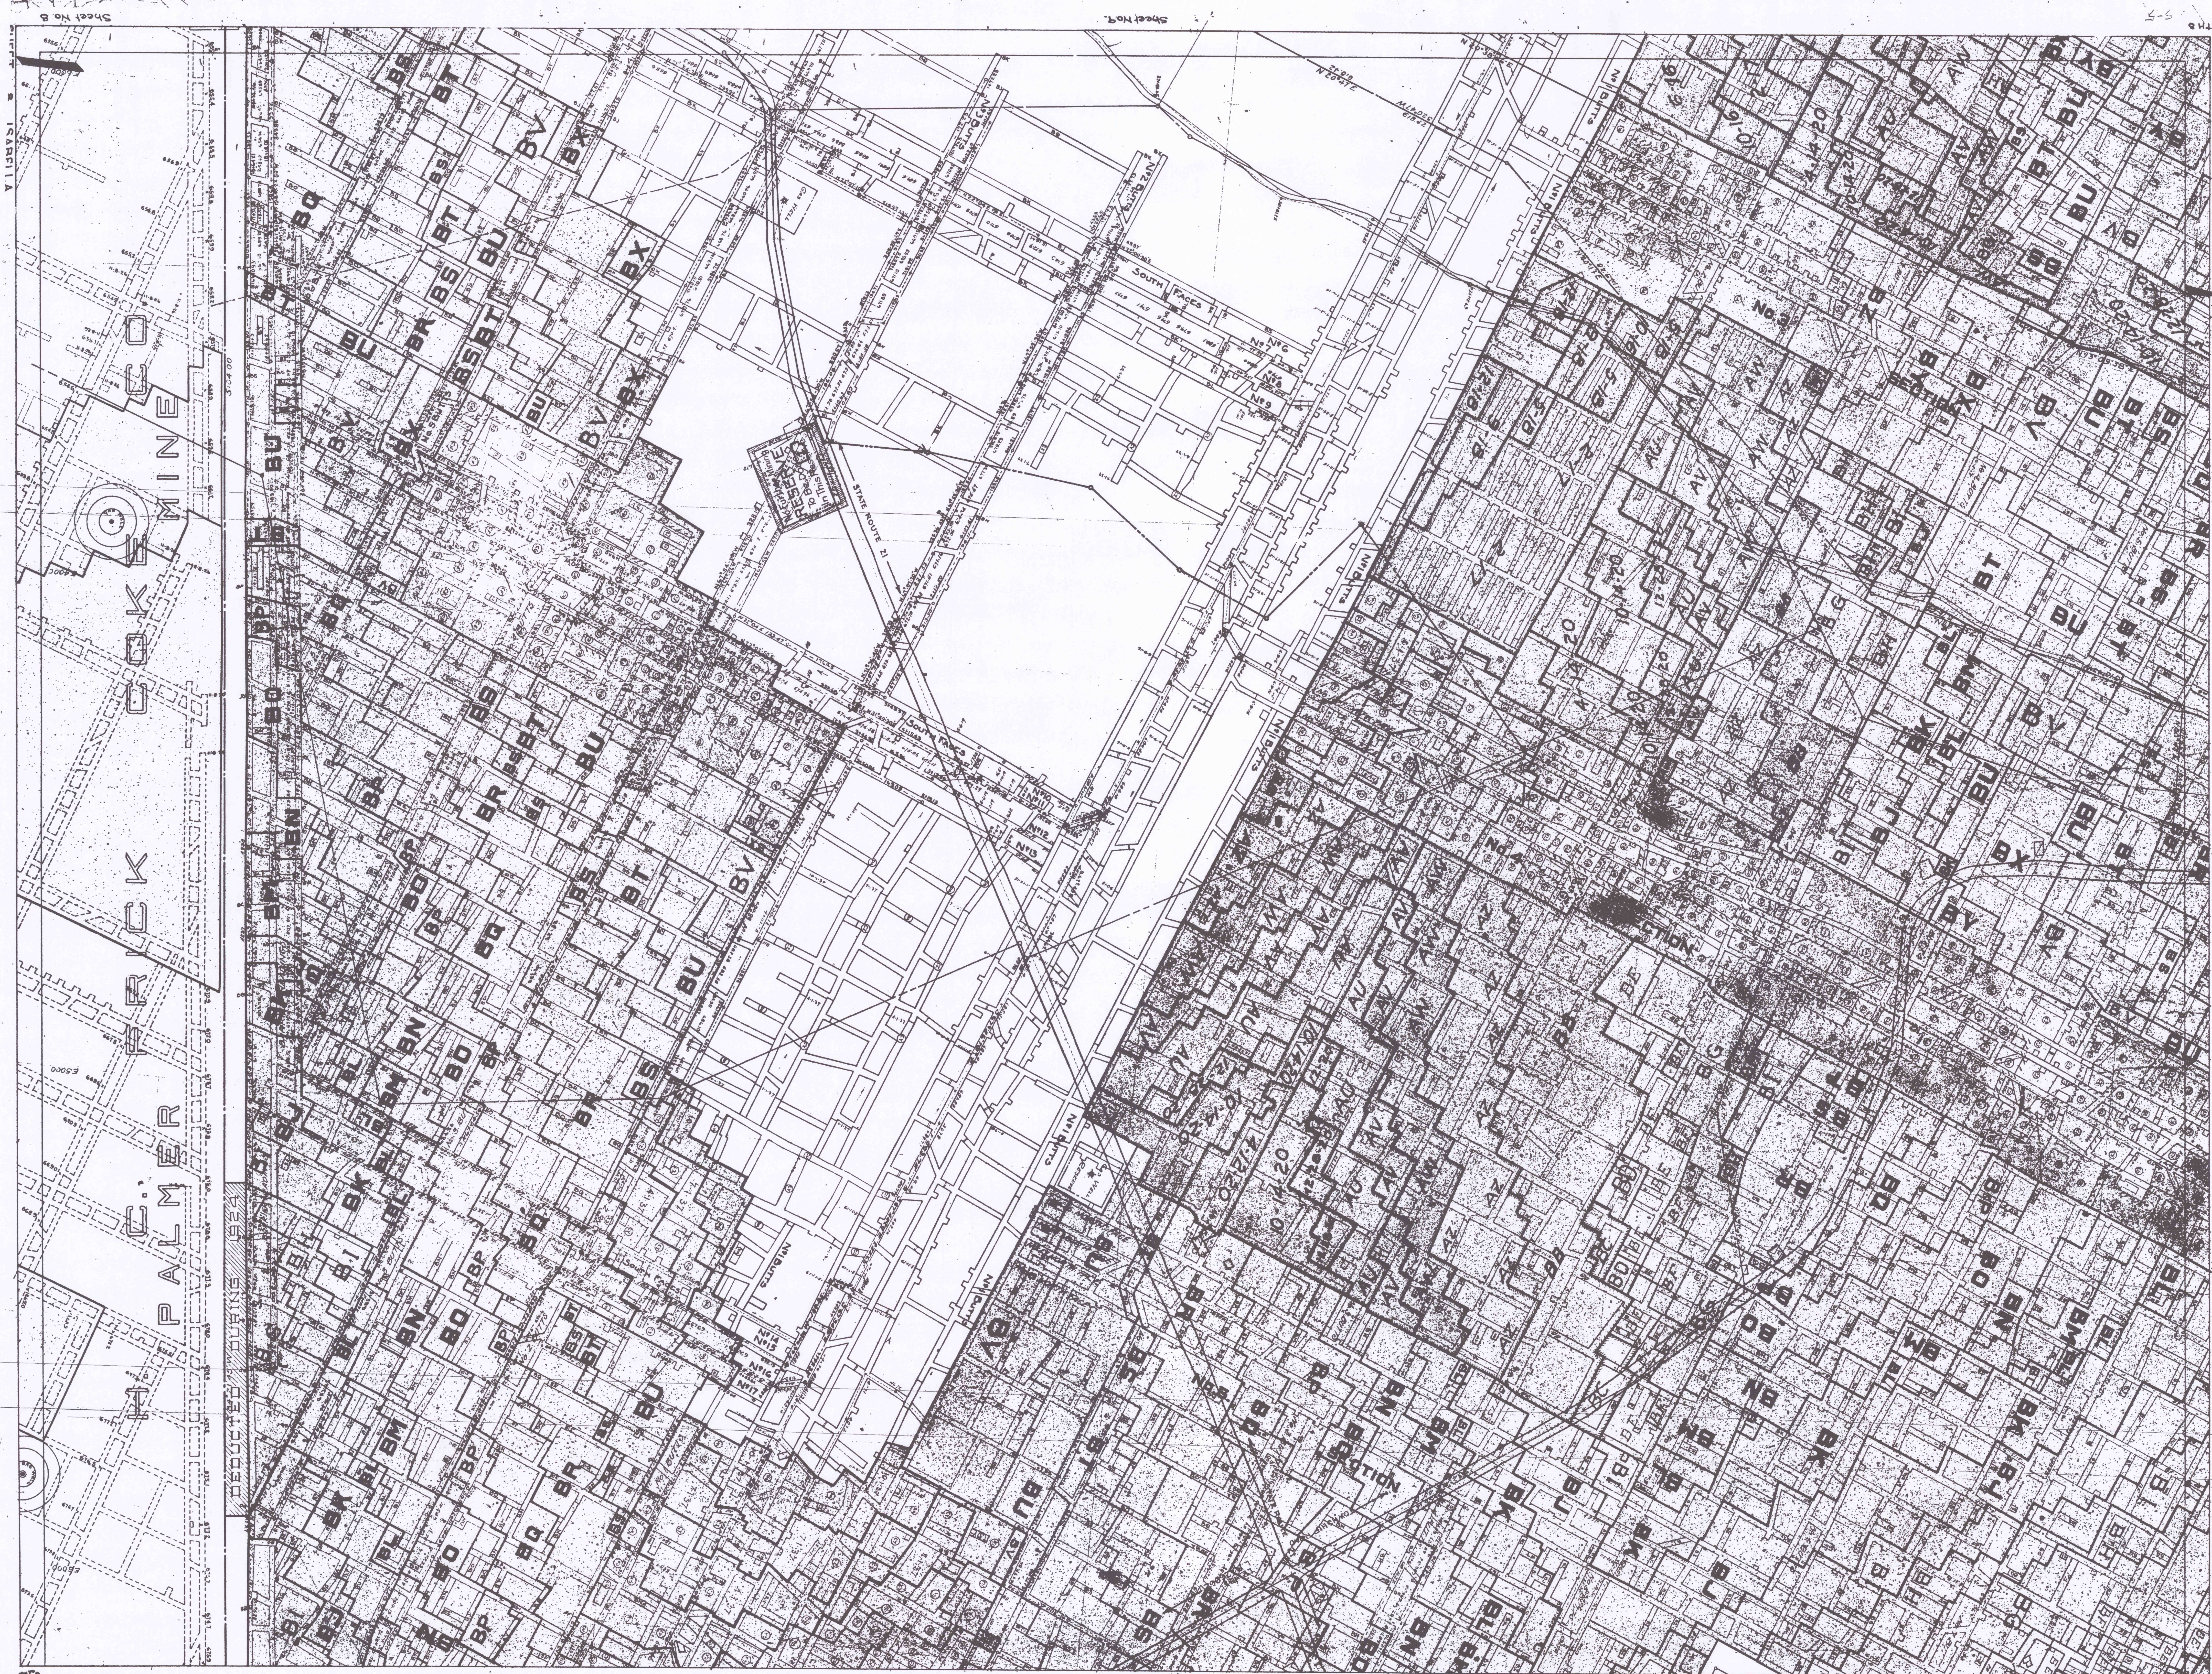

Sheet No. 5

Sheet No. 6

Sheet No. 7

Sheet No. 5

Sheet No. 6

SHEET 5 ISABELLA

MICROFILMED