


WALTERS
JERRY

INDEX TO SURVEYS	
DATE	SURVEYED BY
11-15-26	A FETTERMAN-ENGR CO.
4-25-27	B " "
12-23-27	C " "
1-30-29	D " "
9-24-29	E " "
8-11-30	F " "
4-20-31	G " "
10-28-33	H L.H. ALTEMUS.
6-8-35	I " "
8-22-36	J " "
4-3-37	K " "
1-29-38	L " "
12-10-38	M " "
7-29-39	N " "
7-8-40	O R.C.Z. & M.F.B.
5-23-42	P " "

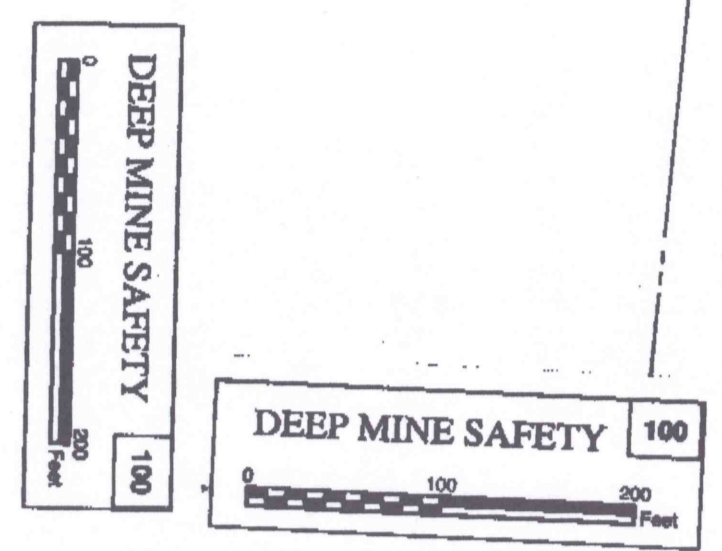

MORLEY & DAVIS COAL CO.
 MINING OPERATIONS
 "E" SEAM
 STONYCREEK TWP CAMBRIA CO. PA.
 SCALE 1"=100' OCT. 30TH. 1933.
 L.H. ALTEMUS, R.S. N° 3974.