


A-4-13

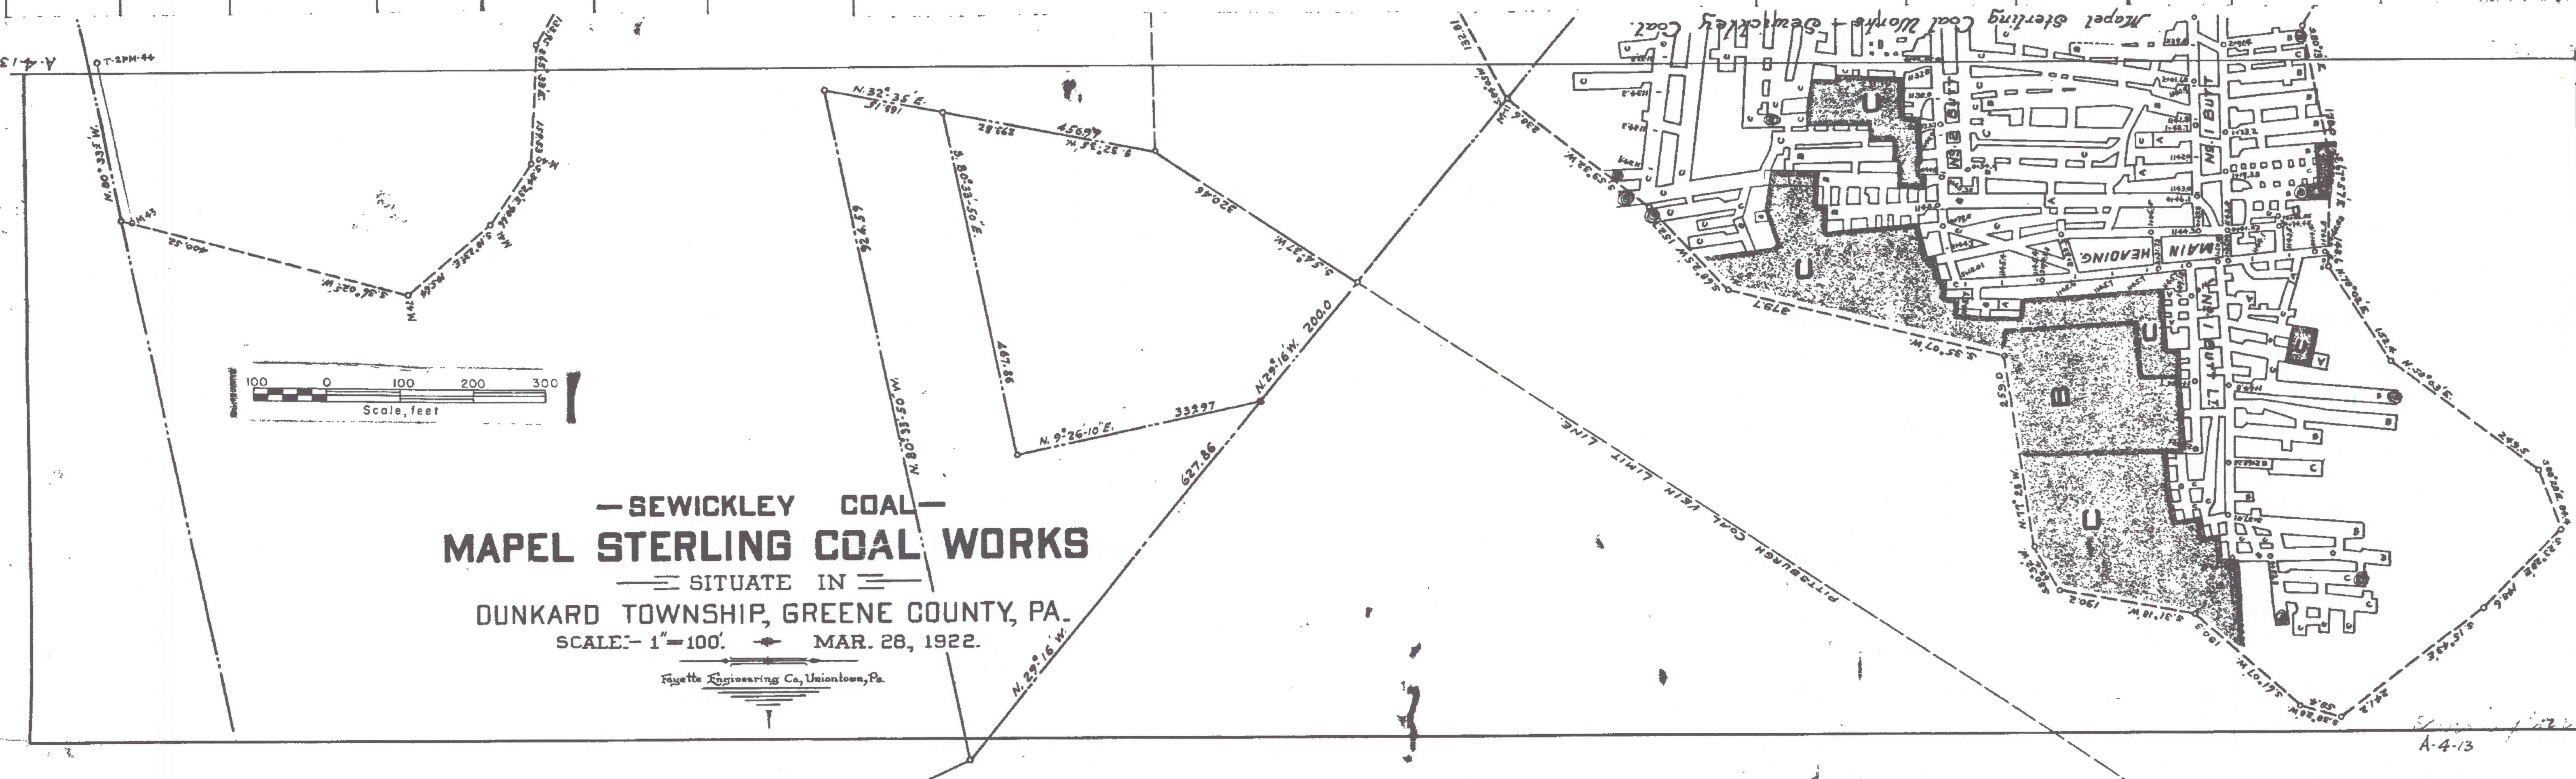

— SEWICKLEY COAL —
MAPEL STERLING COAL WORKS

— SITUATE IN —
 DUNKARD TOWNSHIP, GREENE COUNTY, PA.
 SCALE: 1" = 100'. MAR. 28, 1922.

Fayette Engineering Co., Uniontown, Pa.

A-4-13

FEC 03117 24 23X 343814