


MINE & PROPERTY
 OF
 SOMERSET & CAMBRIA SMOKELESS COAL MINING CO.
 SITUATED IN
 SOMERSET CO. PA.
 SCALE 1"=100'

SOMERSET TWR

Decem.

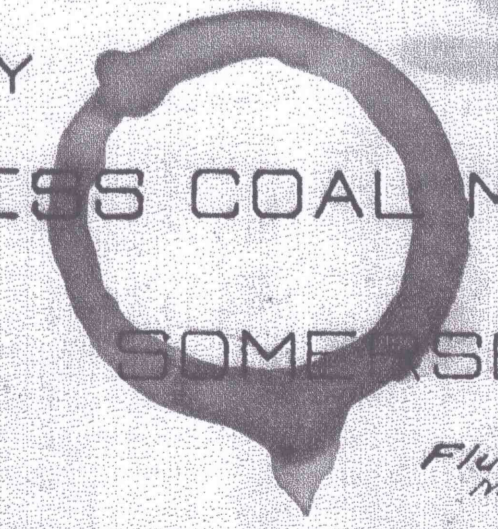

*Fluck & Magie
 Mining & Civil Engrs
 Somerset Pa.*