


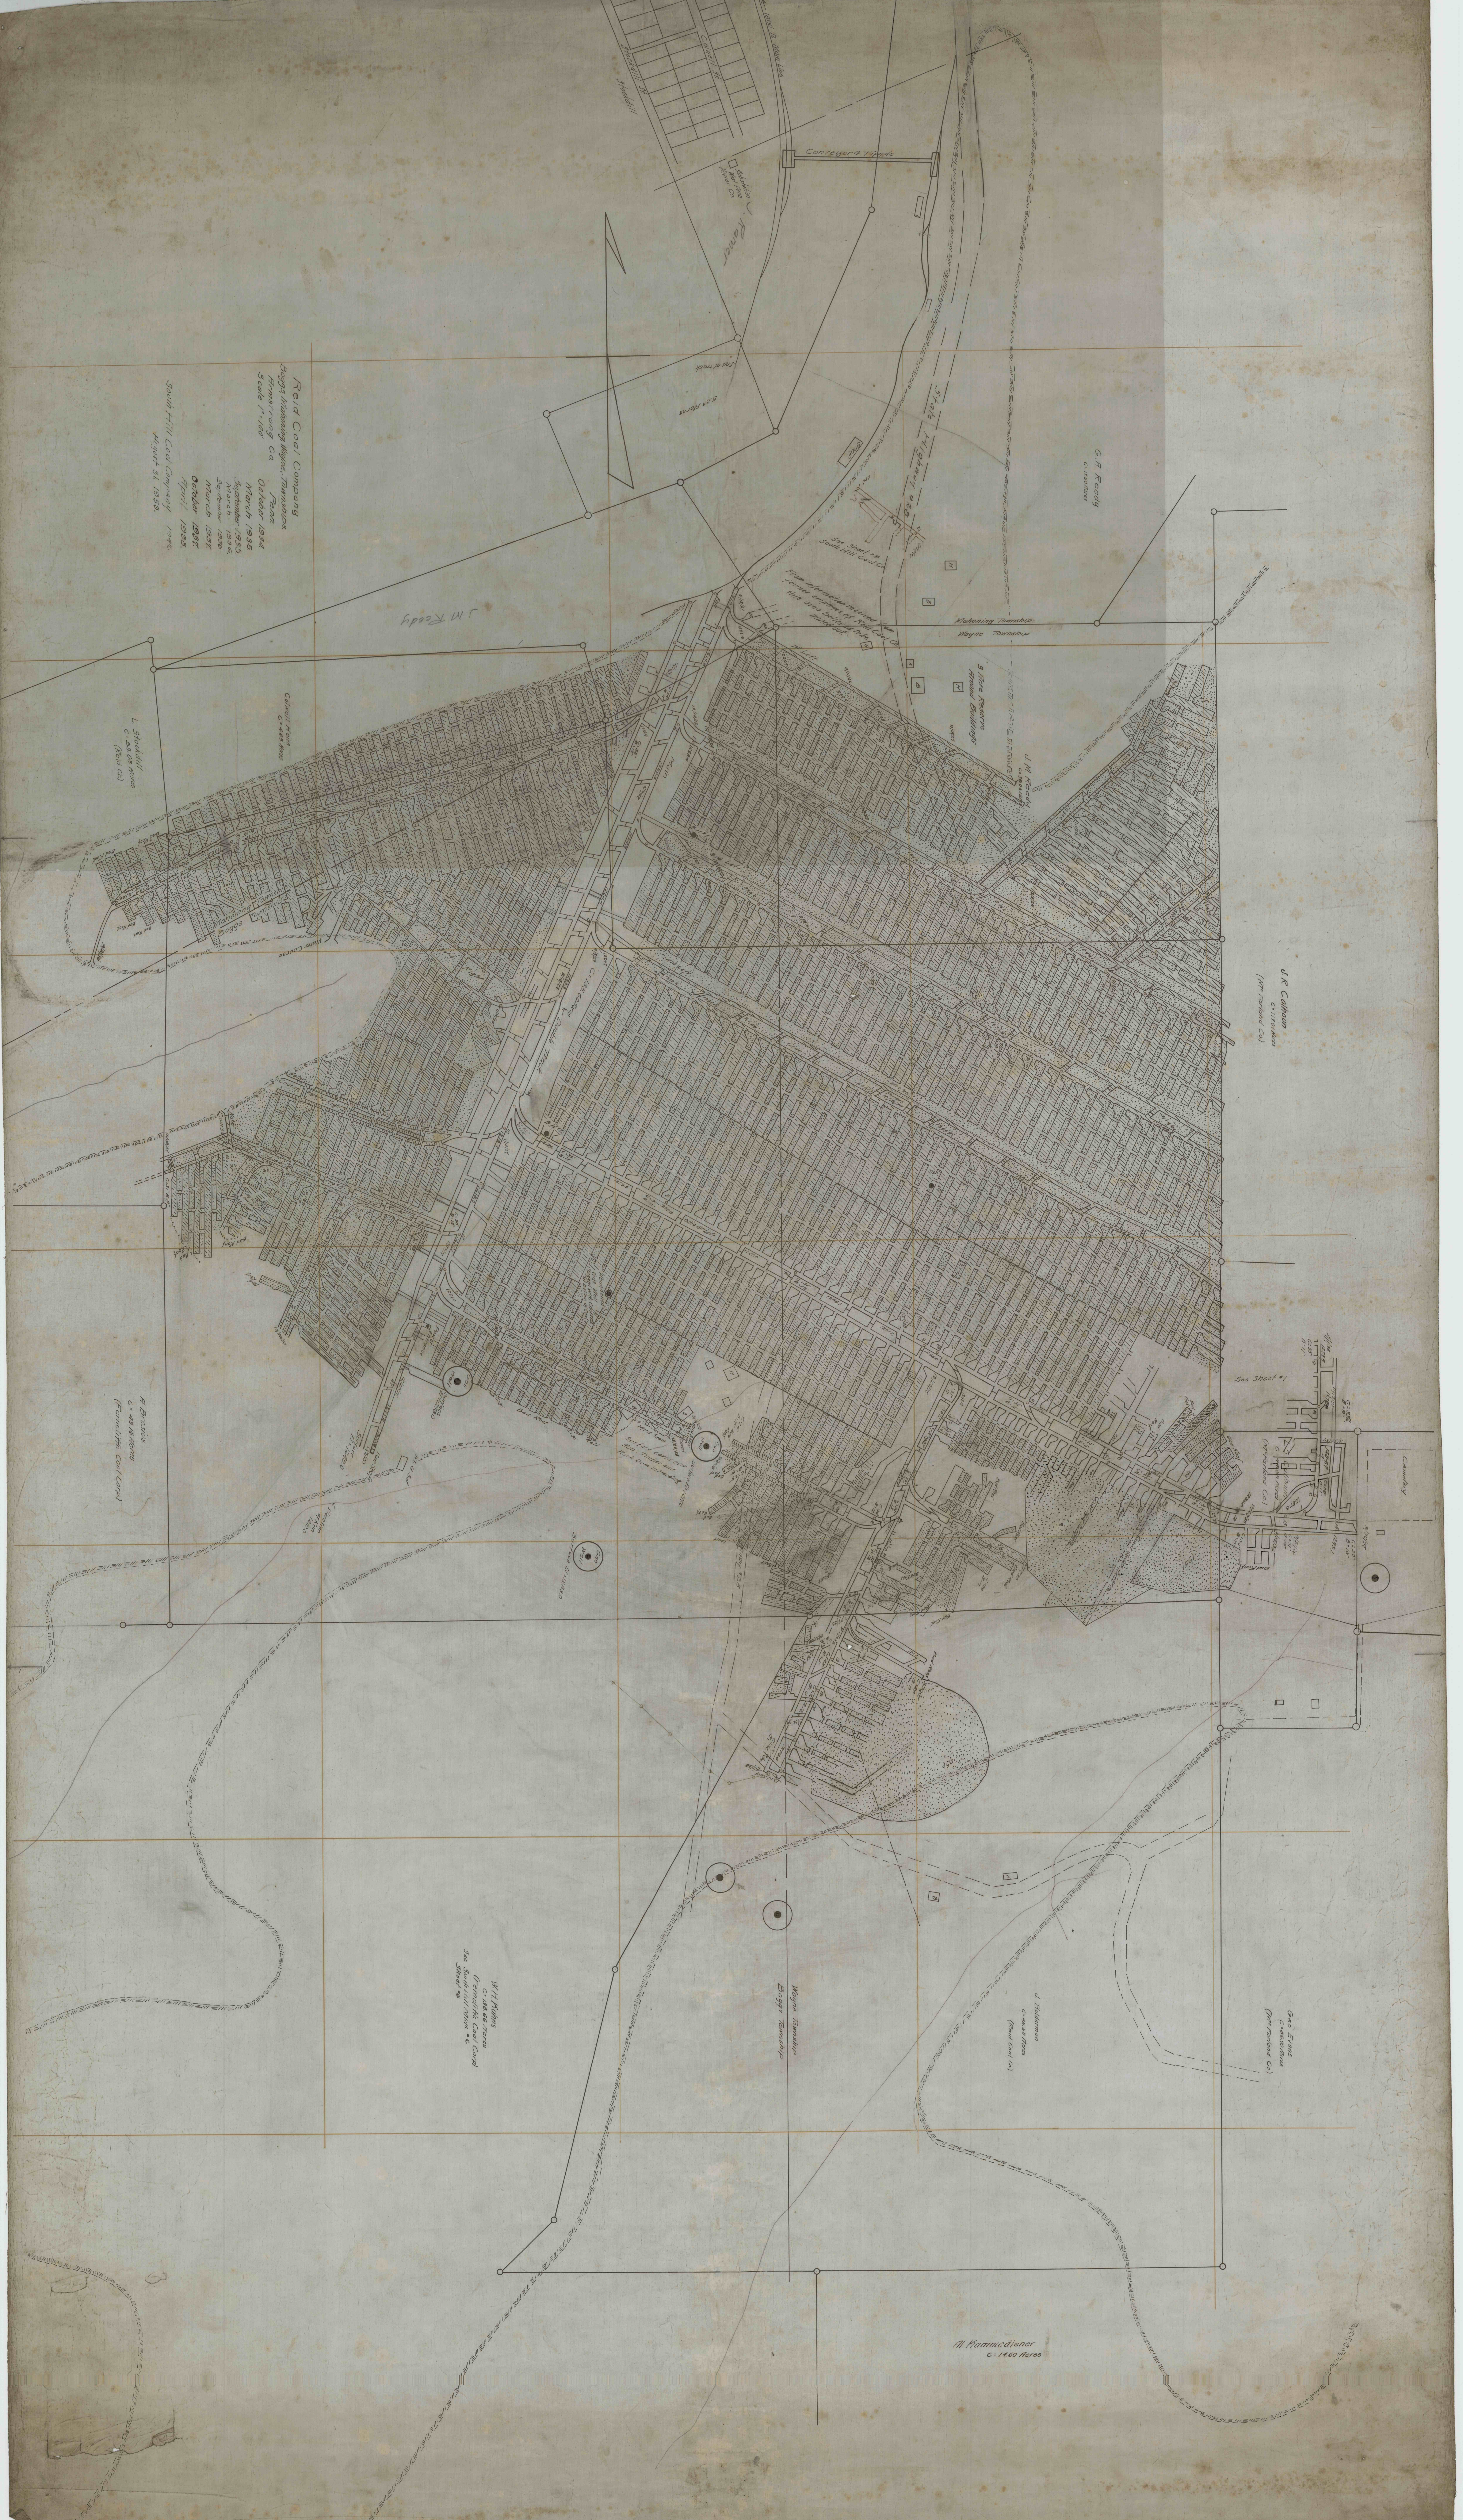

Reid Coal Company
March 1934
October 1934
September 1935
March 1936
September 1936
March 1937
October 1937
April 1938
South Hill Coal Company 1946

U. R. Coffey
Crittenden
(see section 1)

Geo. J. Jones
Crittenden
(see section 1)

Al. Homardier
C. 1460 acres











