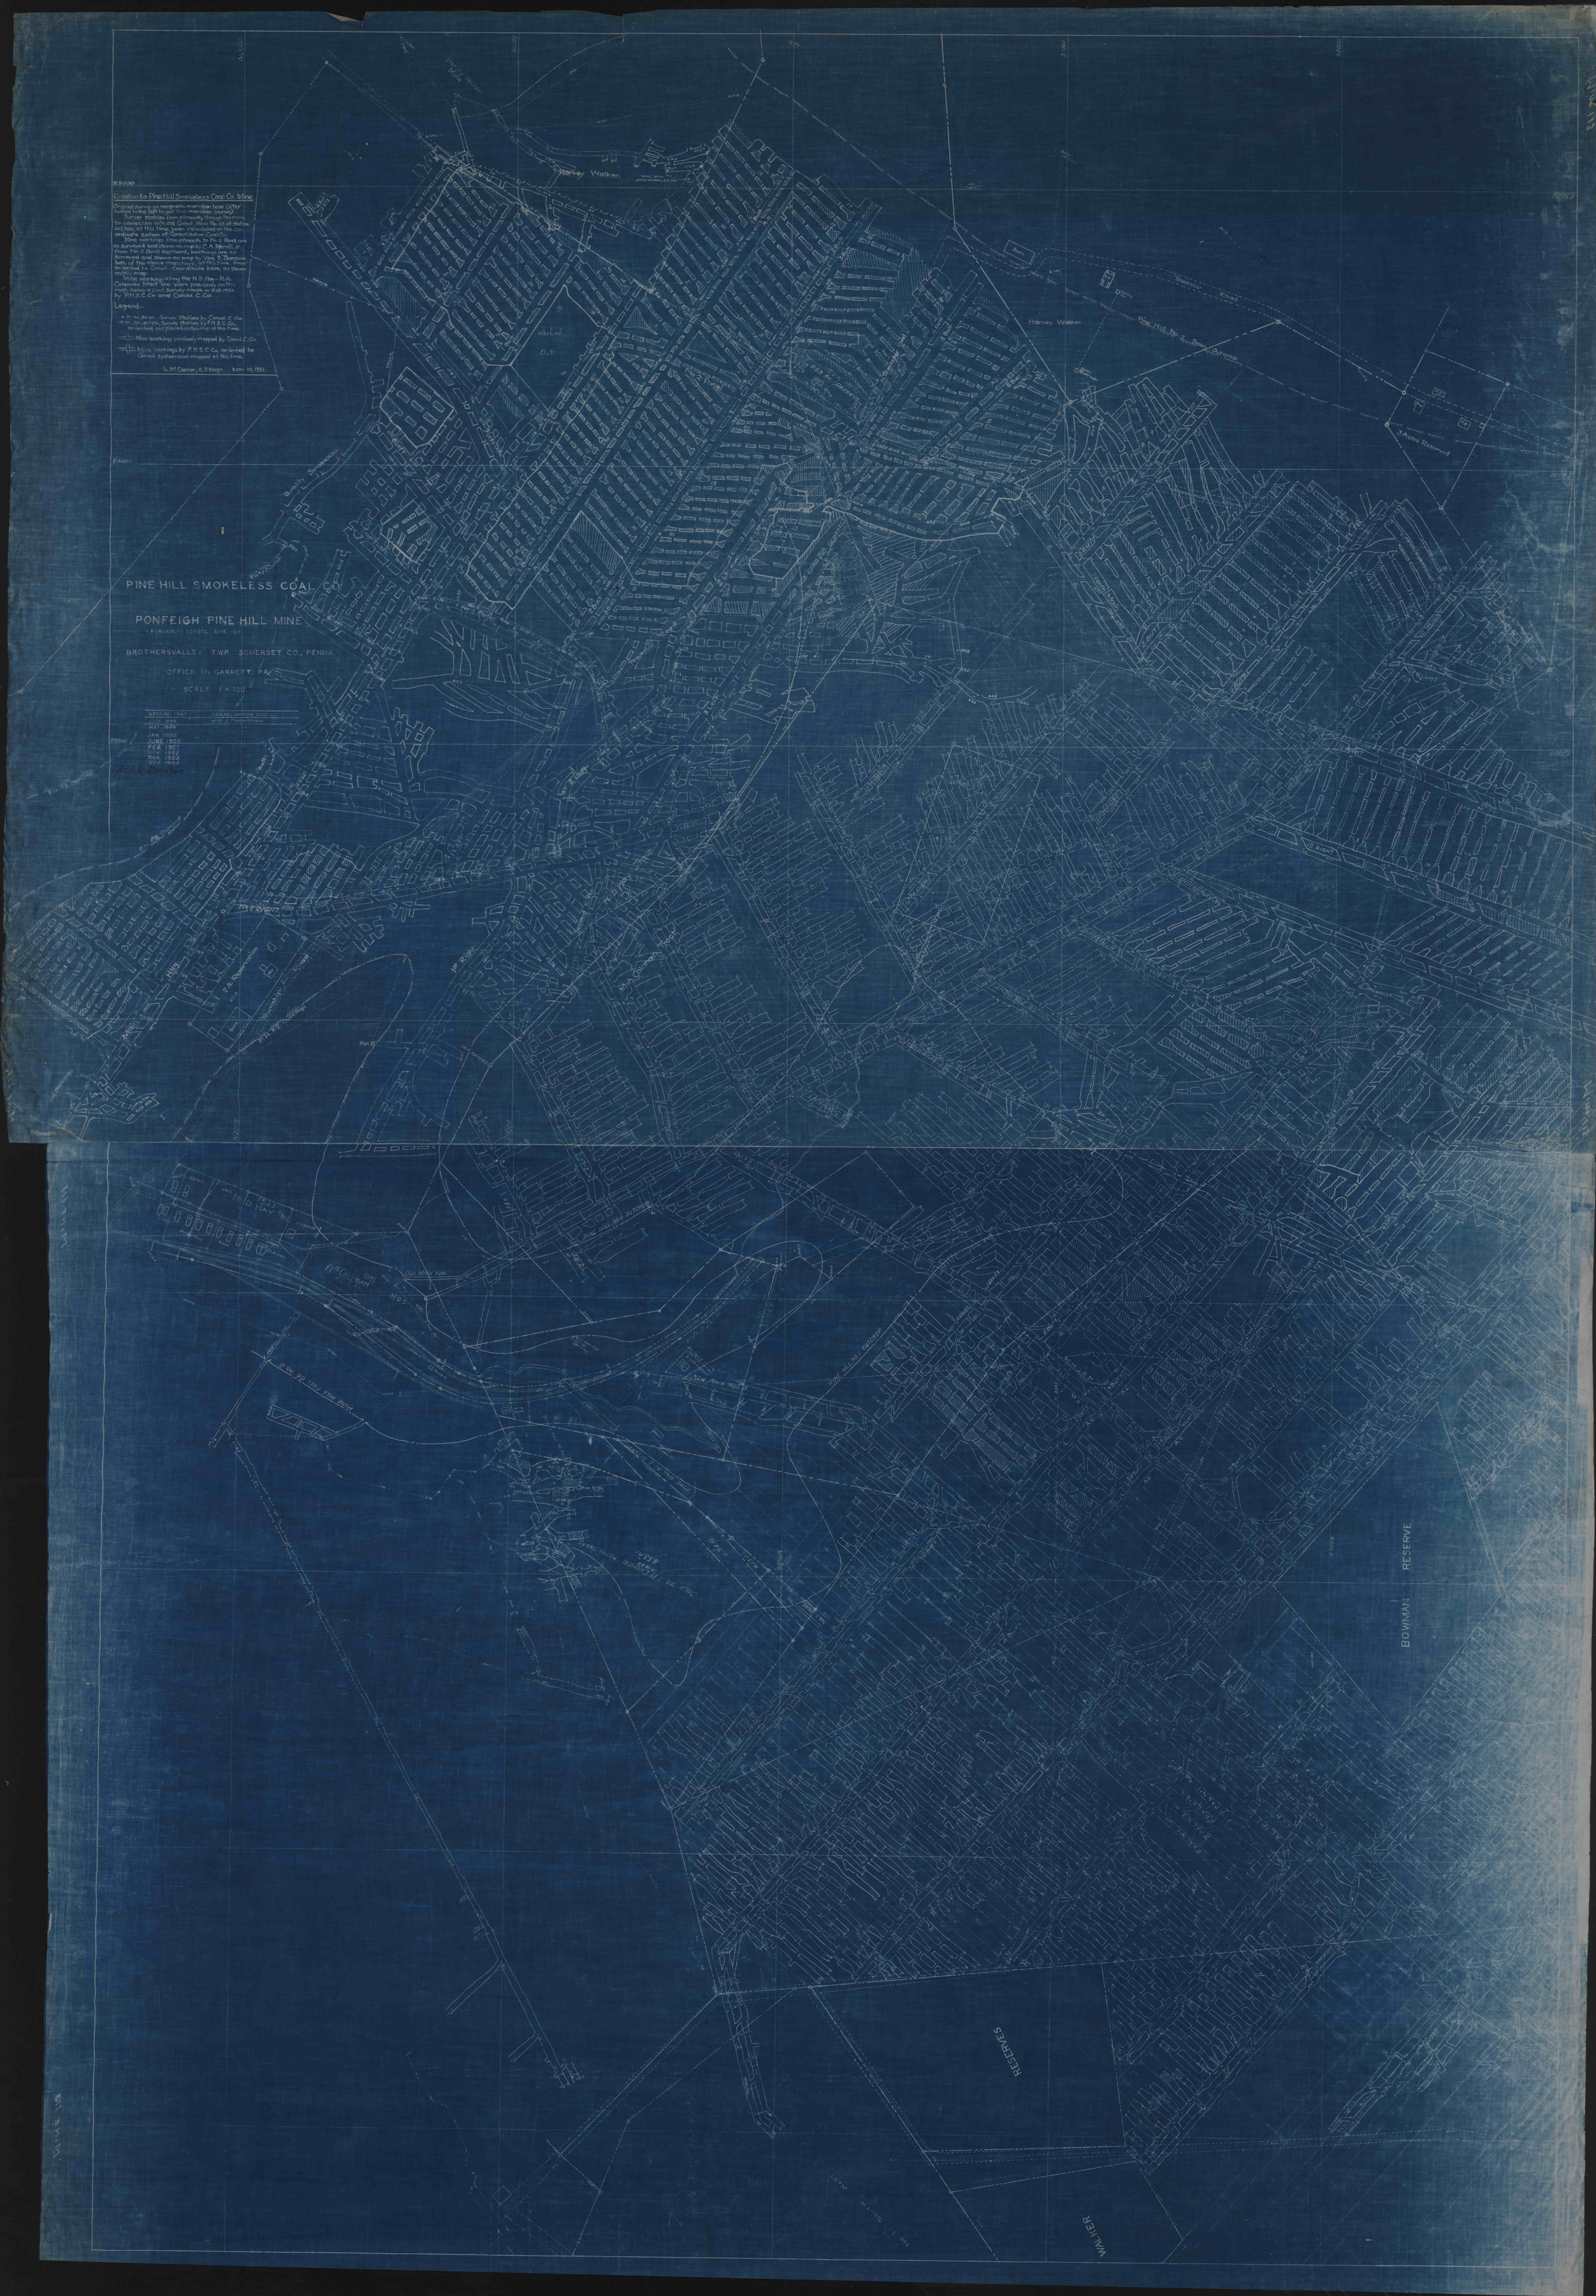
Relative to Pine Hill Smokeless Coal Co. Mine
Original Survey on magnetic meridian base (6°30' turned to the left to get True meridian courses).
Survey stations from Pitmouth, through the mine, to connection with old Consol. Mine No. 83 at station 467, has, at this time, been calculated on the co-ordinate system of Consolidation Coal Co.
Mine workings from pitmouth, to No. 2 Rock are as surveyed and shown on map by C. A. Merrill, Jr. From No. 2 Rock eastward, workings are as surveyed and shown on map by Wm. S. Thompson, both of the above maps have, at this time, been oriented to Consol. Co-ordinate base, as shown on this map.
Mine workings along the N. D. Hay—M.A. Coleman tract line, were previously on this map, being a joint survey made in 1928-1933, by P.H.S.C.Co and Consol. C.Co.
Legend:-
7, 12, 80 etc., Survey Stations by Consol. C. Co.
101, 36, 467etc, Survey Stations by P.H.S.C.Co, oriented and placed on this map at this time.
Mine Workings previously mapped by Consol. C.Co.
Mine Workings by P.H.S.C.Co. oriented to Consol. System and mapped at this time.
L. M. Carter, R.P.Engr. , Nov. 10, 1951.
PINE HILL SMOKELESS COAL CO.
PONFEIGH PINE HILL MINE
(FORMERLY CONSOL. MINE 83)
BROTHERSVALLEY TWP. SOMERSET CO., PENNA.
OFFICE IN GARRETT, PA.
SCALE 1" = 100'
BEFORE 1947 CONSOLIDATION COAL CO.
JUNE 1948 WM. S. THOMPSON
MAY 1949
JAN. 1950
JUNE 1950
FEB. 1951
NOV. 1952
DEC. 1953
NOV. 1954
Updated Dec. 1960
Harvey Walker
Worked Out
Pine Hill No. 2 Rock Outcrop
Township Road
3 Acres Reserved
Quality Smokeless
Pitmouth
Old Workings
Fan
Mr. Right
Mr. Coleman Tract
2A Reservation
Township Road
Old Main Line
Pine Hill No. 1 Outcrop
New Main Line
Pine Hill Coal Co. No. 2
Pine Hill No. 2 Outcrop
ORIGIN
BOWMAN RESERVE
RESERVES
WALTER
No. 1 South West