


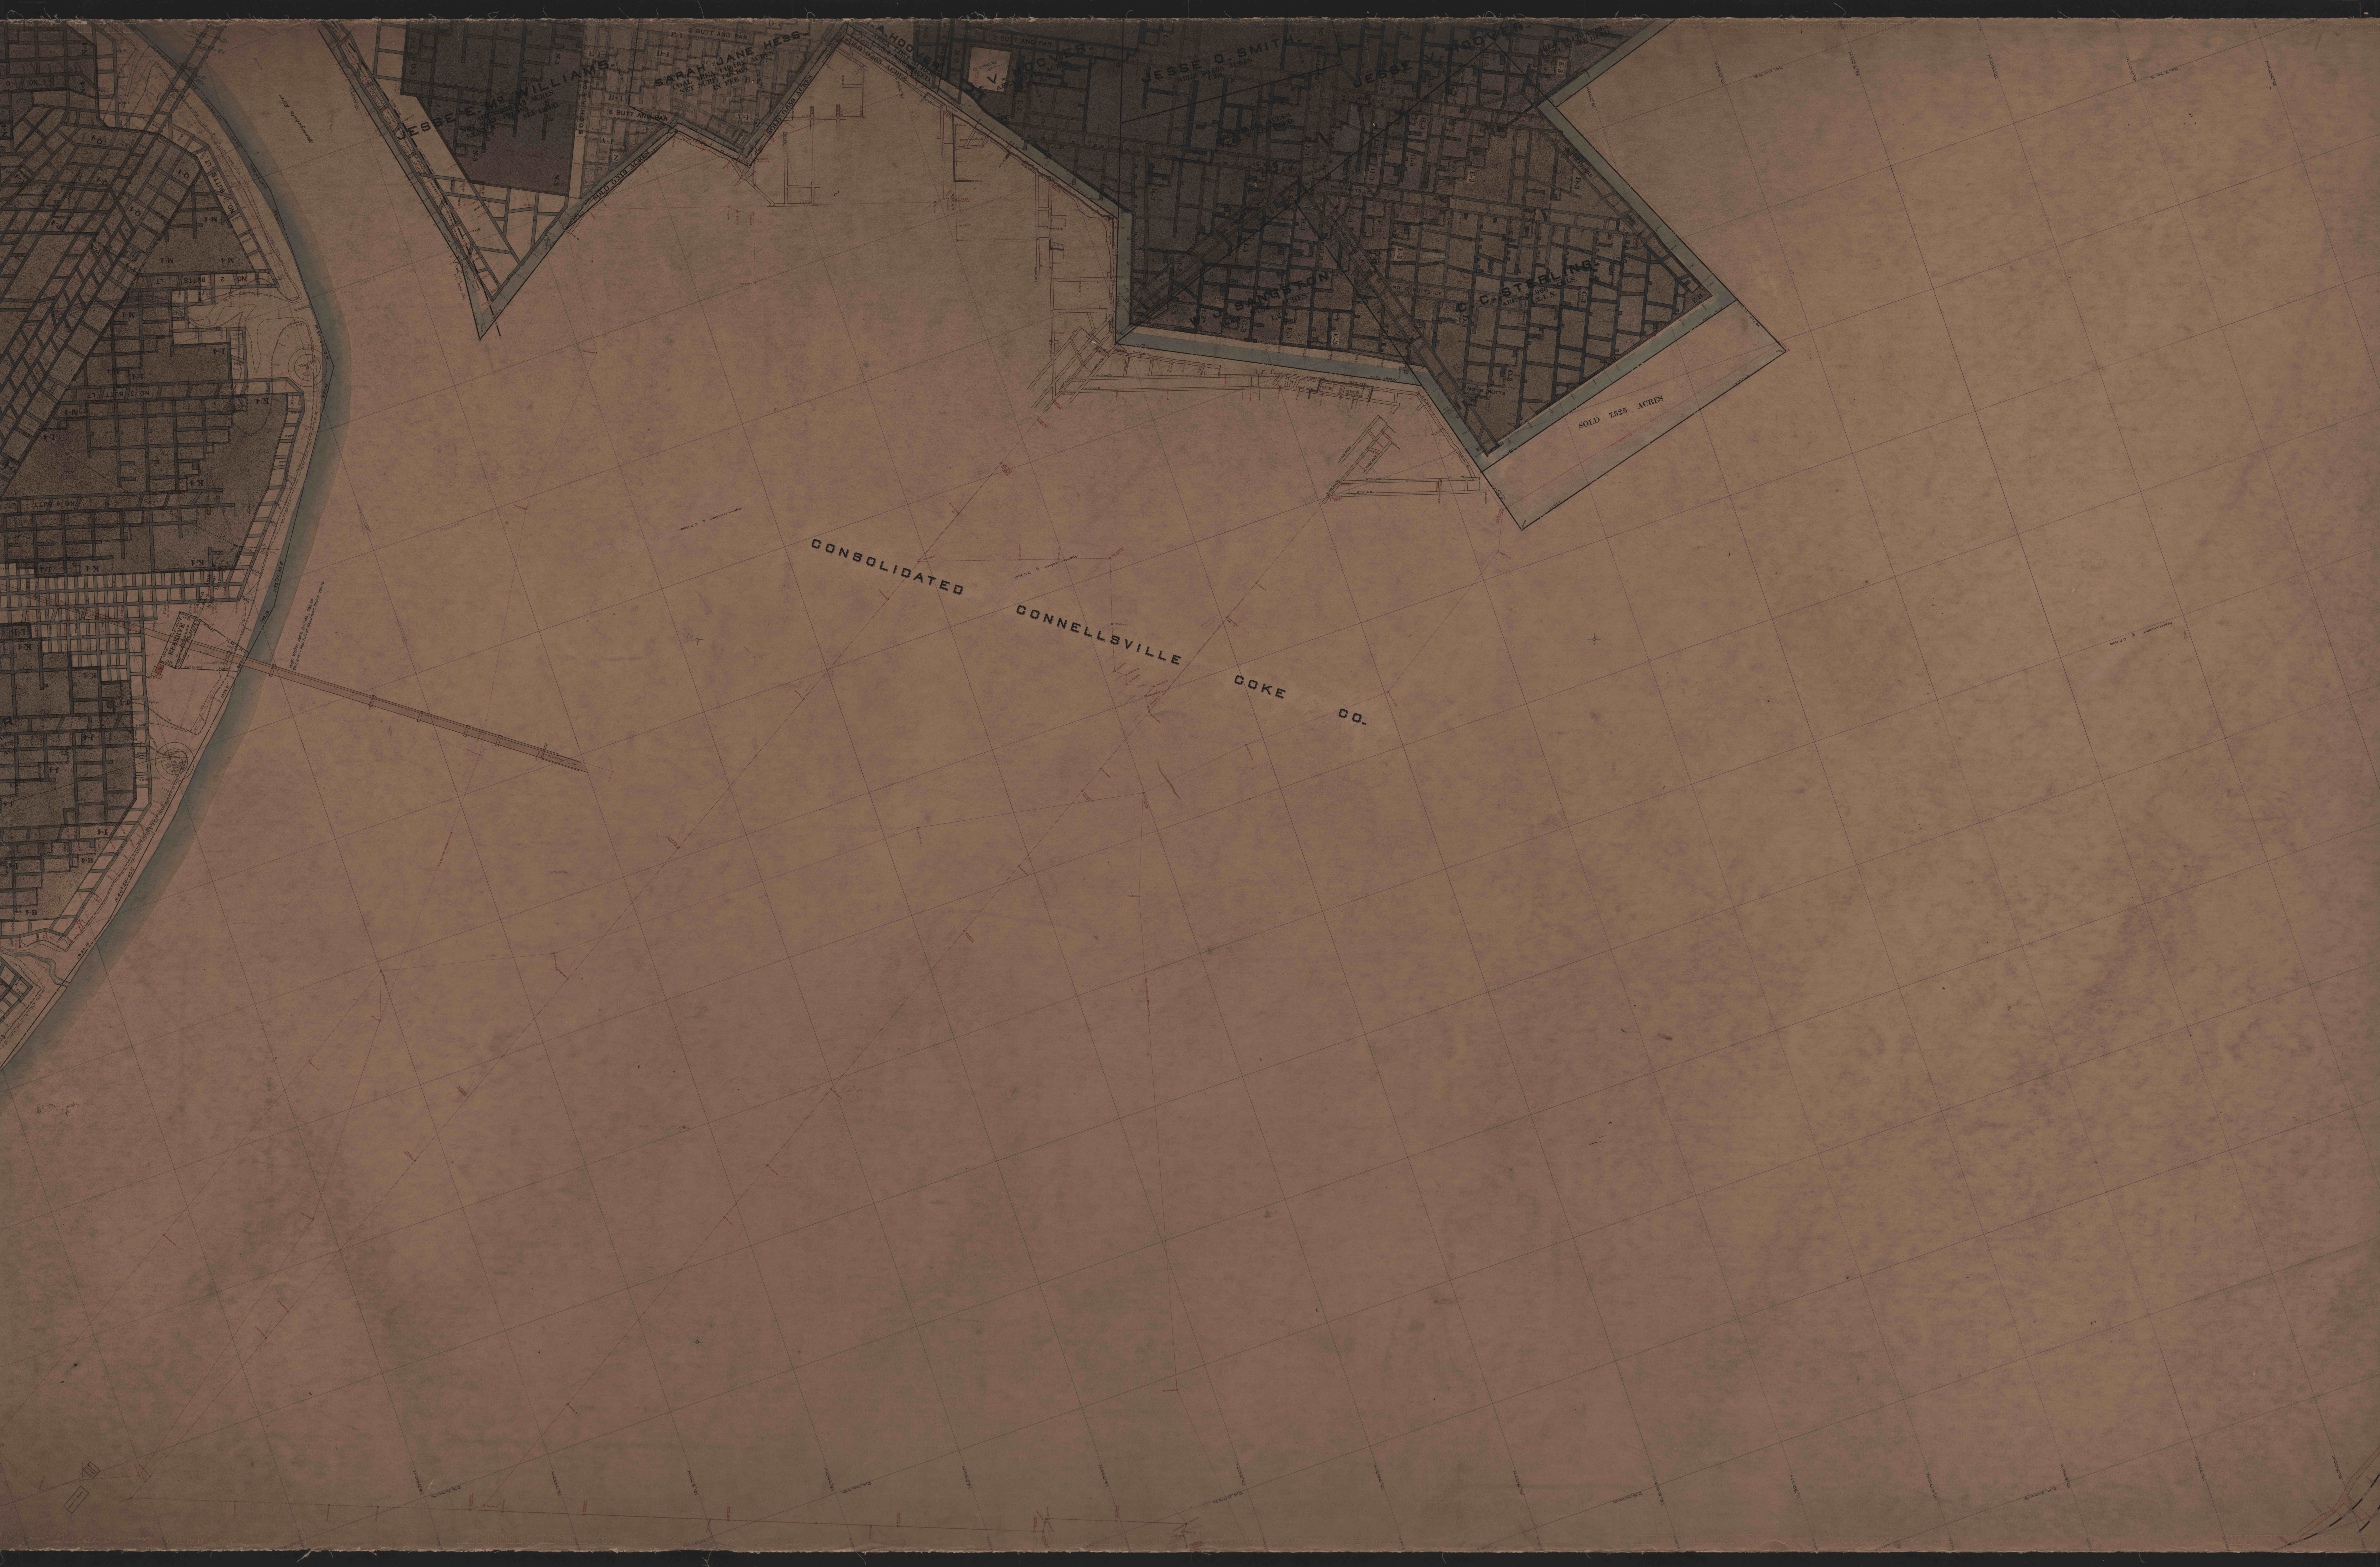

CONSOLIDATED
CONNELLSVILLE
COKE
CO.

JESSE E. WILLIAMS
SARAH JANE HESS
JESSE D. SMITH

JESSE D. SMITH
P. C. STERLING
SOLD 2825 ACRES