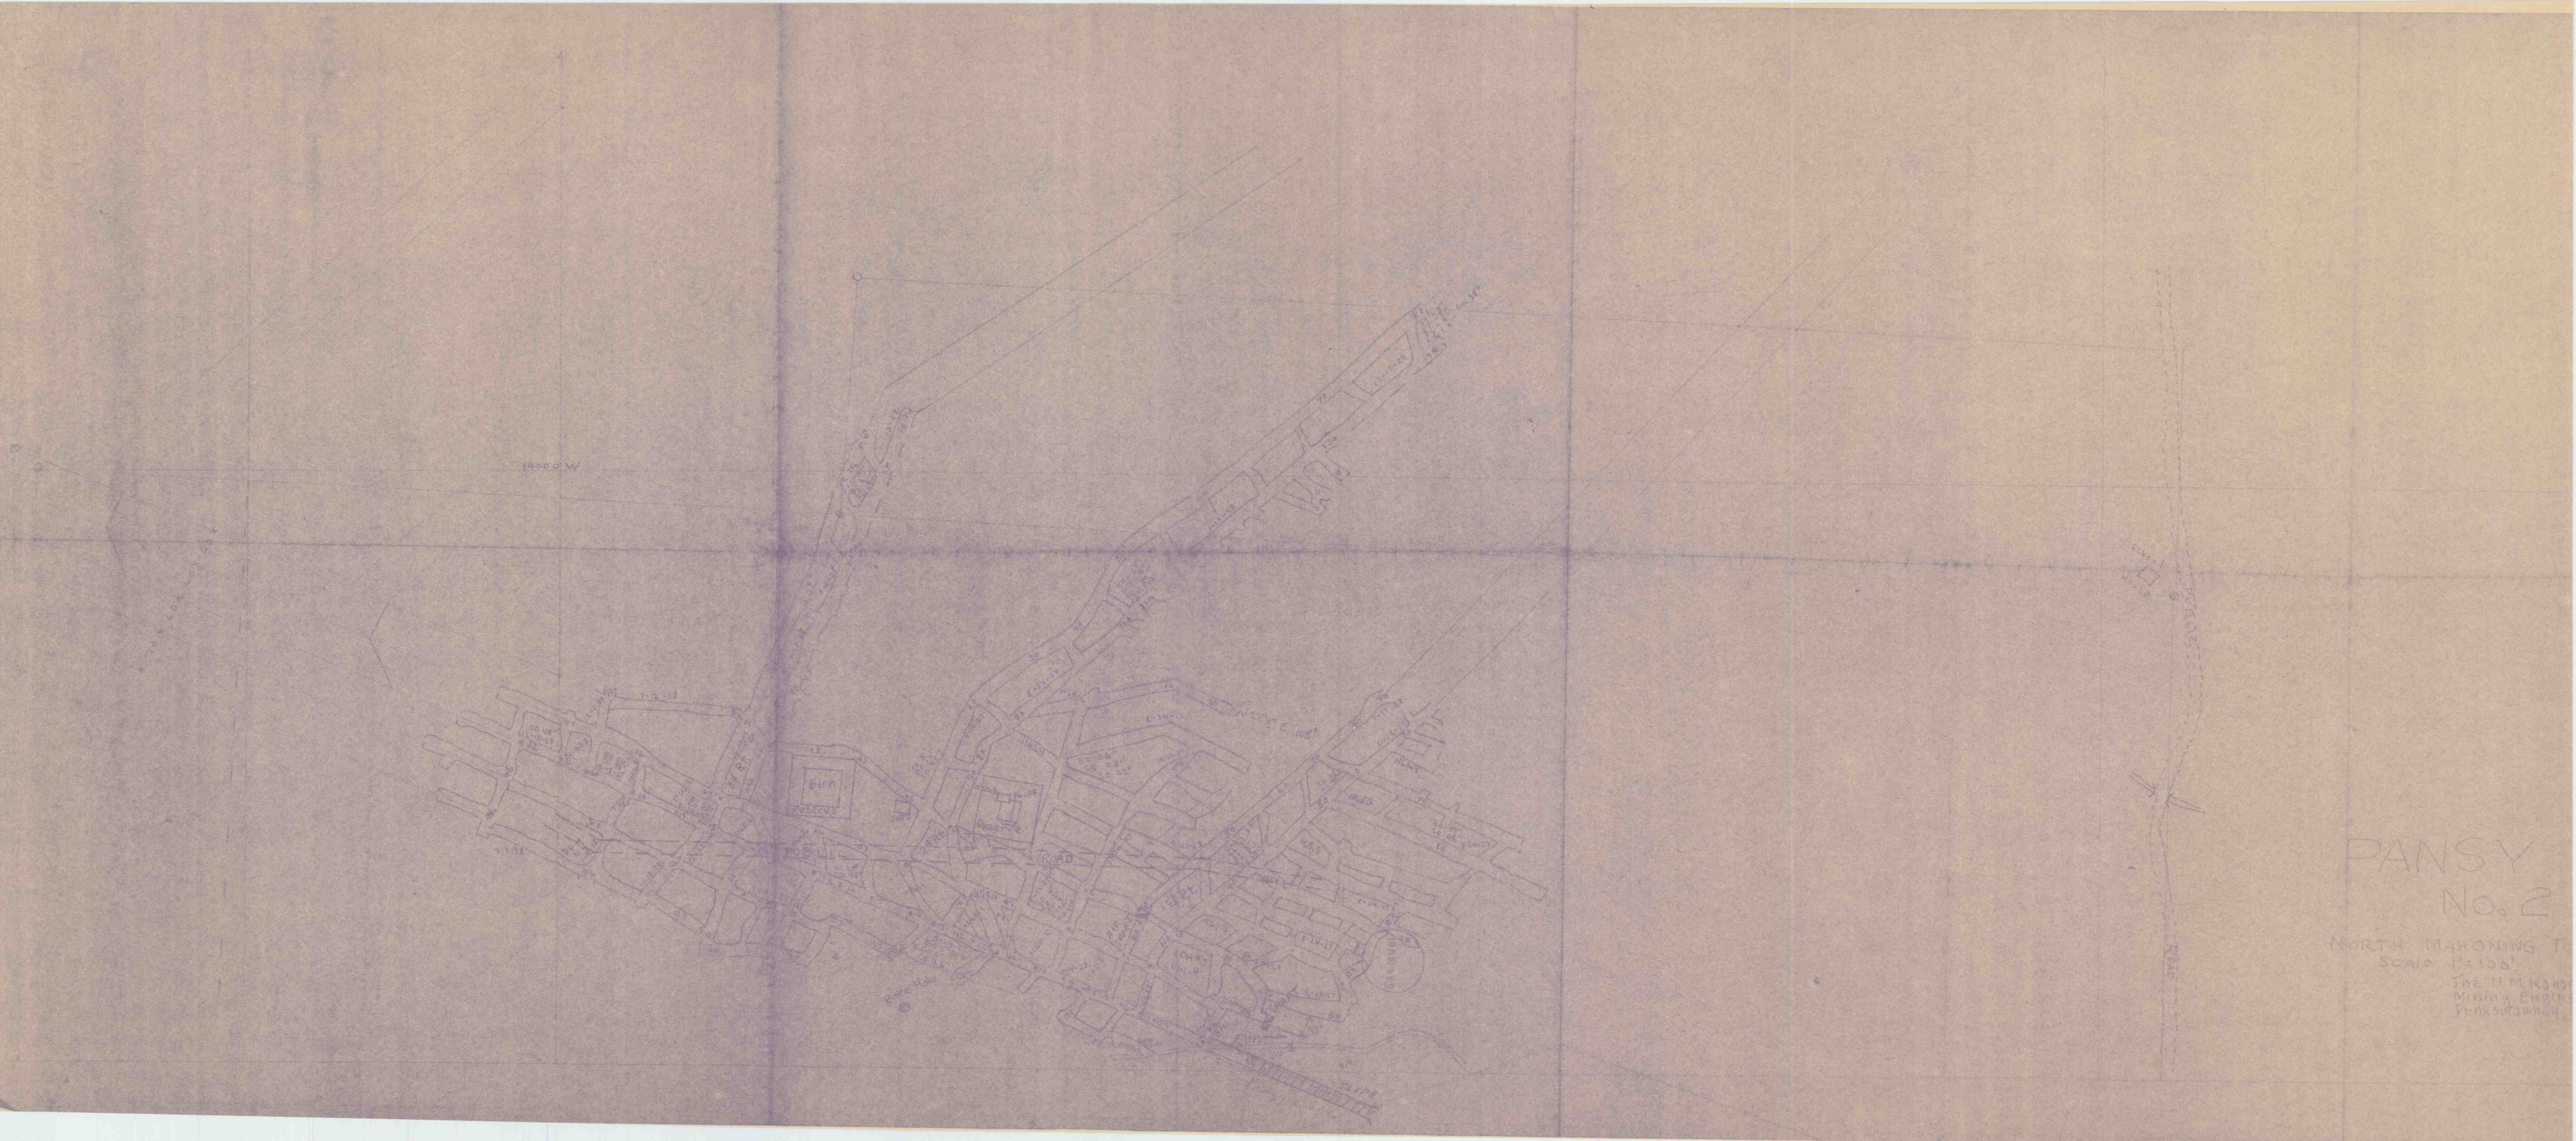
PANSY
No. 2
NORTH MAHONING T
SCALE 1"=100'
THE H. M. KANE
MINING ENGIN
PITTSBURGH