


71-5-4

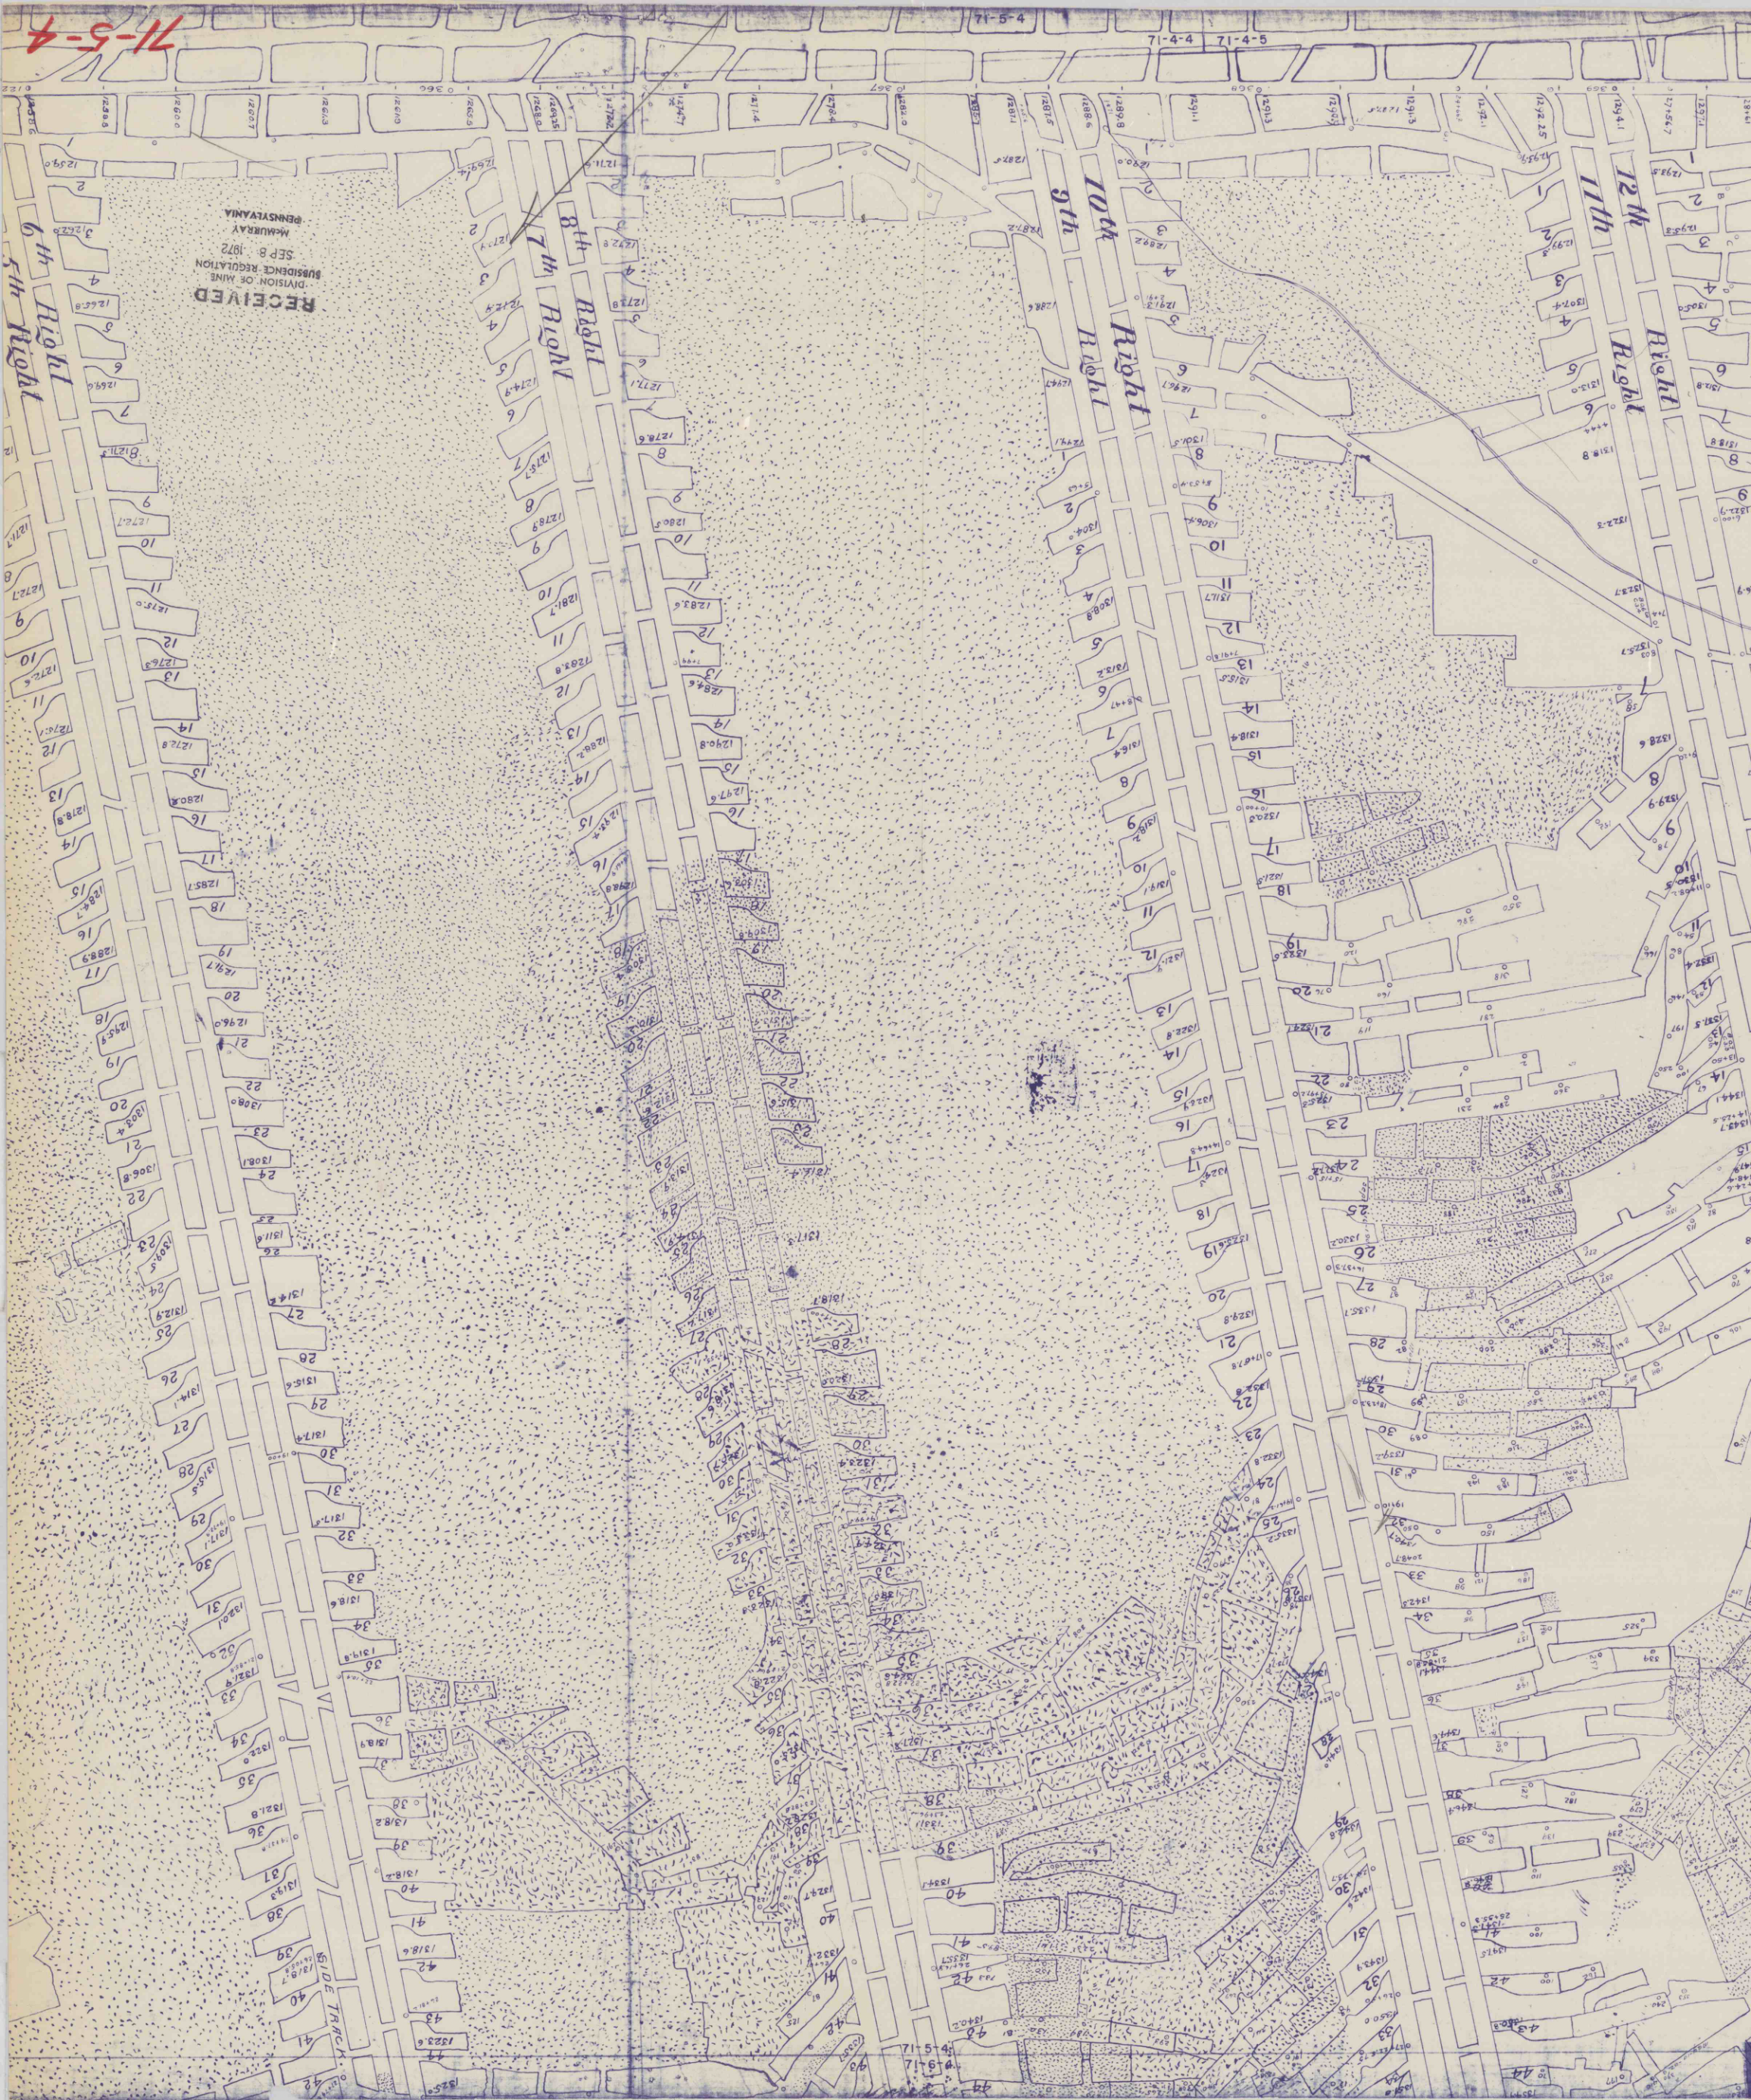

RECEIVED
DIVISION OF MINE
SUBSIDENCE REGULATION
SEP 8 1972
McMURRAY
PENNSYLVANIA

SIDE TRACK

