


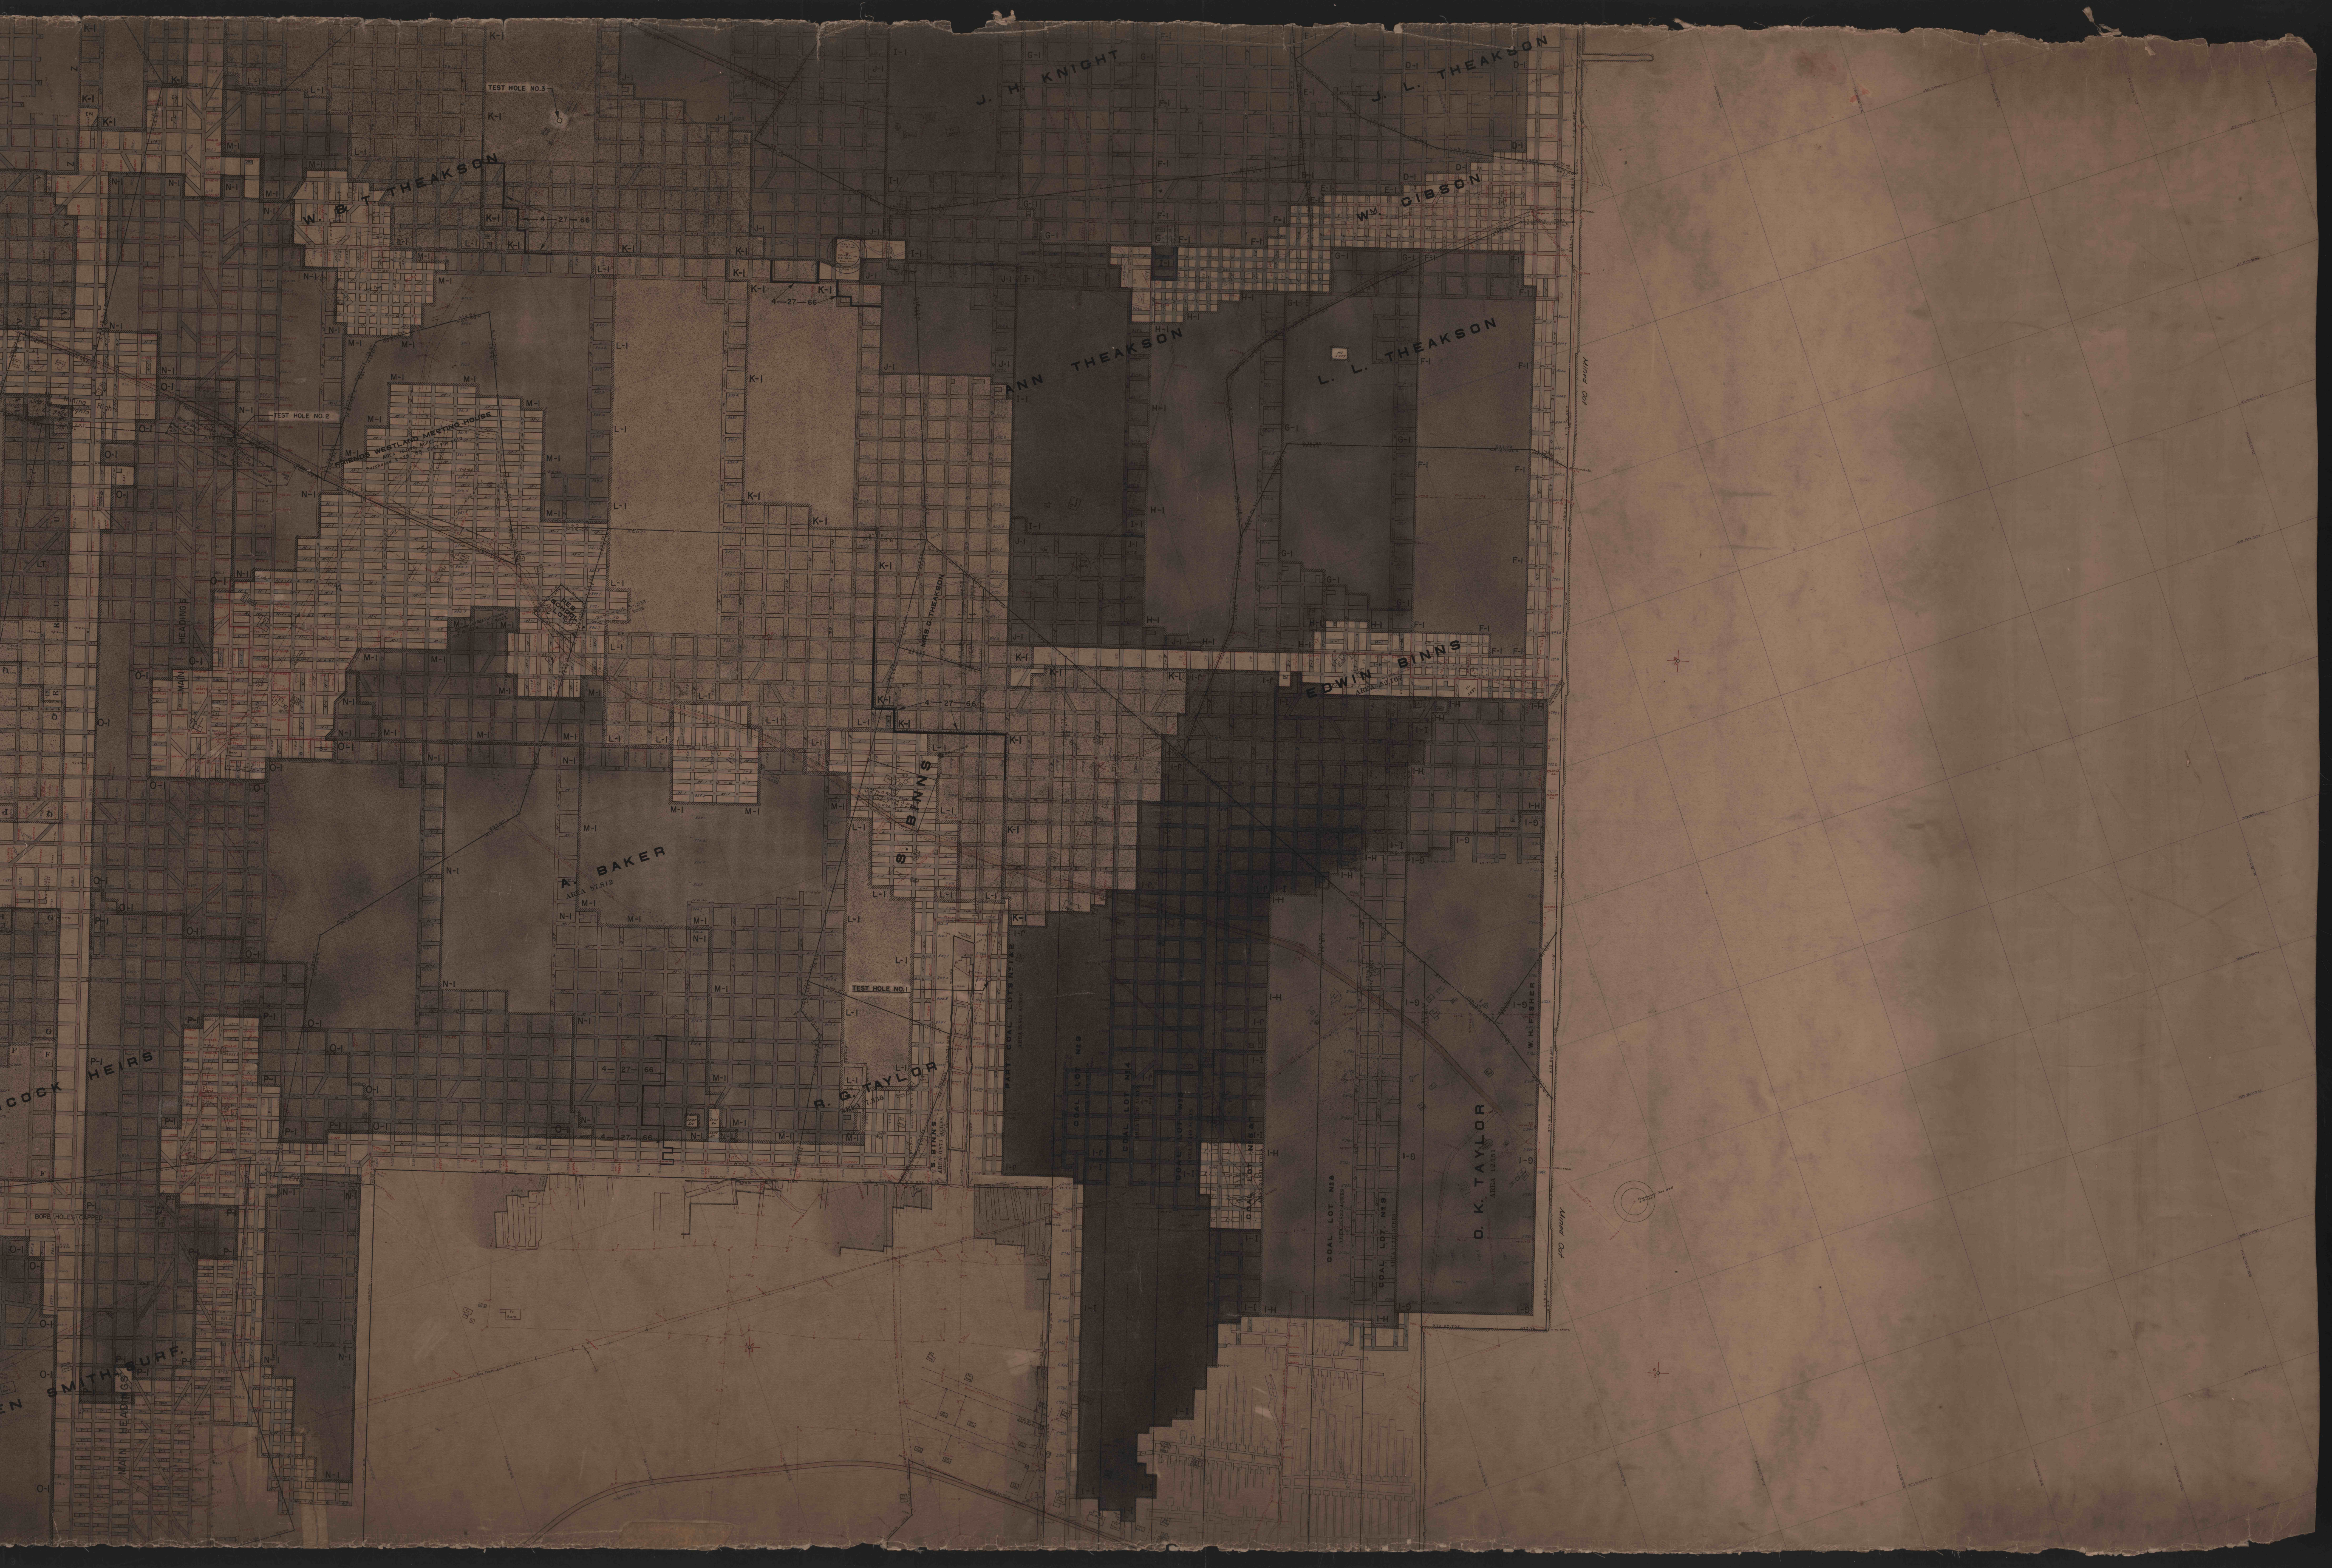

W. B. T. THEAKSON

J. H. KNIGHT

J. L. THEAKSON

WM. GIBSON

ANN THEAKSON

L. L. THEAKSON

EDWIN BINNS

A. BAKER

S. BINNS

R. G. TAYLOR

O. K. TAYLOR

TEST HOLE NO. 2

TEST HOLE NO. 1

TEST HOLE NO. 3

DIVISION WESTLAND MEETING HOUSE

COAL LOT NO. 2

COAL LOT NO. 4

COAL LOT NO. 5

COAL LOT NO. 6

COAL LOT NO. 8

COAL LOT NO. 9

COCK HEIRS

SMITH SURF.