


177 to 183

JOHN FULLER

Sheet 12

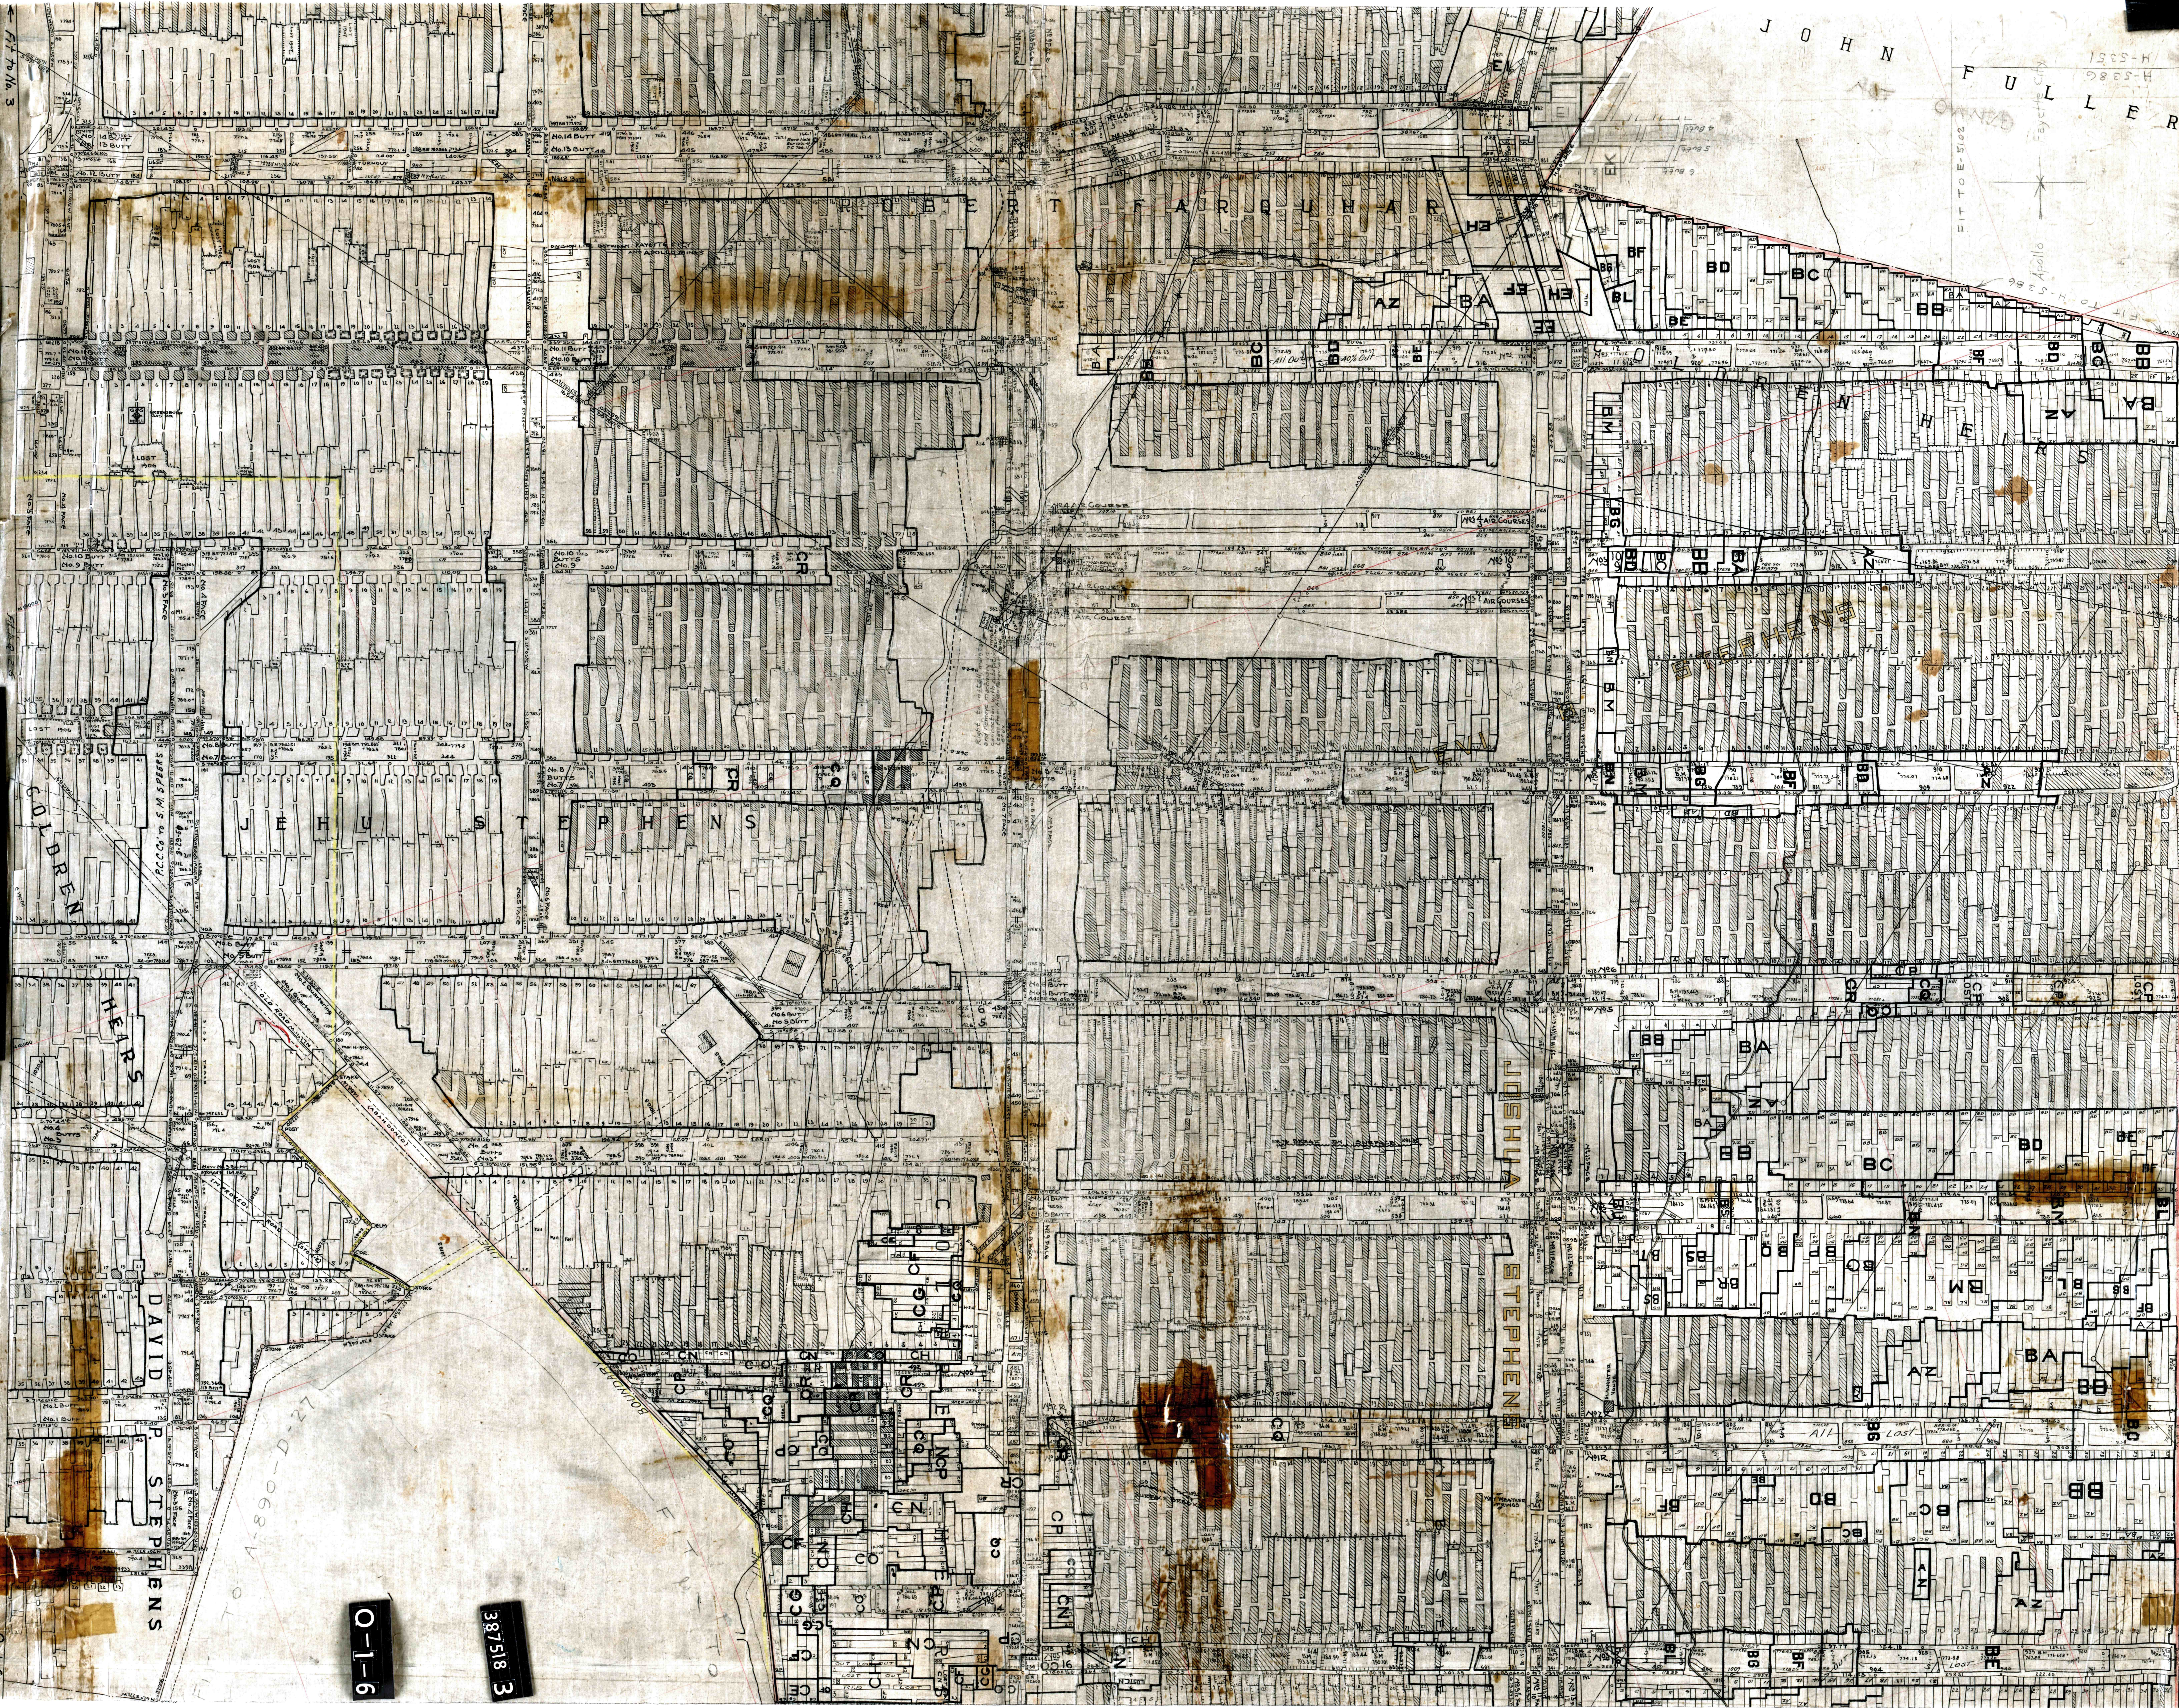

O-1-6

387518 3

Sheet 12