


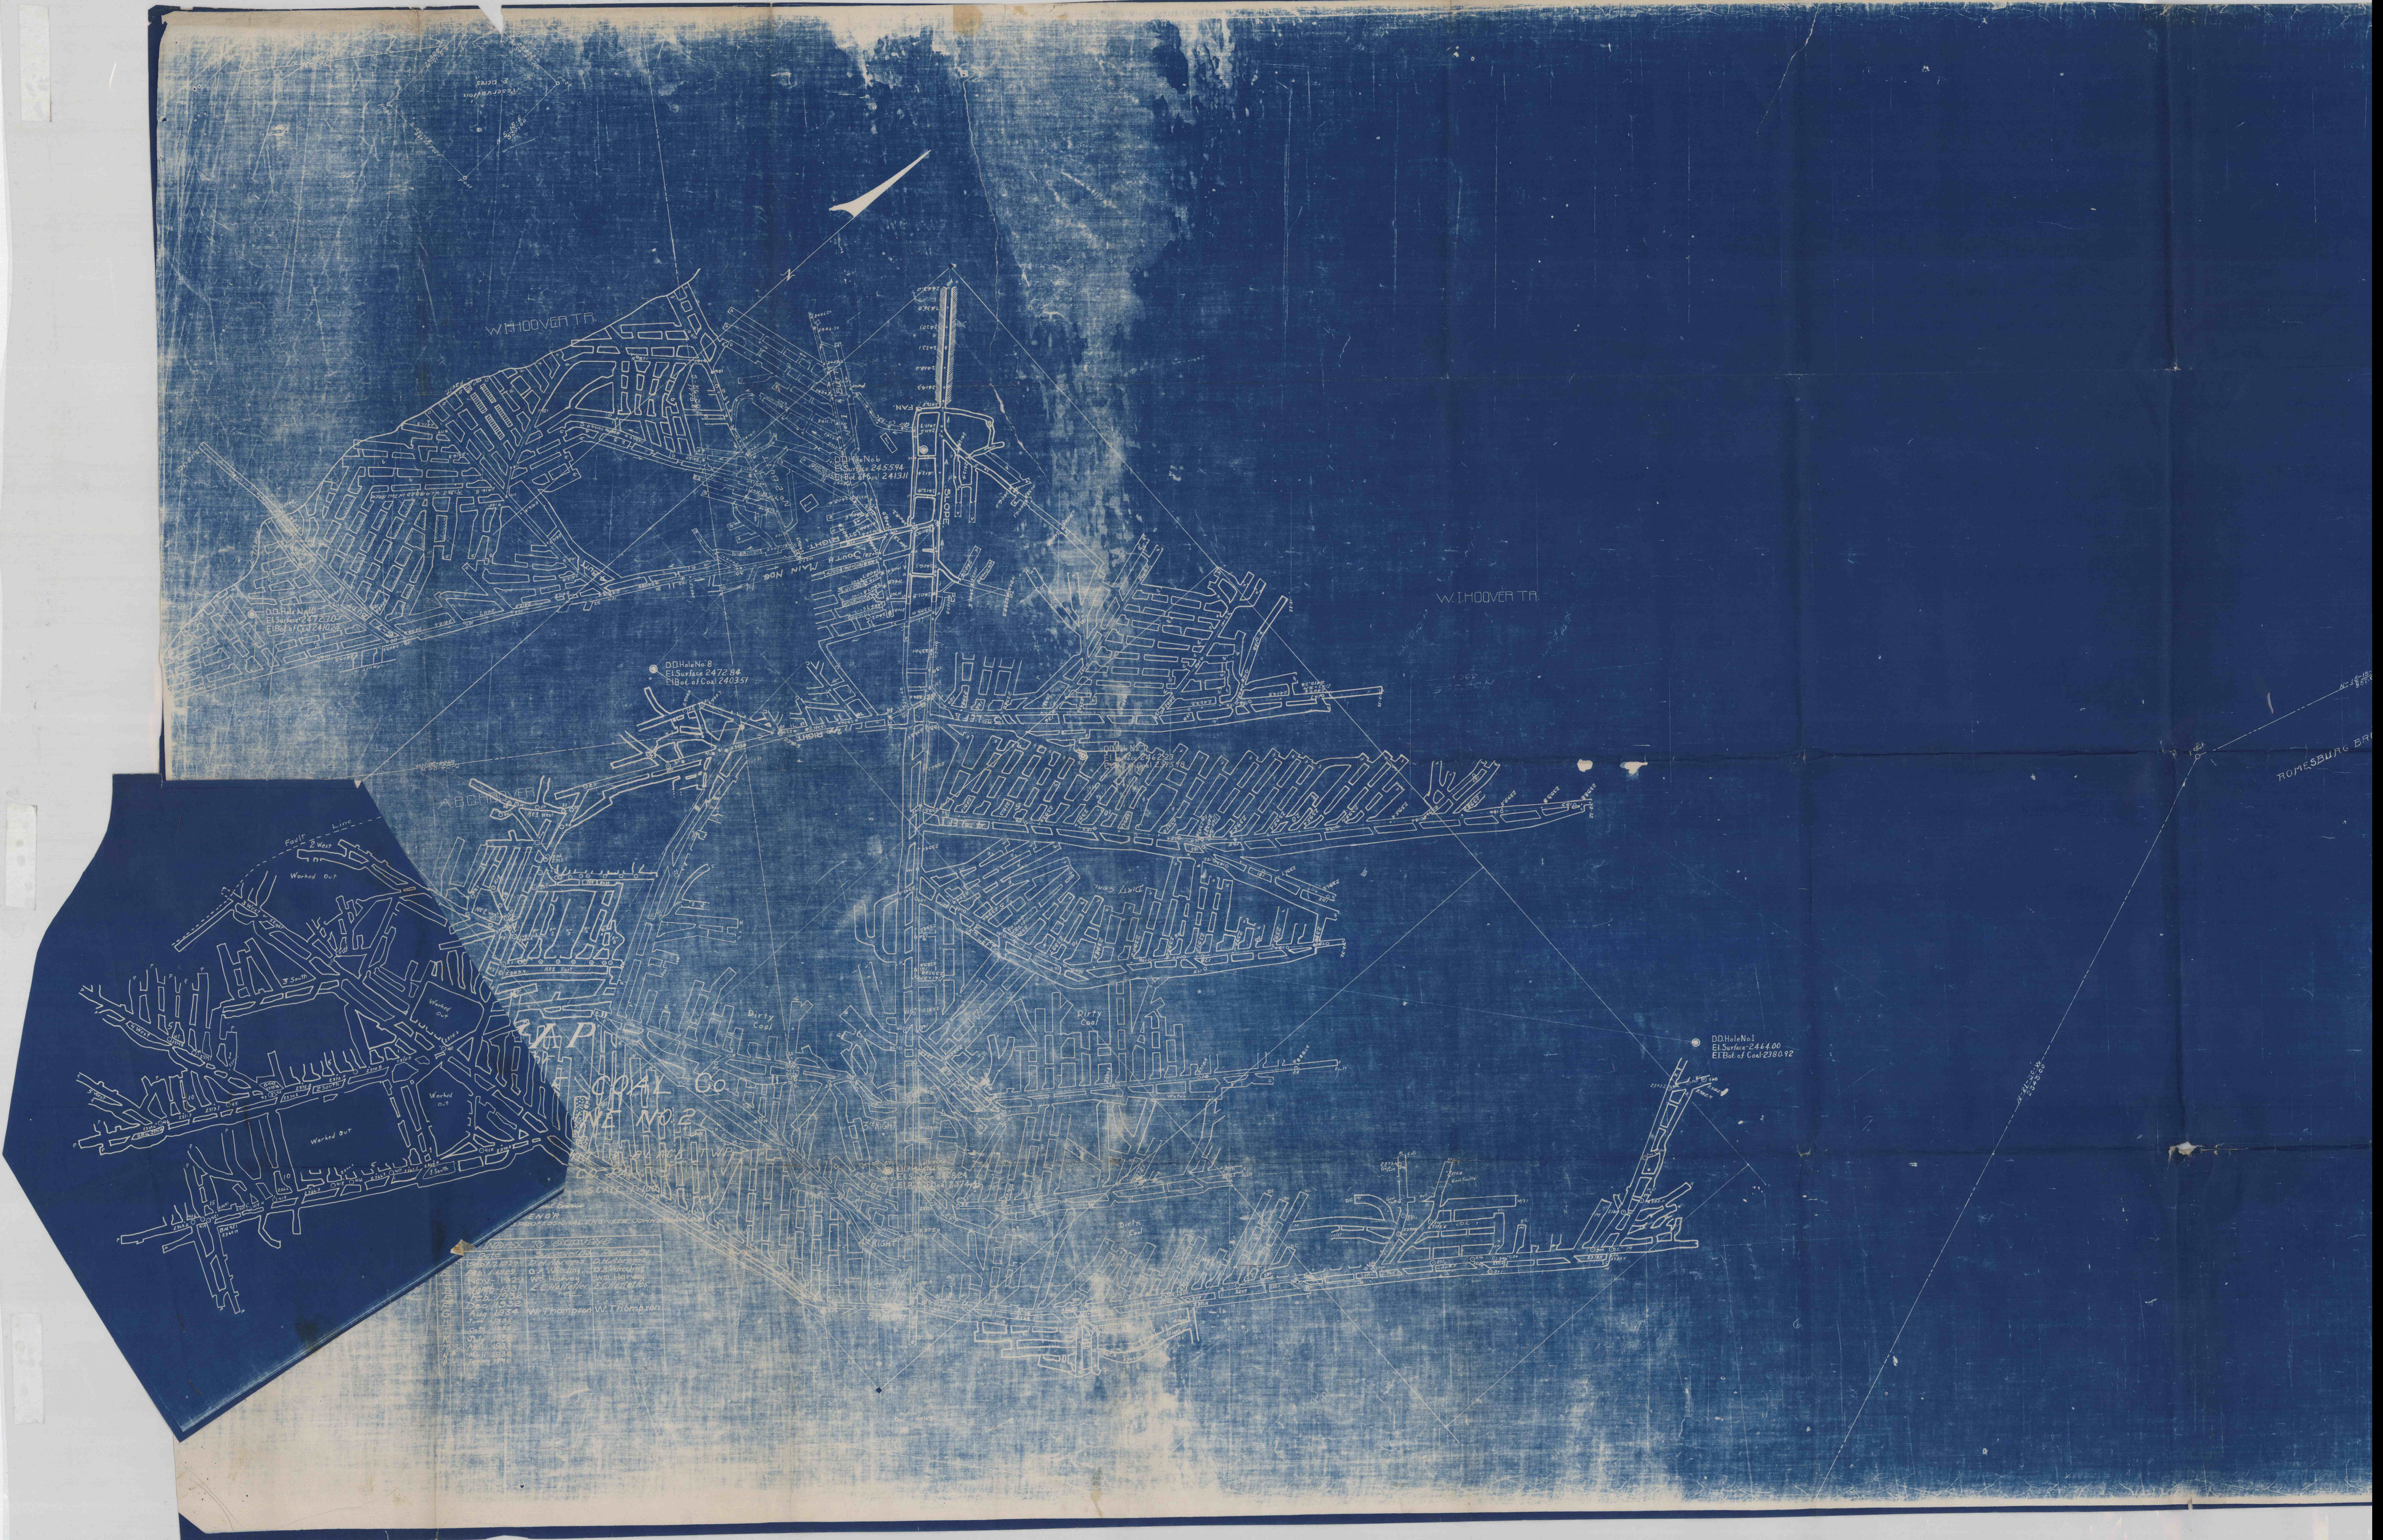

W. HOOVER TR.

W. HOOVER TR.

ROMESBURG BR.

DD Hole No. 8
El. Surface 2472.80
El. Bot. of Coal 2403.51

DD Hole No. 1
El. Surface 2444.00
El. Bot. of Coal 2380.92

COAL CO.
VE NO. 2

INDEX TO QUANTITIES	
1920	W. Thompson
1921	W. Thompson
