


EDWINA
2
1"=100'

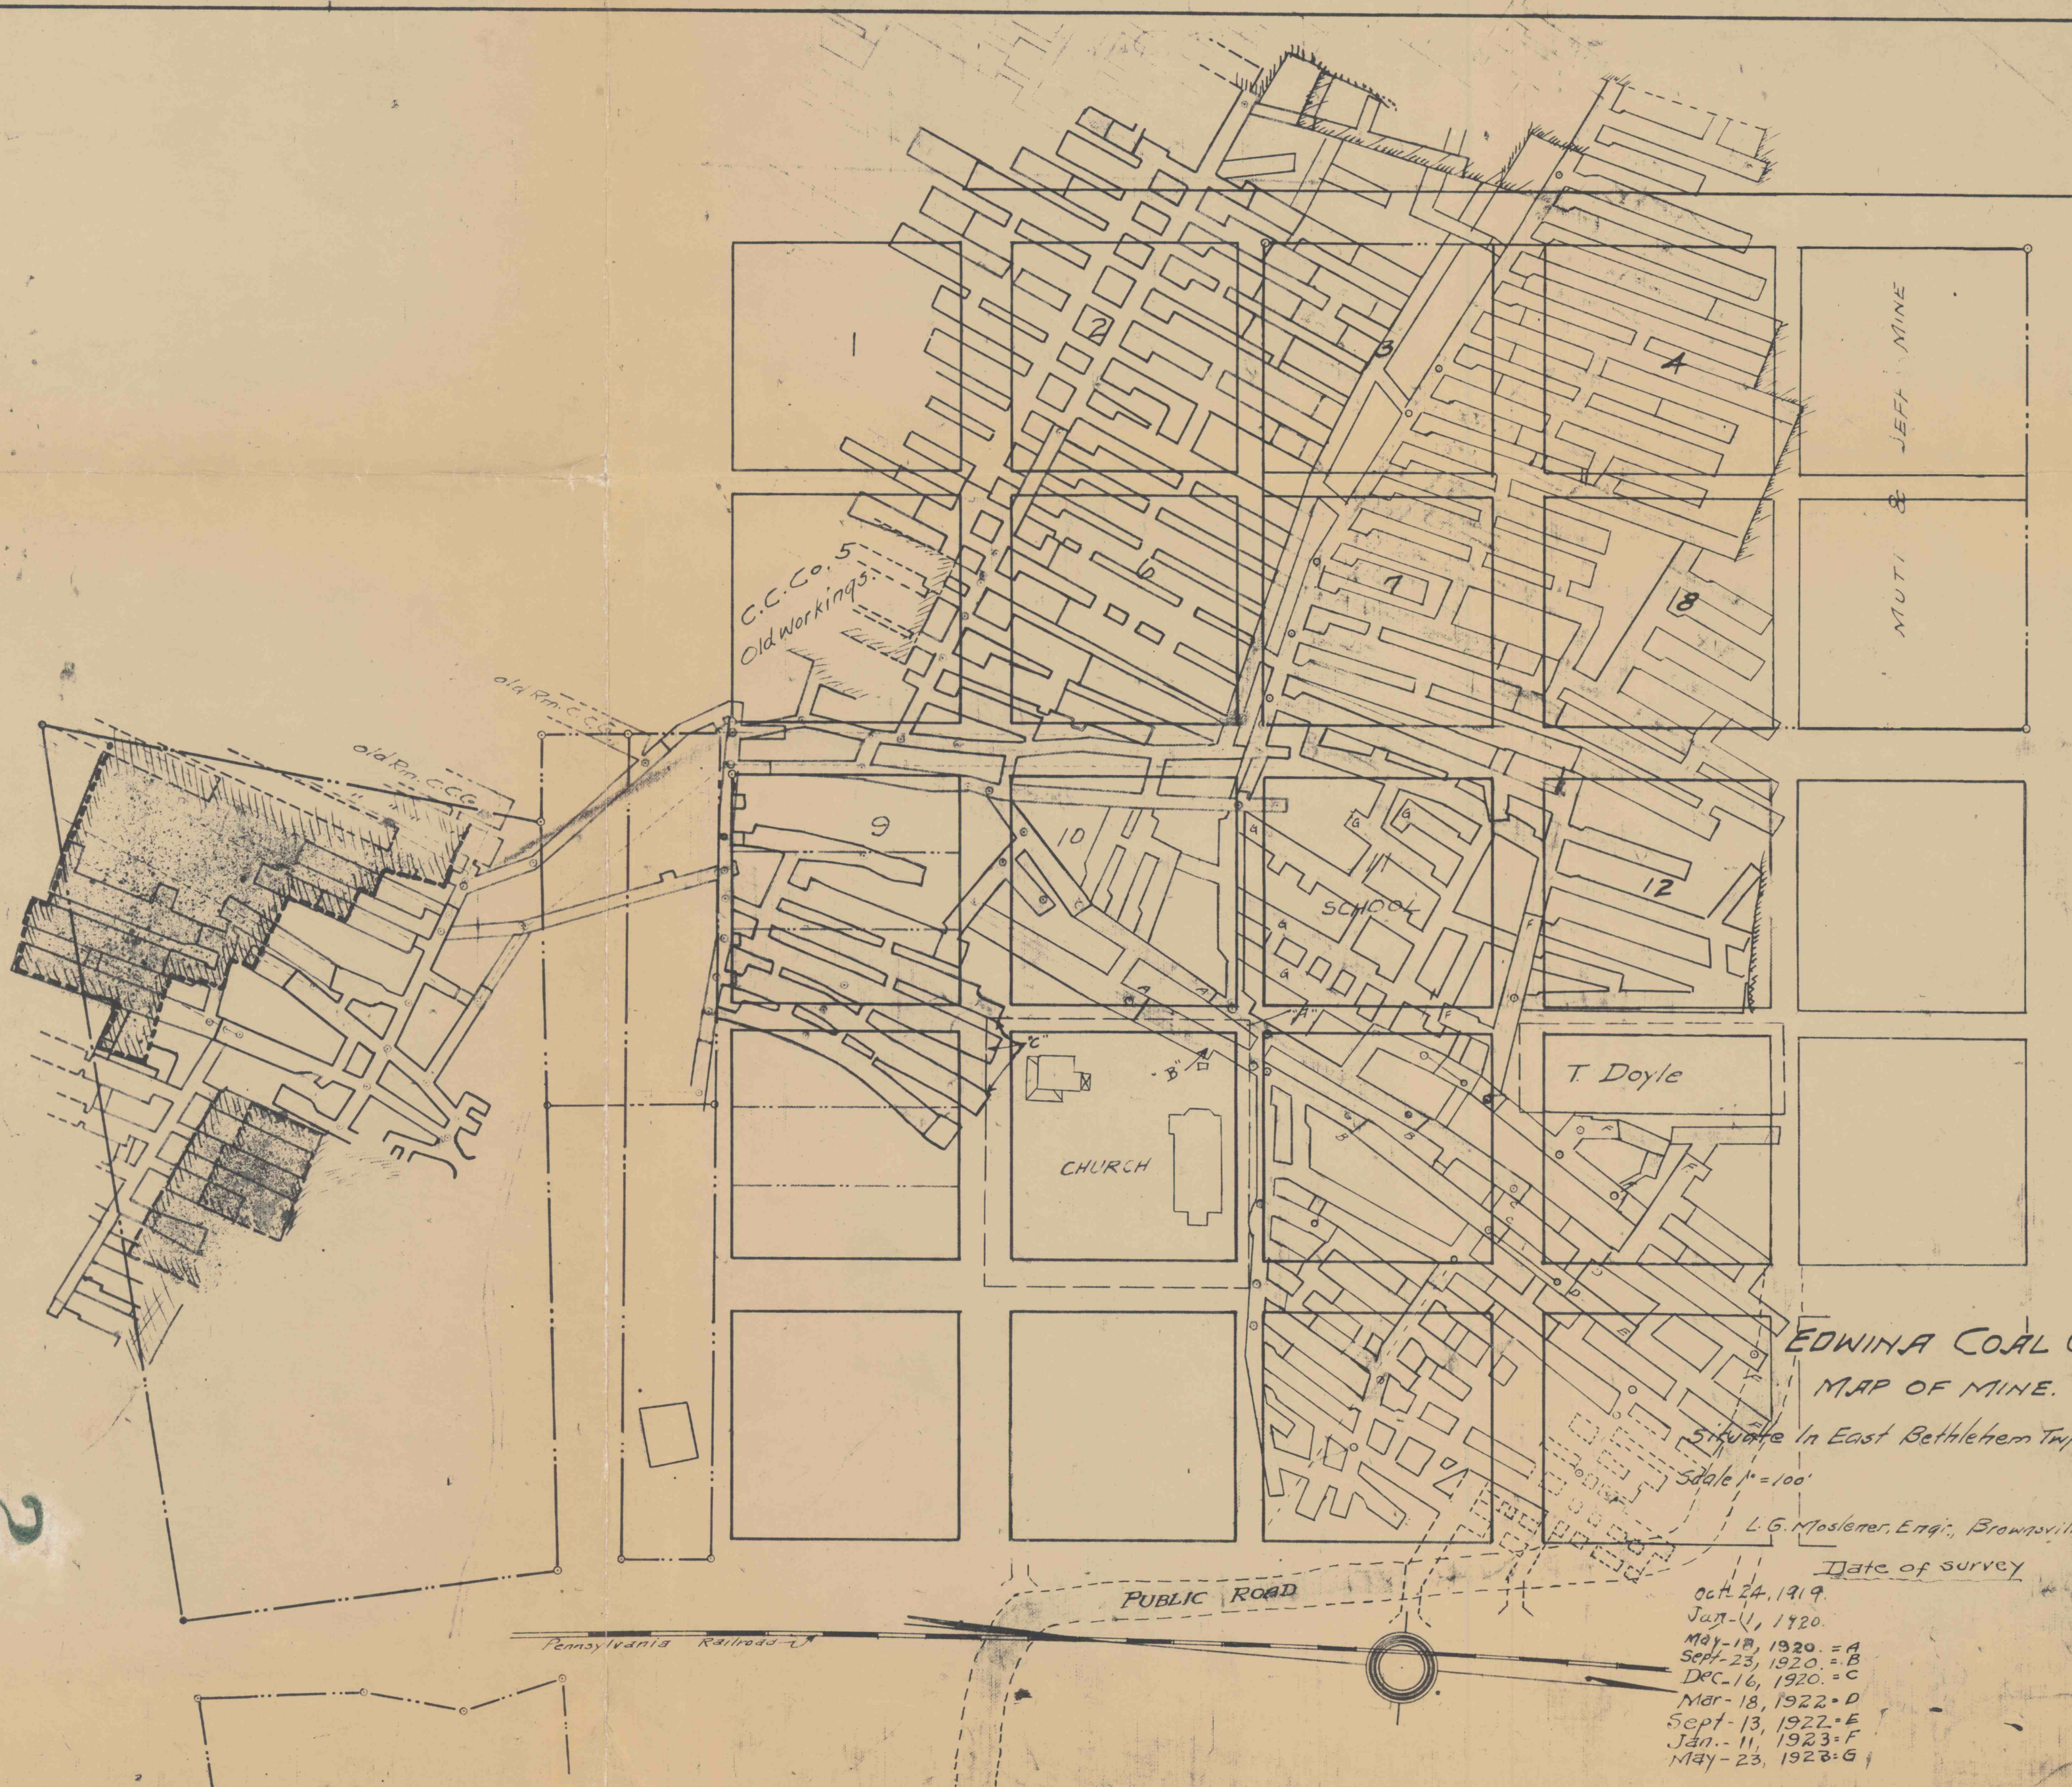

EDWINA COAL CO.
MAP OF MINE.

Situate in East Bethlehem Twp, Wash Co., Pa.

Scale 1"=100'

Sept. 1919.

L.G. Mosler, Engr., Brownsville, Pa.

Date of survey

- Oct. 24, 1919.
- Jan. 1, 1920.
- May 18, 1920. = A
- Sept. 23, 1920. = B
- Dec. 16, 1920. = C
- Mar. 18, 1922. = D
- Sept. 13, 1922. = E
- Jan. 11, 1923. = F
- May 23, 1923. = G