


MATCH TO SHEET 2

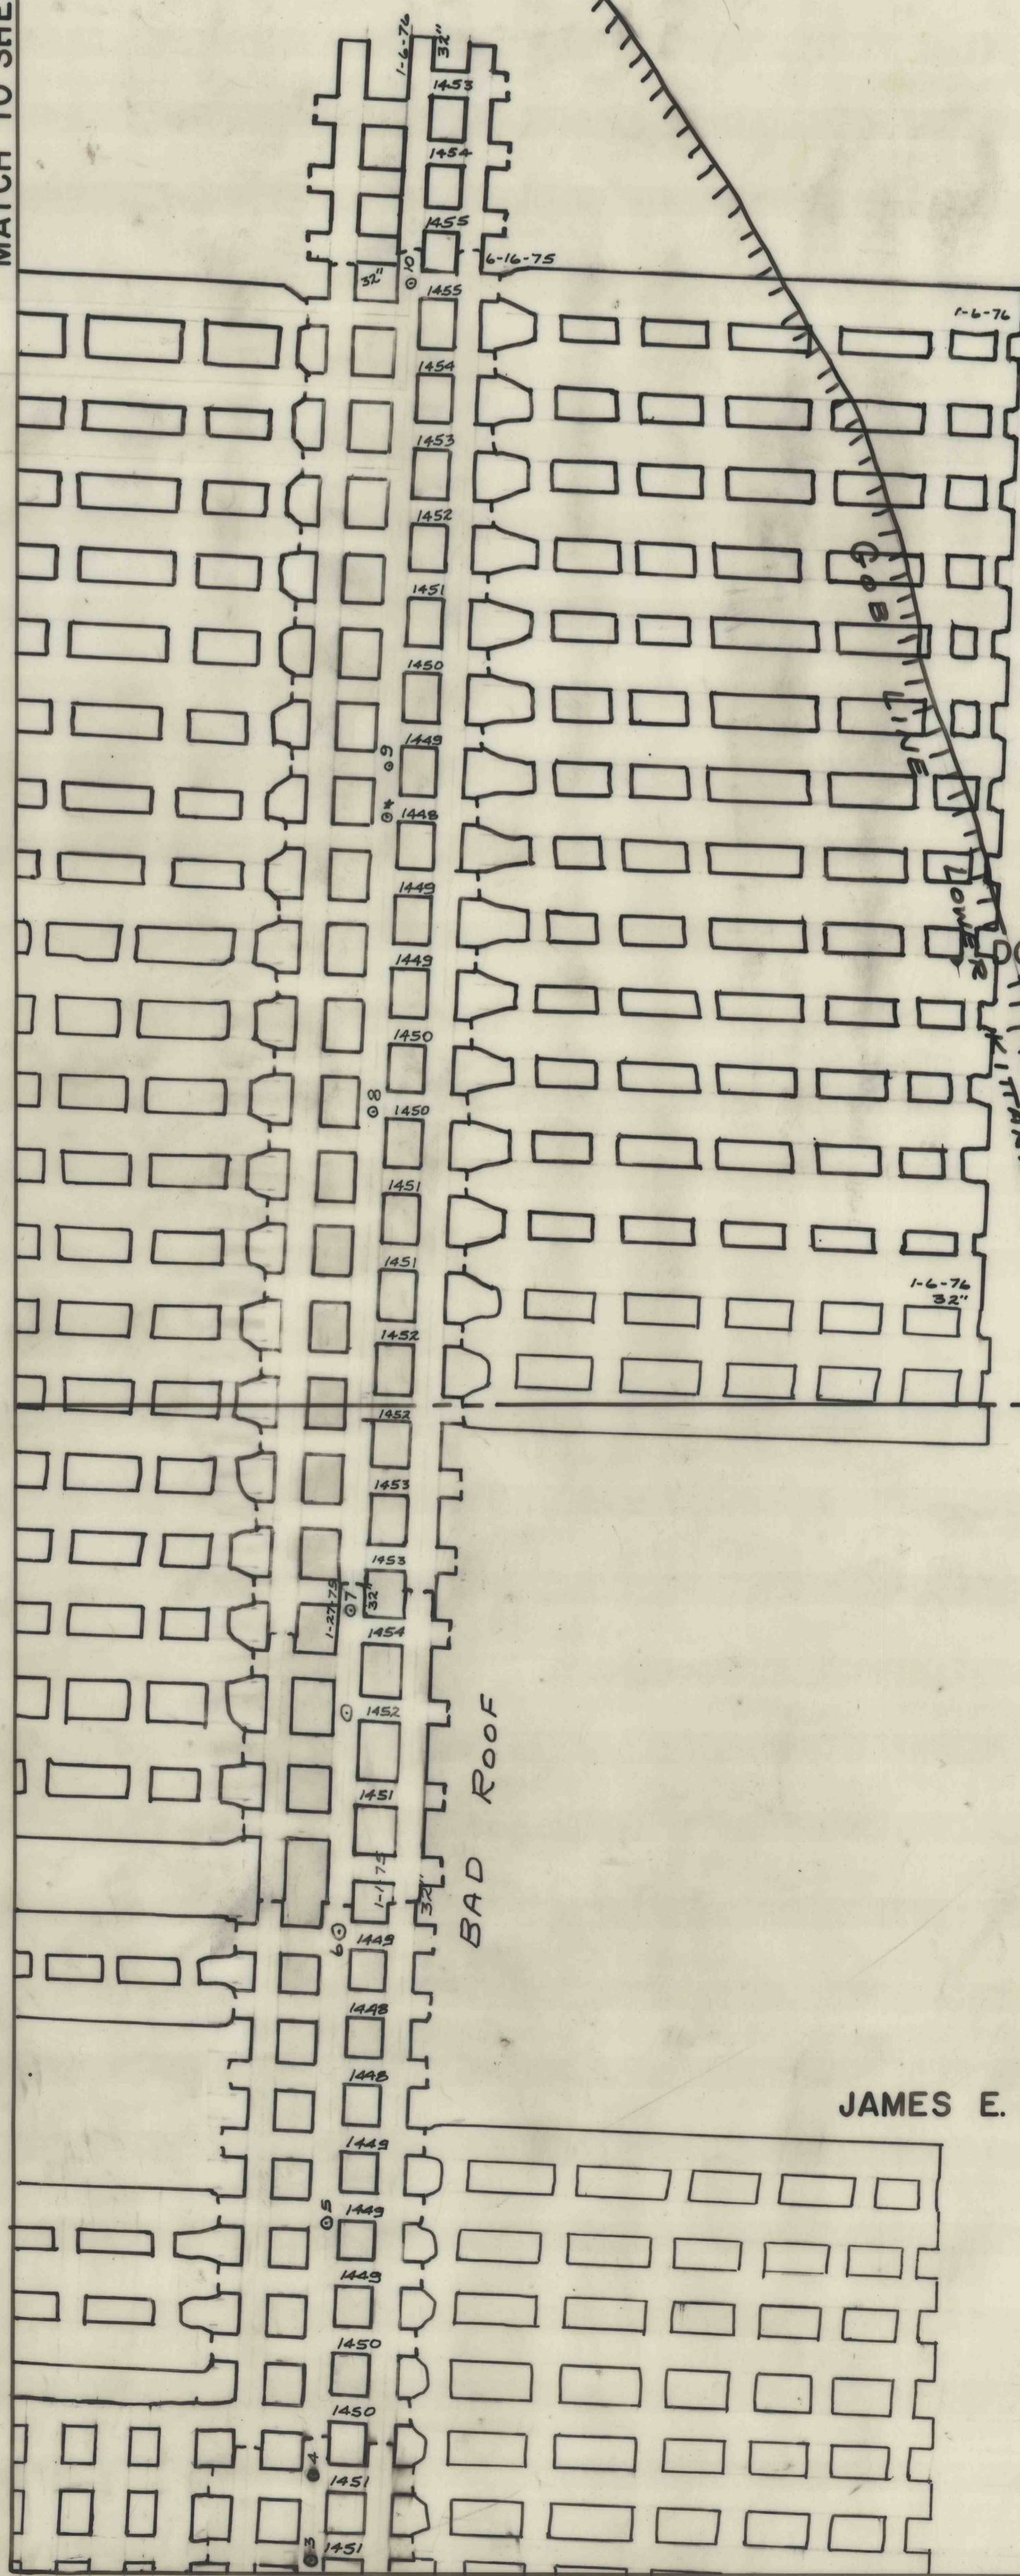

DOVERSPIKE BROS. INC.

R. R. YOUNG

JAMES E. MARTZ

R. R. YOUNG

RINGGOLD MINE  
DOVERSPIKE BROS. COAL CO.  
1"=100'  
MINING COMPLETED AS SHOWN 11-30-76



SHEET 4

MATCH TO SHEET 3