MATCH TO SHEET 4

R. R. YOUNG

DOVERSPIKE BROS., INC.

JAMES E. MARTZ

MATCH TO SHEET 1

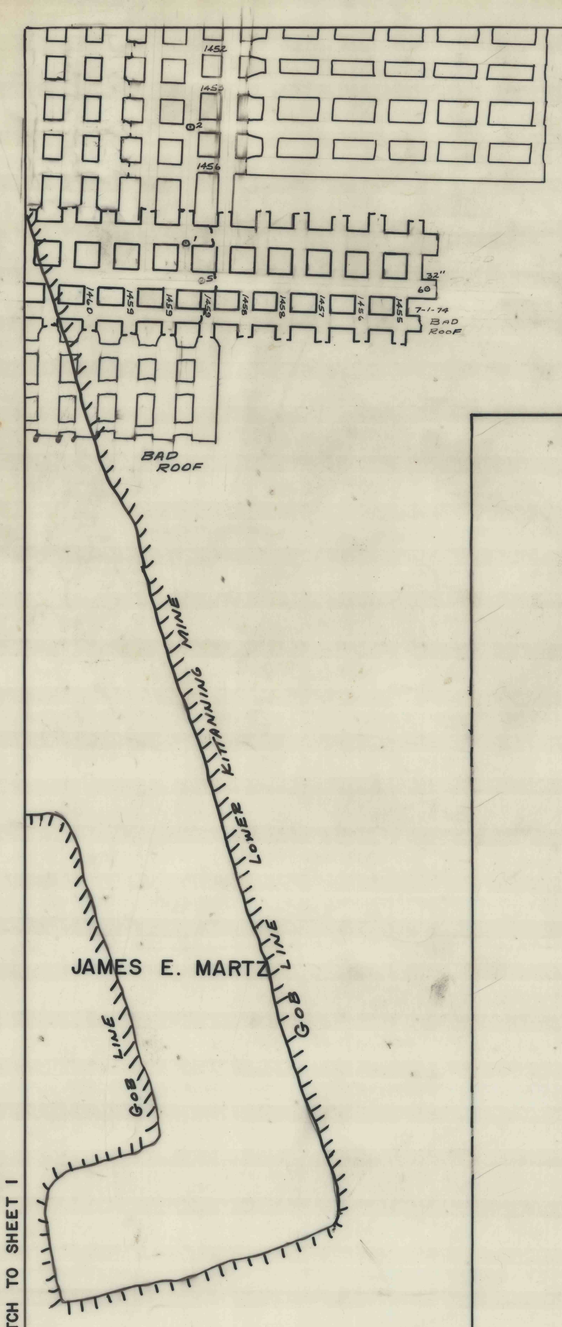

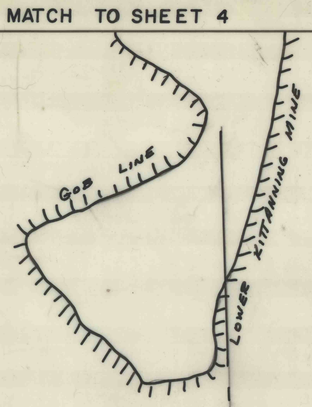

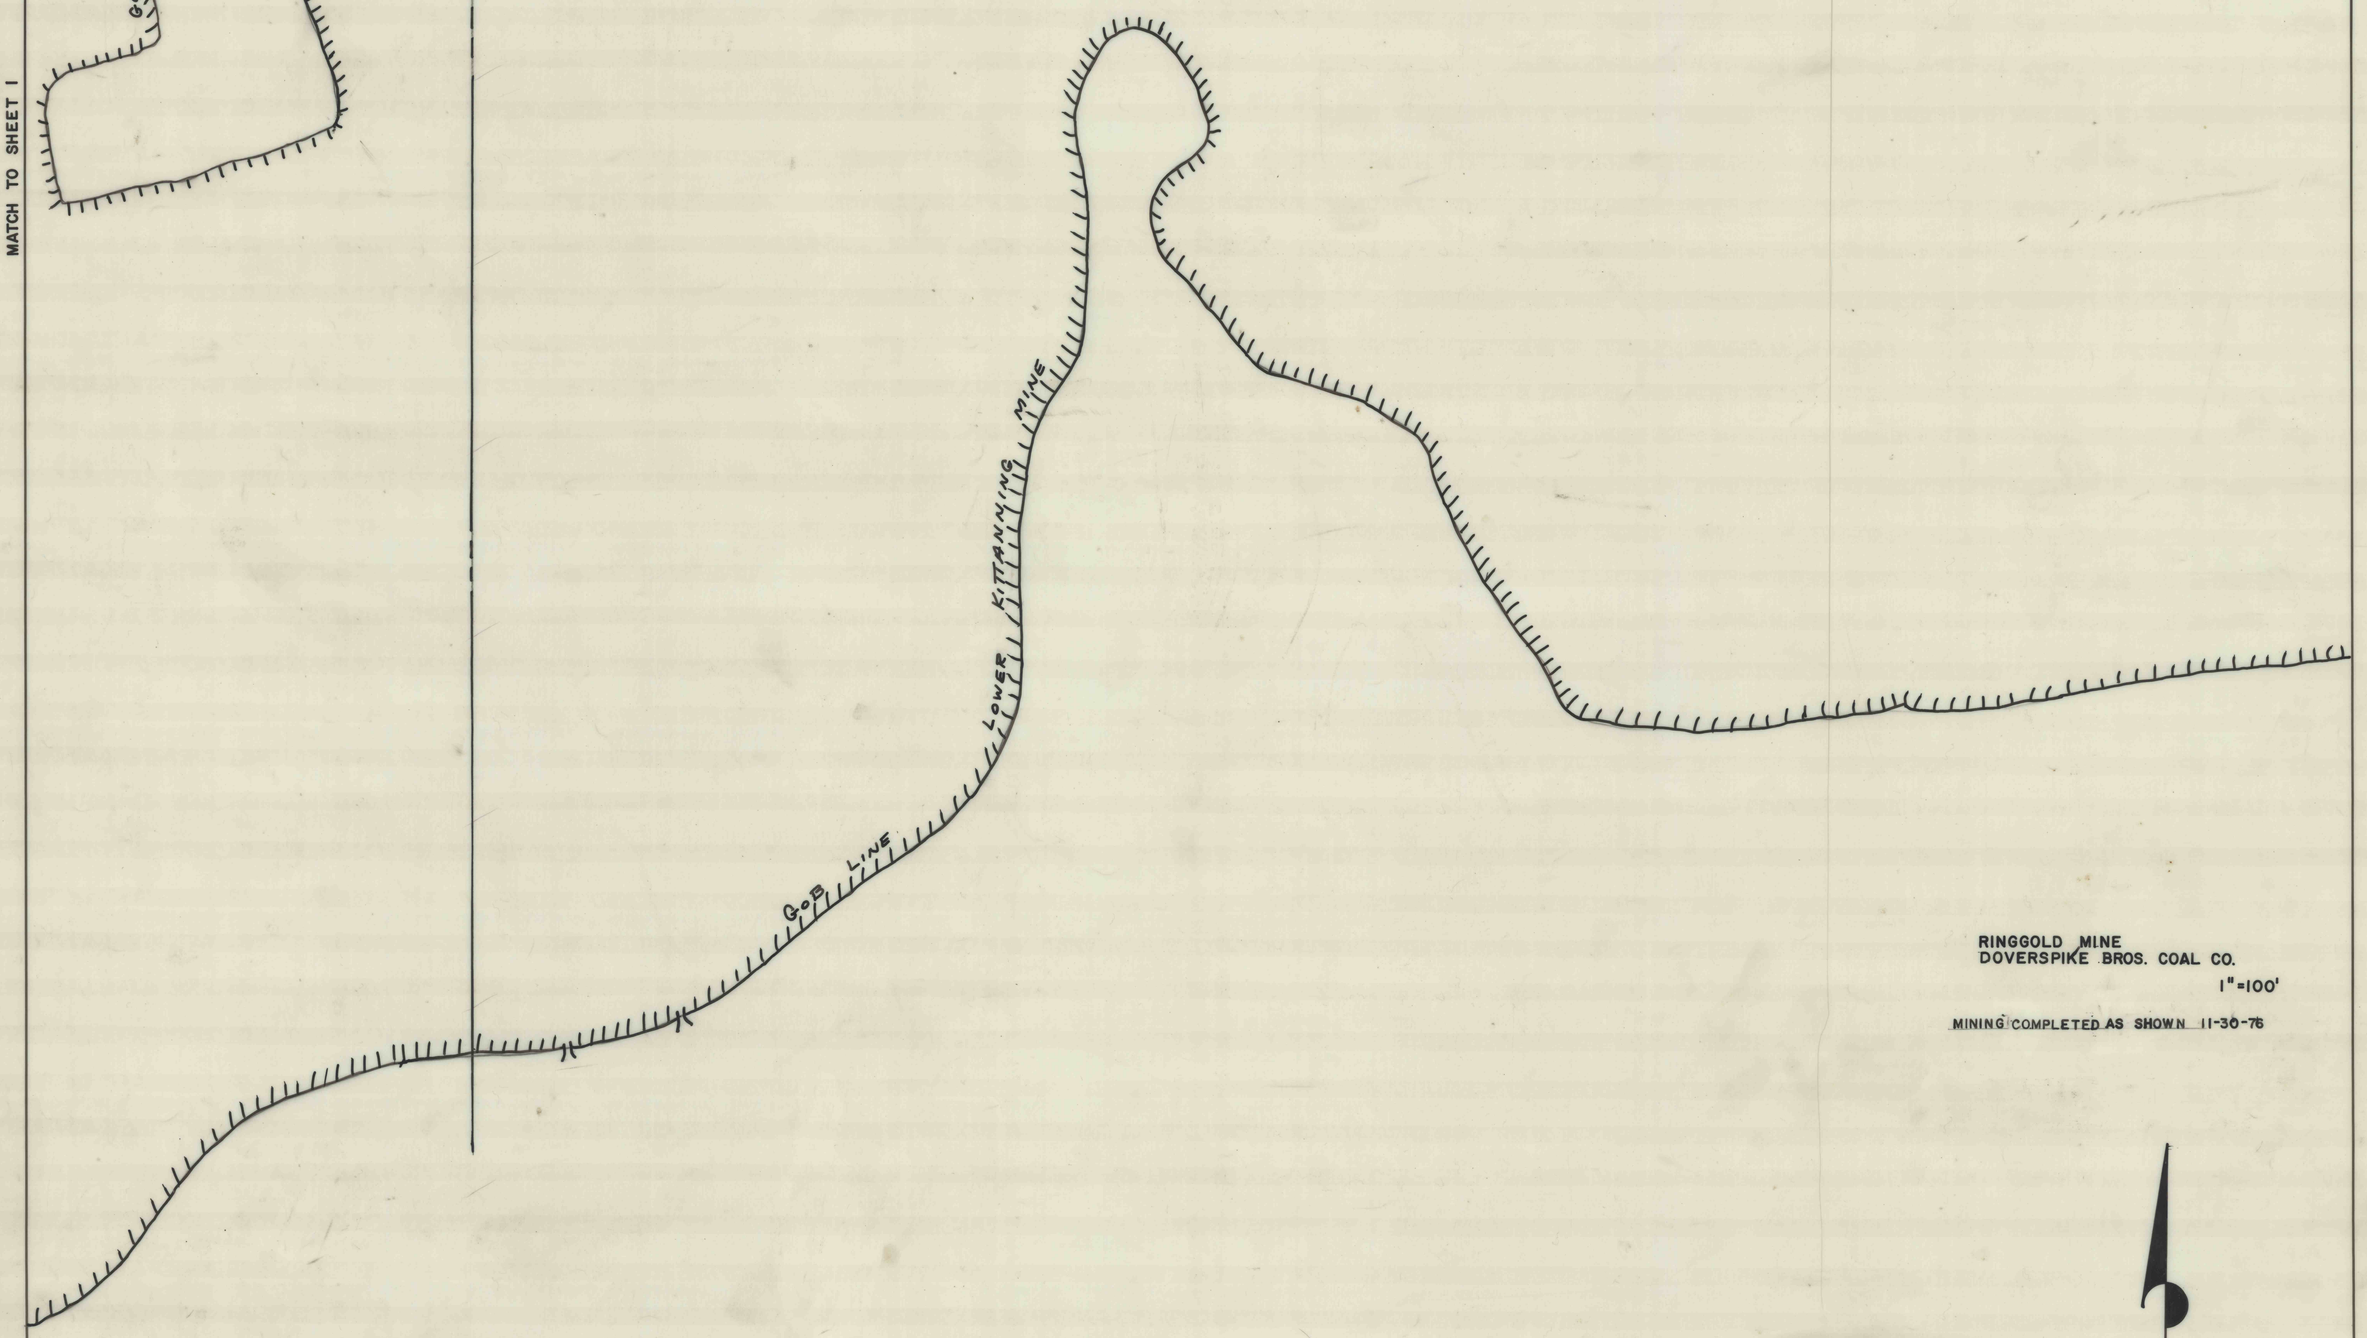

RINGGOLD MINE
DOVERSPIKE BROS. COAL CO.
1"=100'

MINING COMPLETED AS SHOWN 11-30-76

NORTH

SHEET 3