


RINGGOLD MINE
DOVERSPIKE BROS. COAL CO.
MINING COMPLETED AS SHOWN - 11-30-76


NORTH

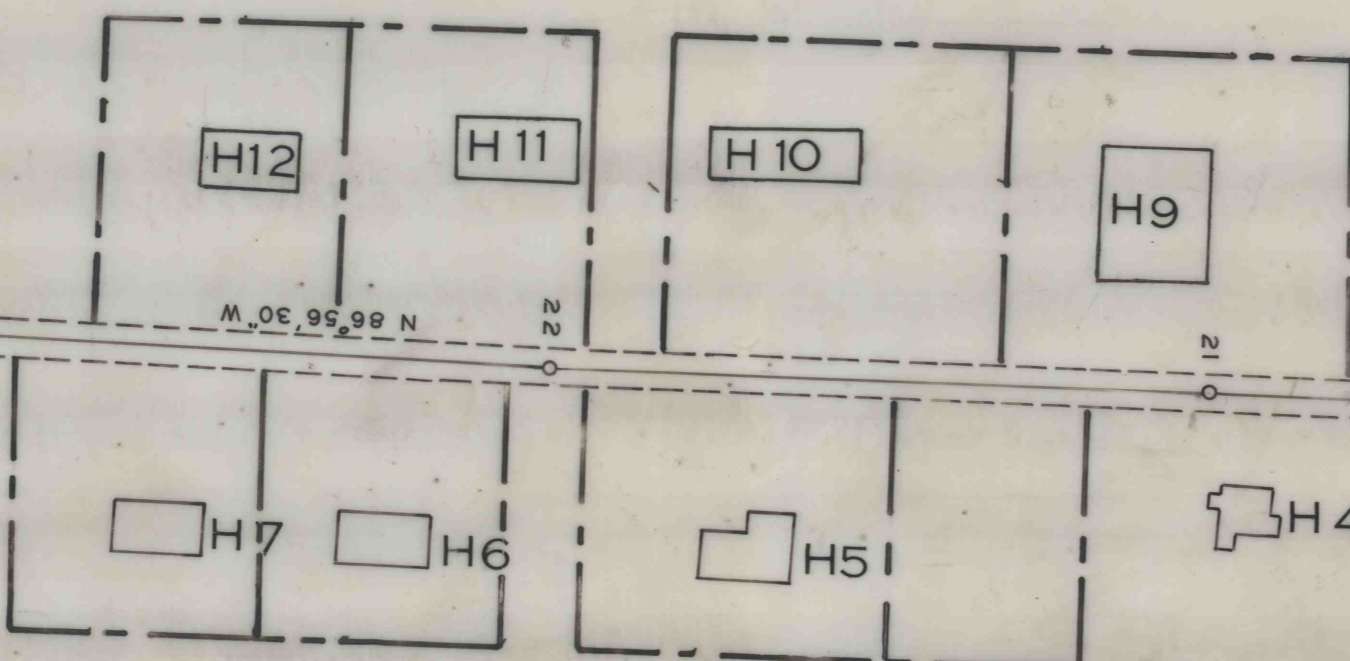


DOVERSPIKE BROS.



DOVERSPIKE BROS.

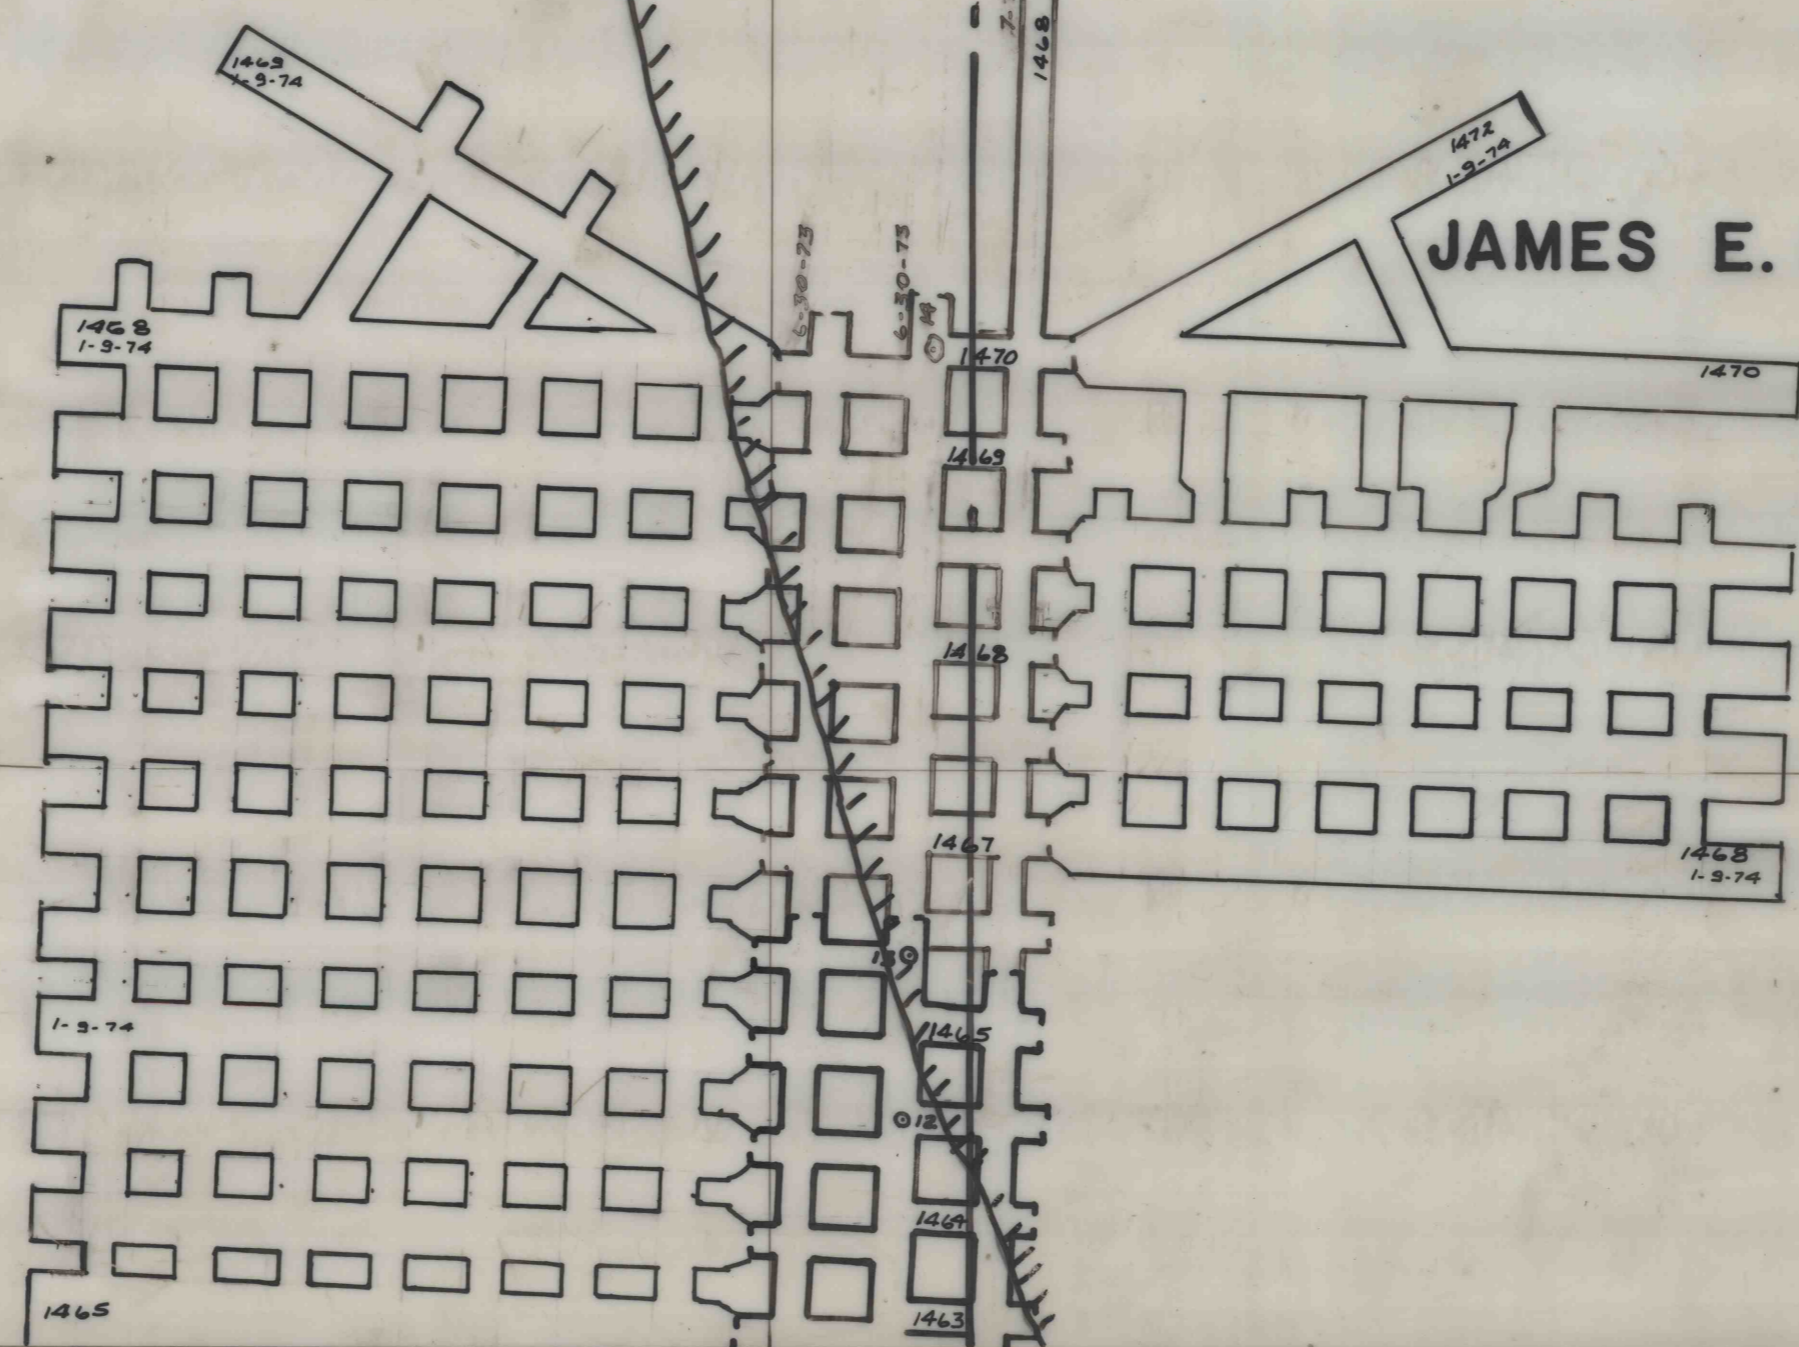

J. I. BULLERS

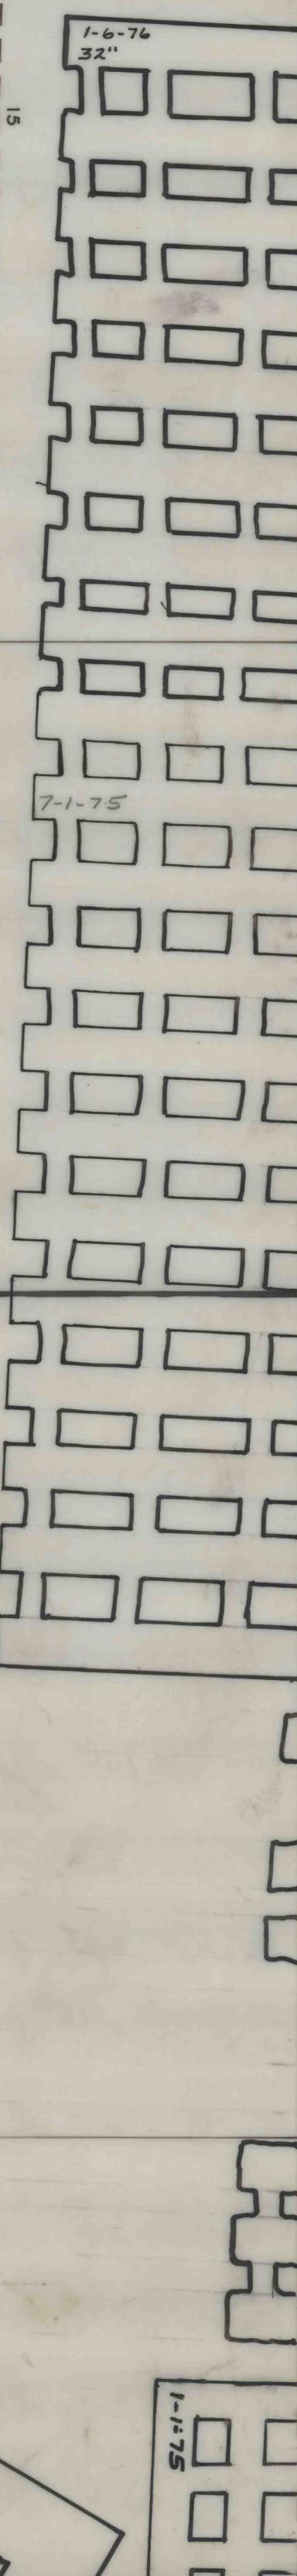

SHEET 2

MATCH LINE

SHEET 1

