


WEST BRANCH BANK & TRUST COMPANY

I. J. WEIGLE

JOSEPH R. HOFFMAN

JOSEPH E. HOFFMAN

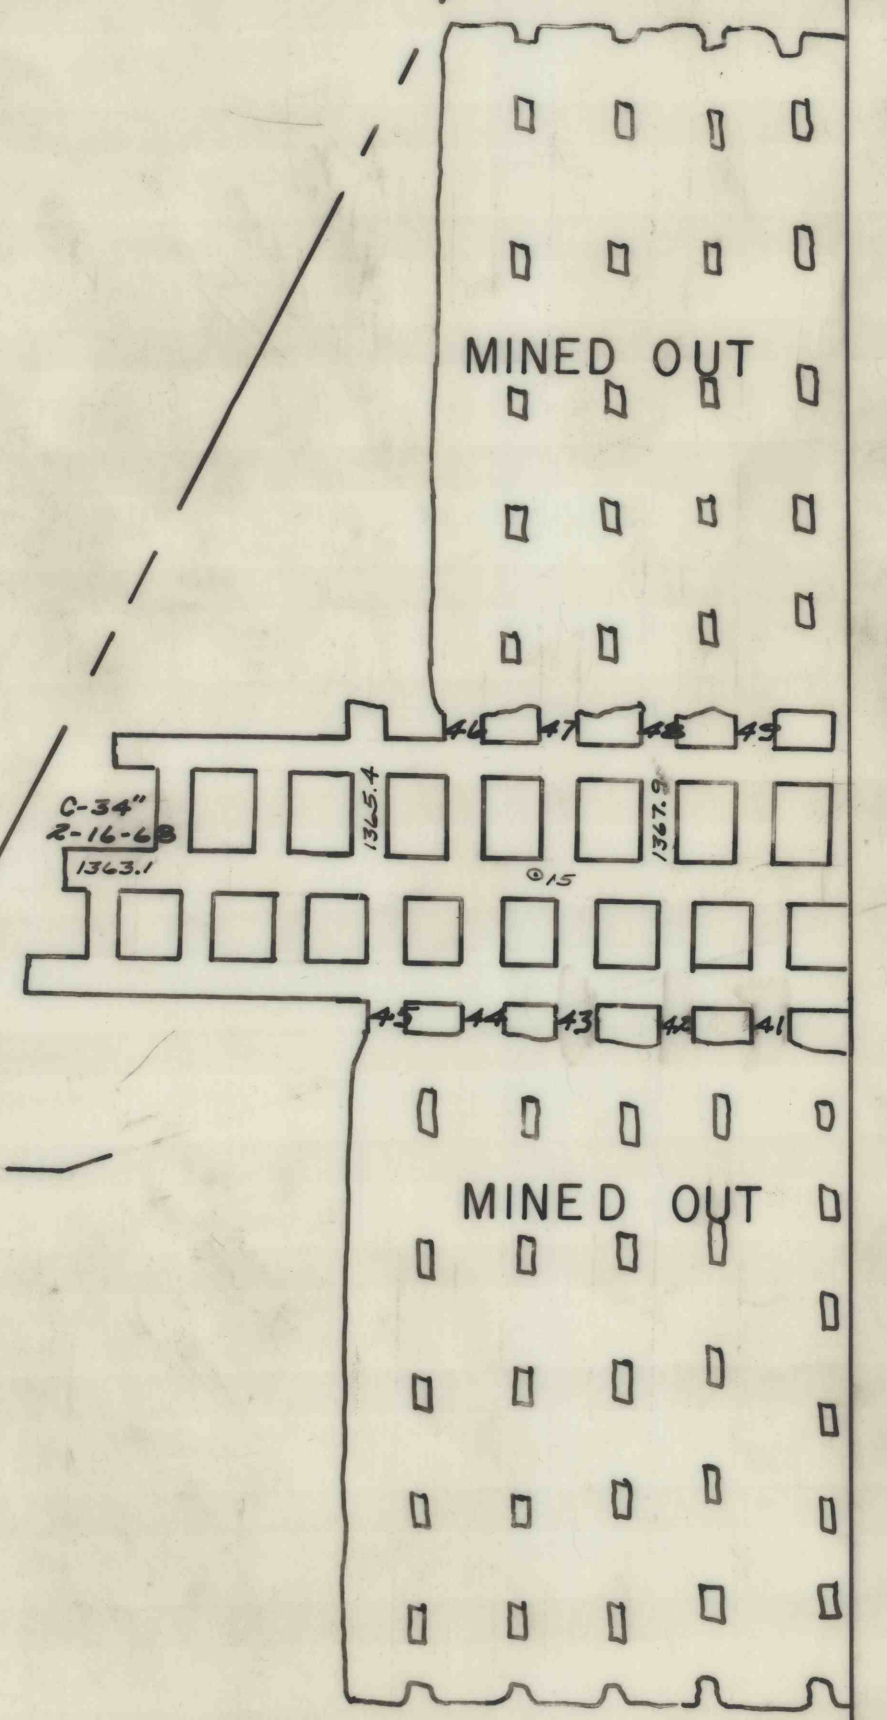

NOTE: all mining is completed on sheet one, as shown.

F. S. RUMBAUGH

MATCH LINE SHEET ONE & TWO