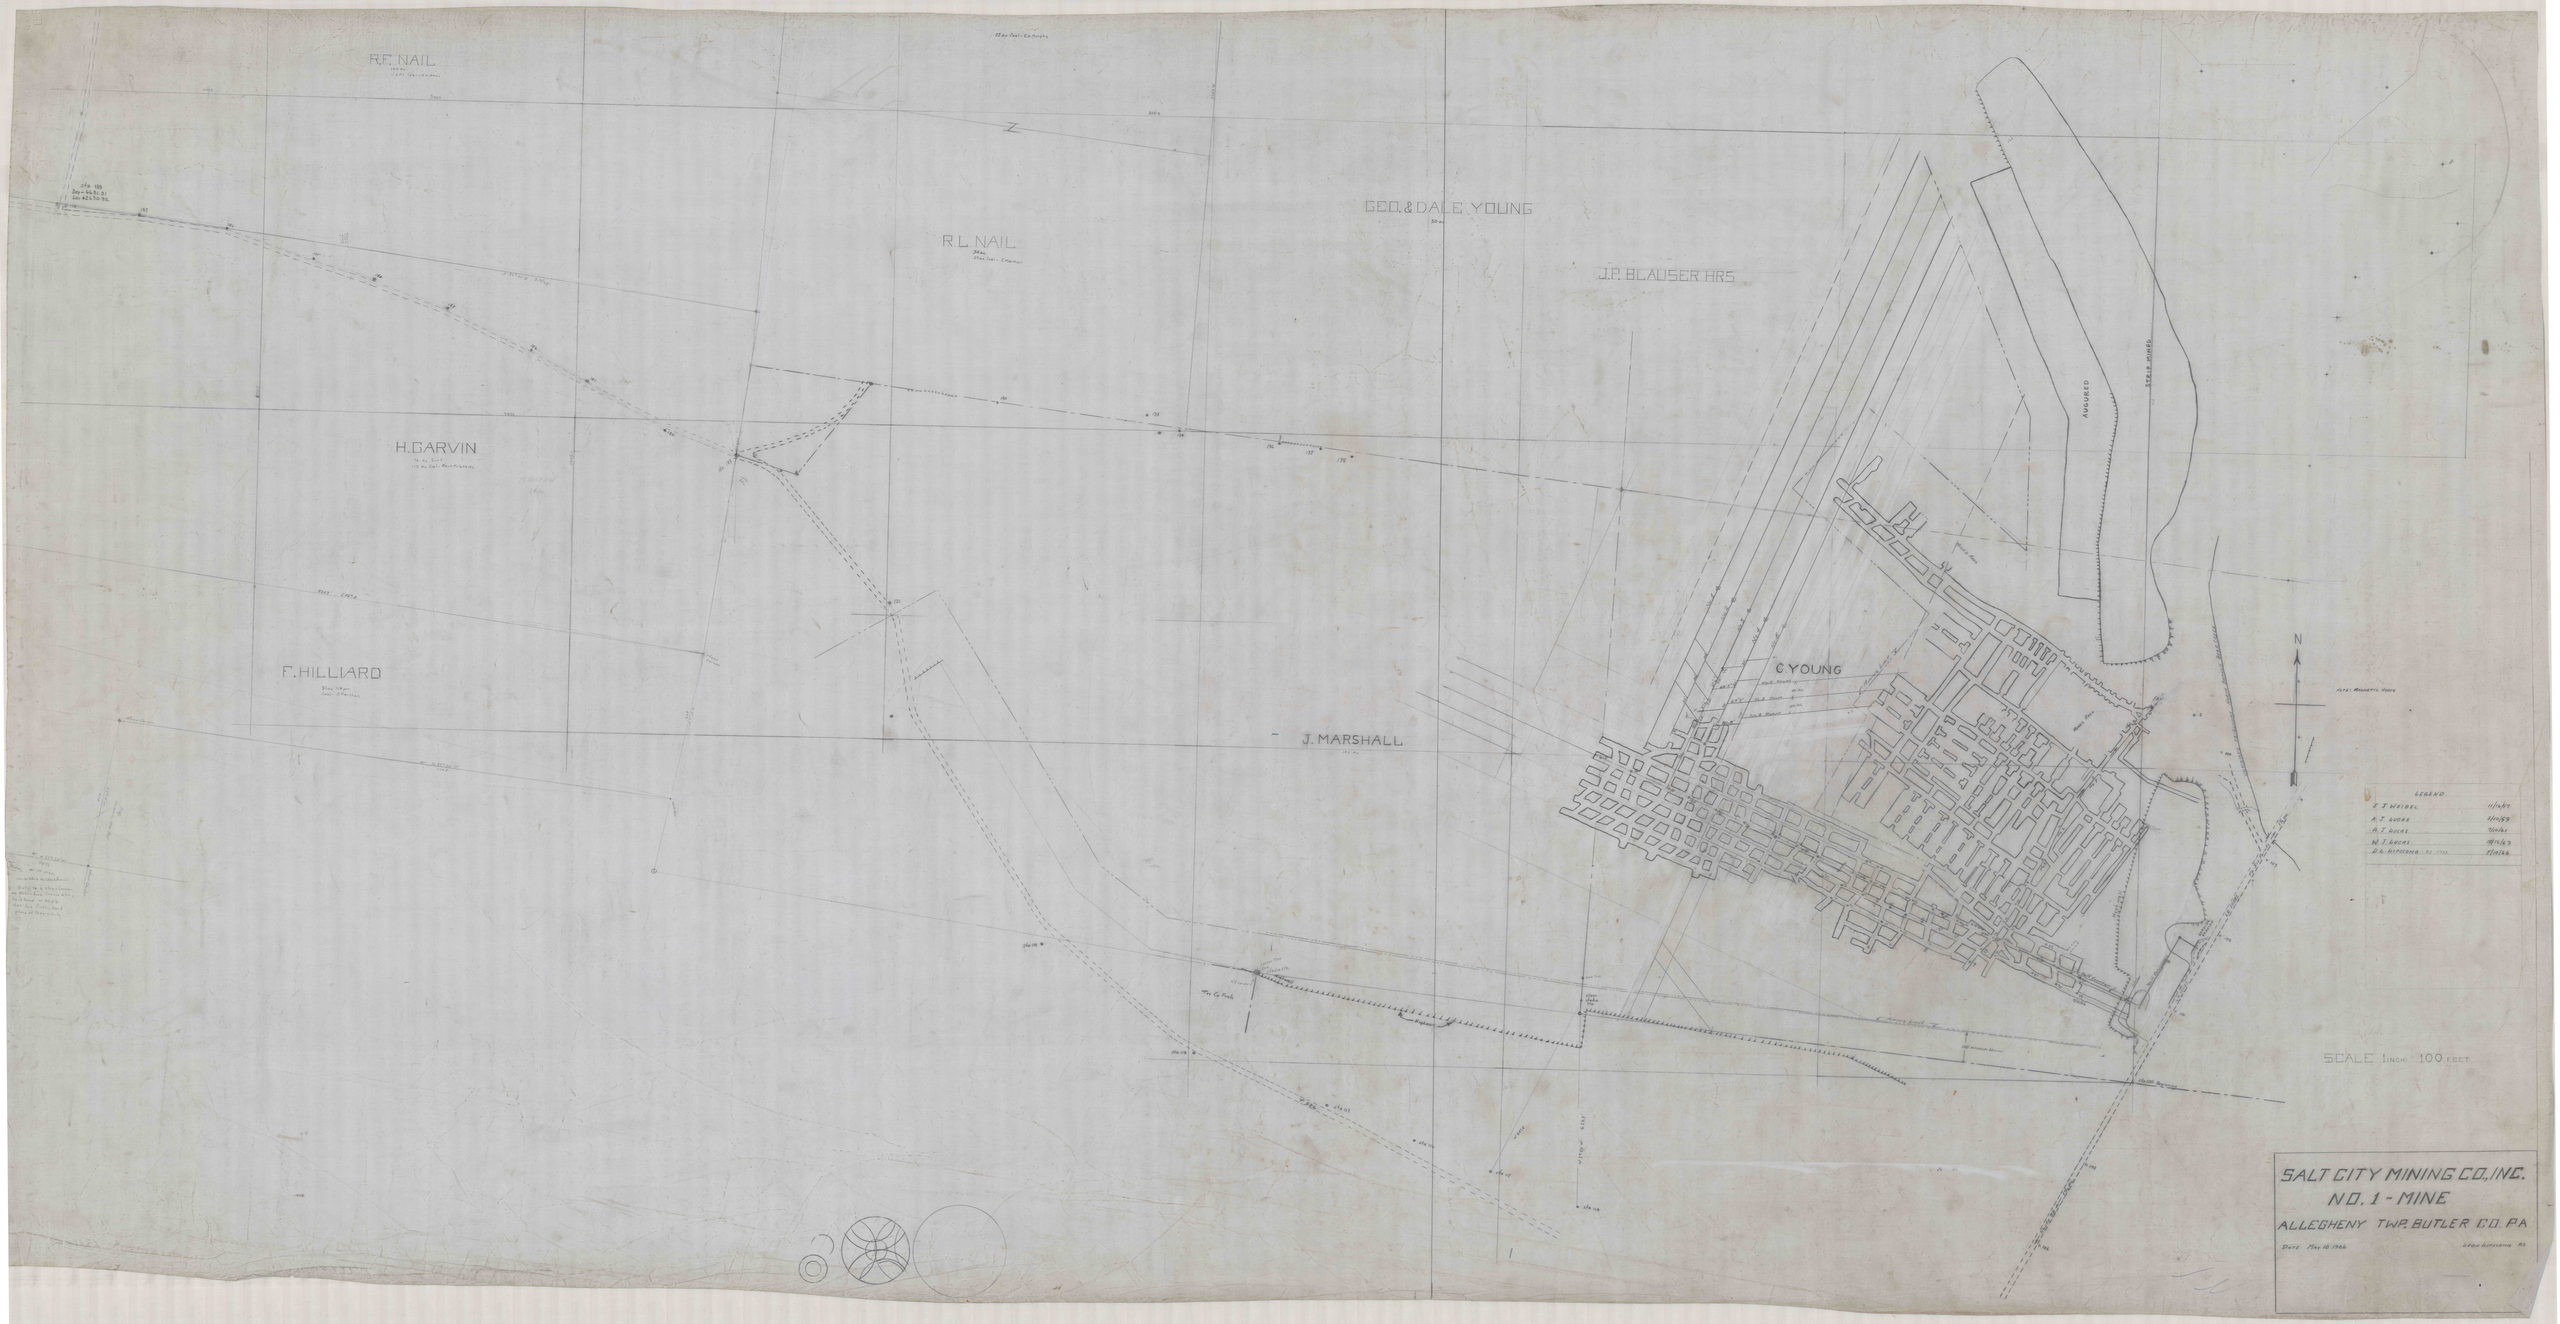
R.F. NAIL
R.L. NAIL
GEO. & DALE YOUNG
J.P. BLAUSER HRS
H. GARVIN
F. HILLIARD
J. MARSHALL
C. YOUNG
AUGURED
N
LEGEND
SCALE 1 INCH = 100 FEET
SALT CITY MINING CO., INC.
NO. 1 - MINE
ALLEGHENY TWP. BUTLER CO. PA