



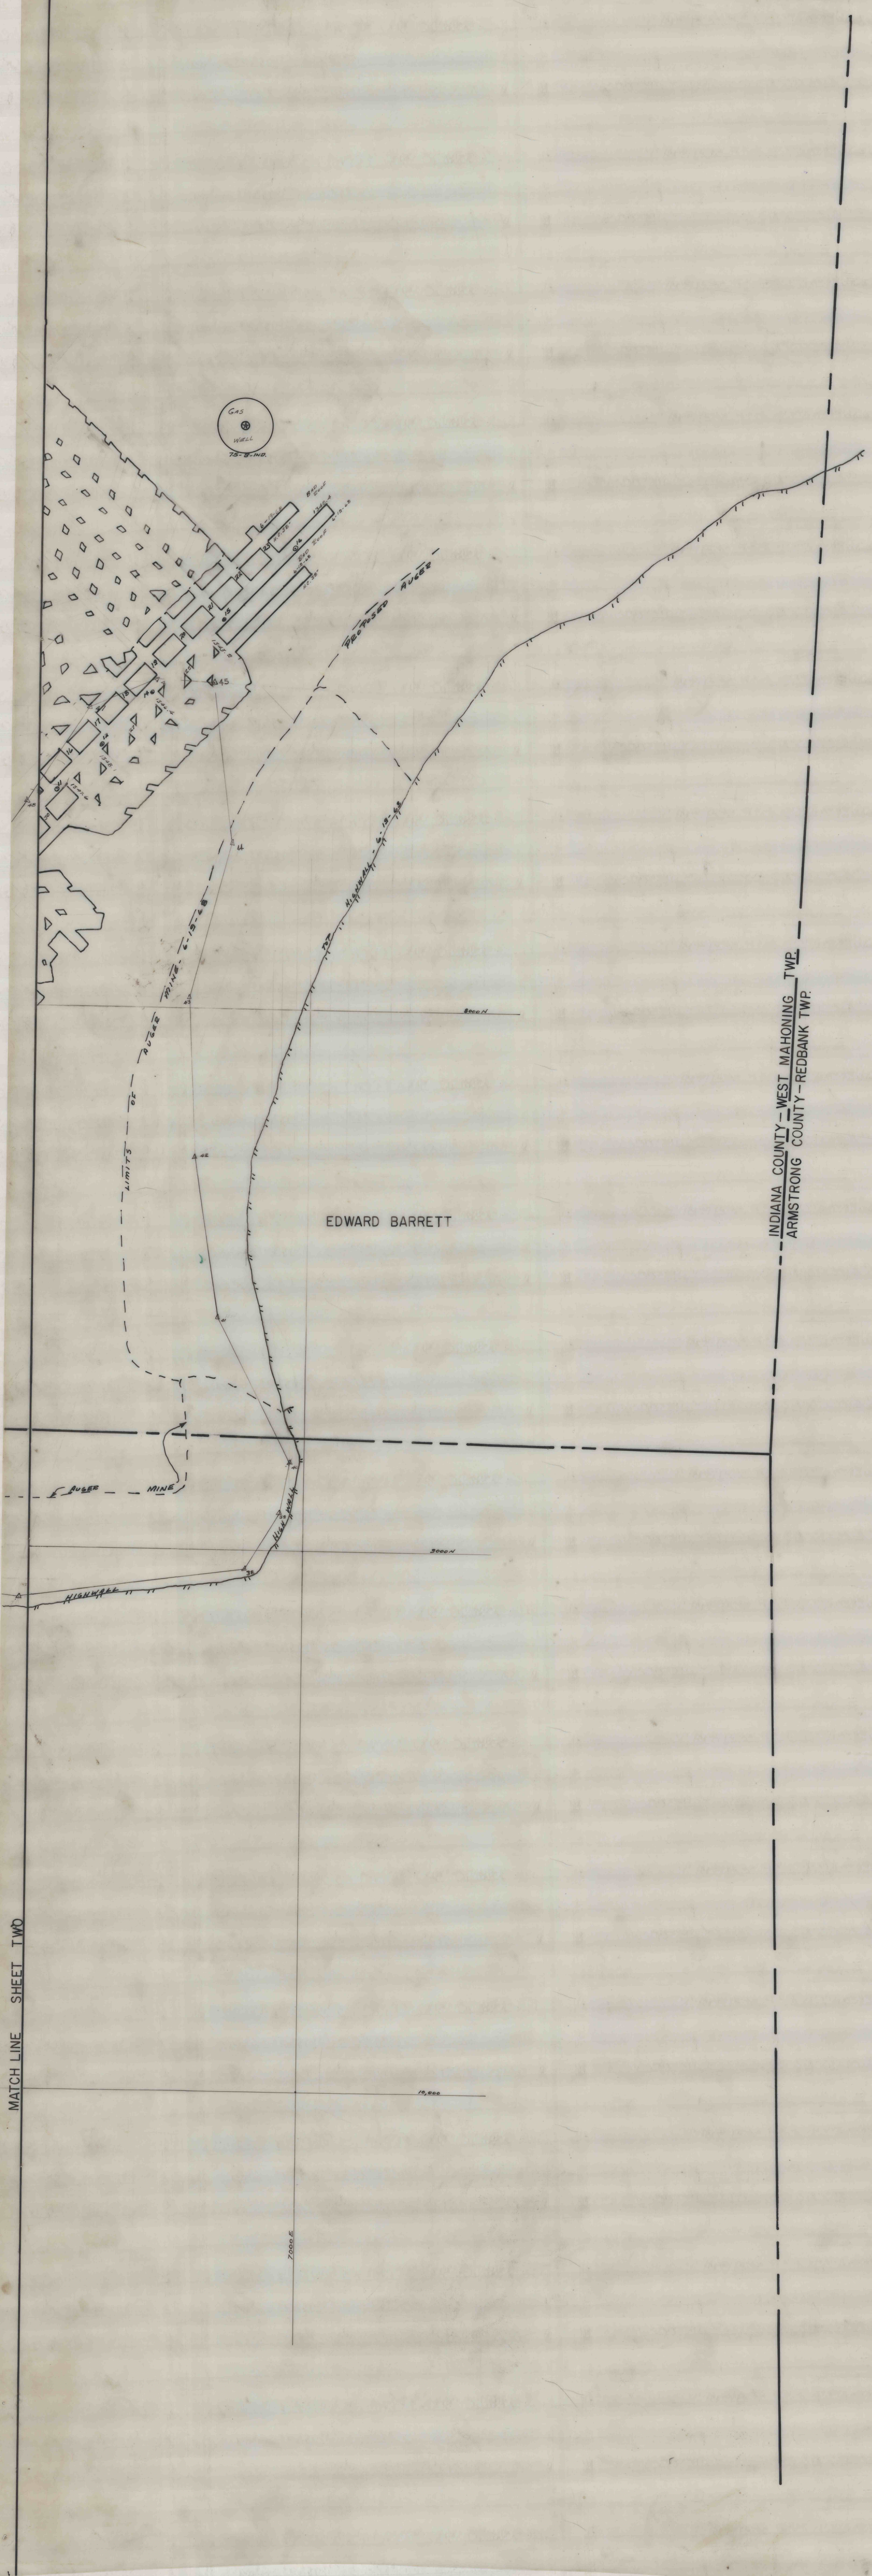

GAS WELL

EDWARD BARRETT

INDIANA COUNTY - WEST MAHONING TWP.  
ARMSTRONG COUNTY - REDBANK TWP.