

11,000 N

10,000 N

9,000 N

8,000 N

11,000 N

10,000 N

9,000 N

8,000 N


PETER TOWNSHIP
WEST MAHONING TOWNSHIP

JEFFERSON COUNTY
INDIANA COUNTY


PETER TOWNSHIP
WEST MAHONING TOWNSHIP

JEFFERSON COUNTY
INDIANA COUNTY

W. A. DRUMMOND

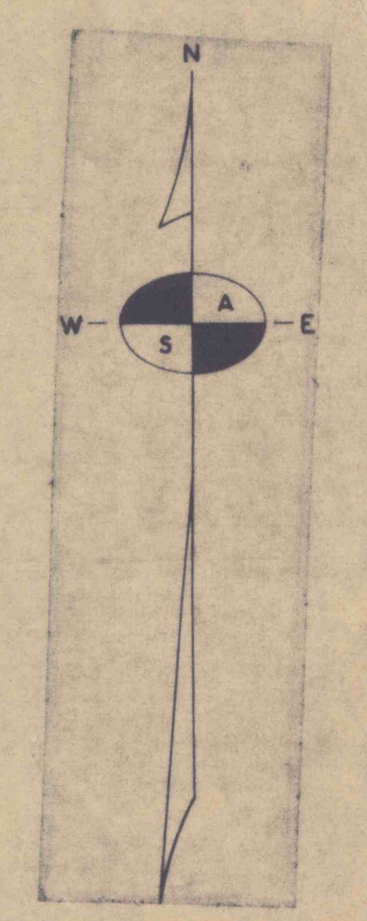

- LEGEND
- A - AUG 27, 1905
 - B - SEPT 24, 1905
 - C - OCT 20, 1905
 - D - DEC. 3, 1905
 - E - JAN. 17, 1906
 - F - FEB. 15, 1906
 - G - MARCH 22, 1906

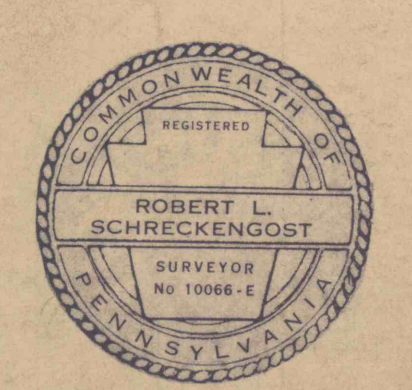

MINE MAP
 DRUMMOND MINE
 RINGOLD MINE, INC.
 WEST MAHONING TWP., INDIANA COUNTY, PA.
 PETER TWP., JEFFERSON COUNTY, PA.
 R. B. SHANNON & ASSOCIATES KITTANNING, PA.
 DRAWN BY W. E. DATE SEPT 1945
 SCALE 1"=100 FEET DRAWING NO. F-265
 SHEET No. 1

ED DRUMMOND

RINGOLD MINES, INC.
DRUMMOND MINE
SHEET No. 1
F-265

SEE SHEET No. 2