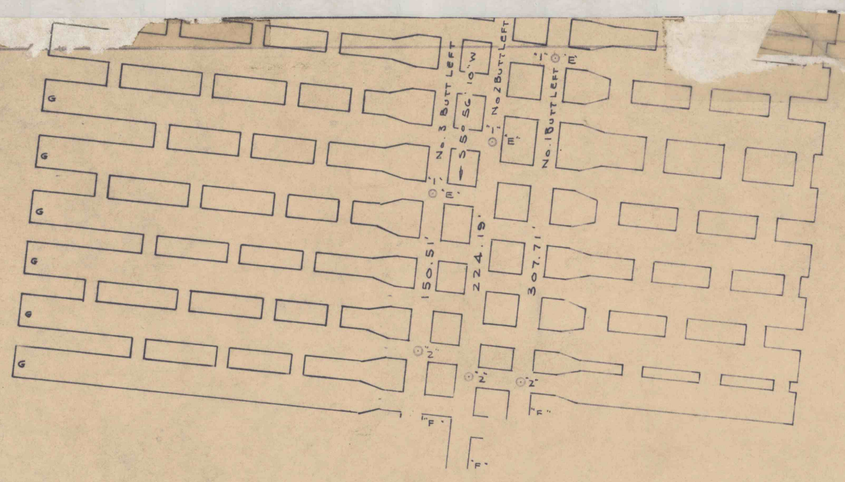

8,000 N

7,000 N

6,000 N

5,000 N

11,000 E

12,000 E

13,000 E

RINGGOLD MINES, INC.
DRUMMOND MINE

SHEET No. 2
F-255