


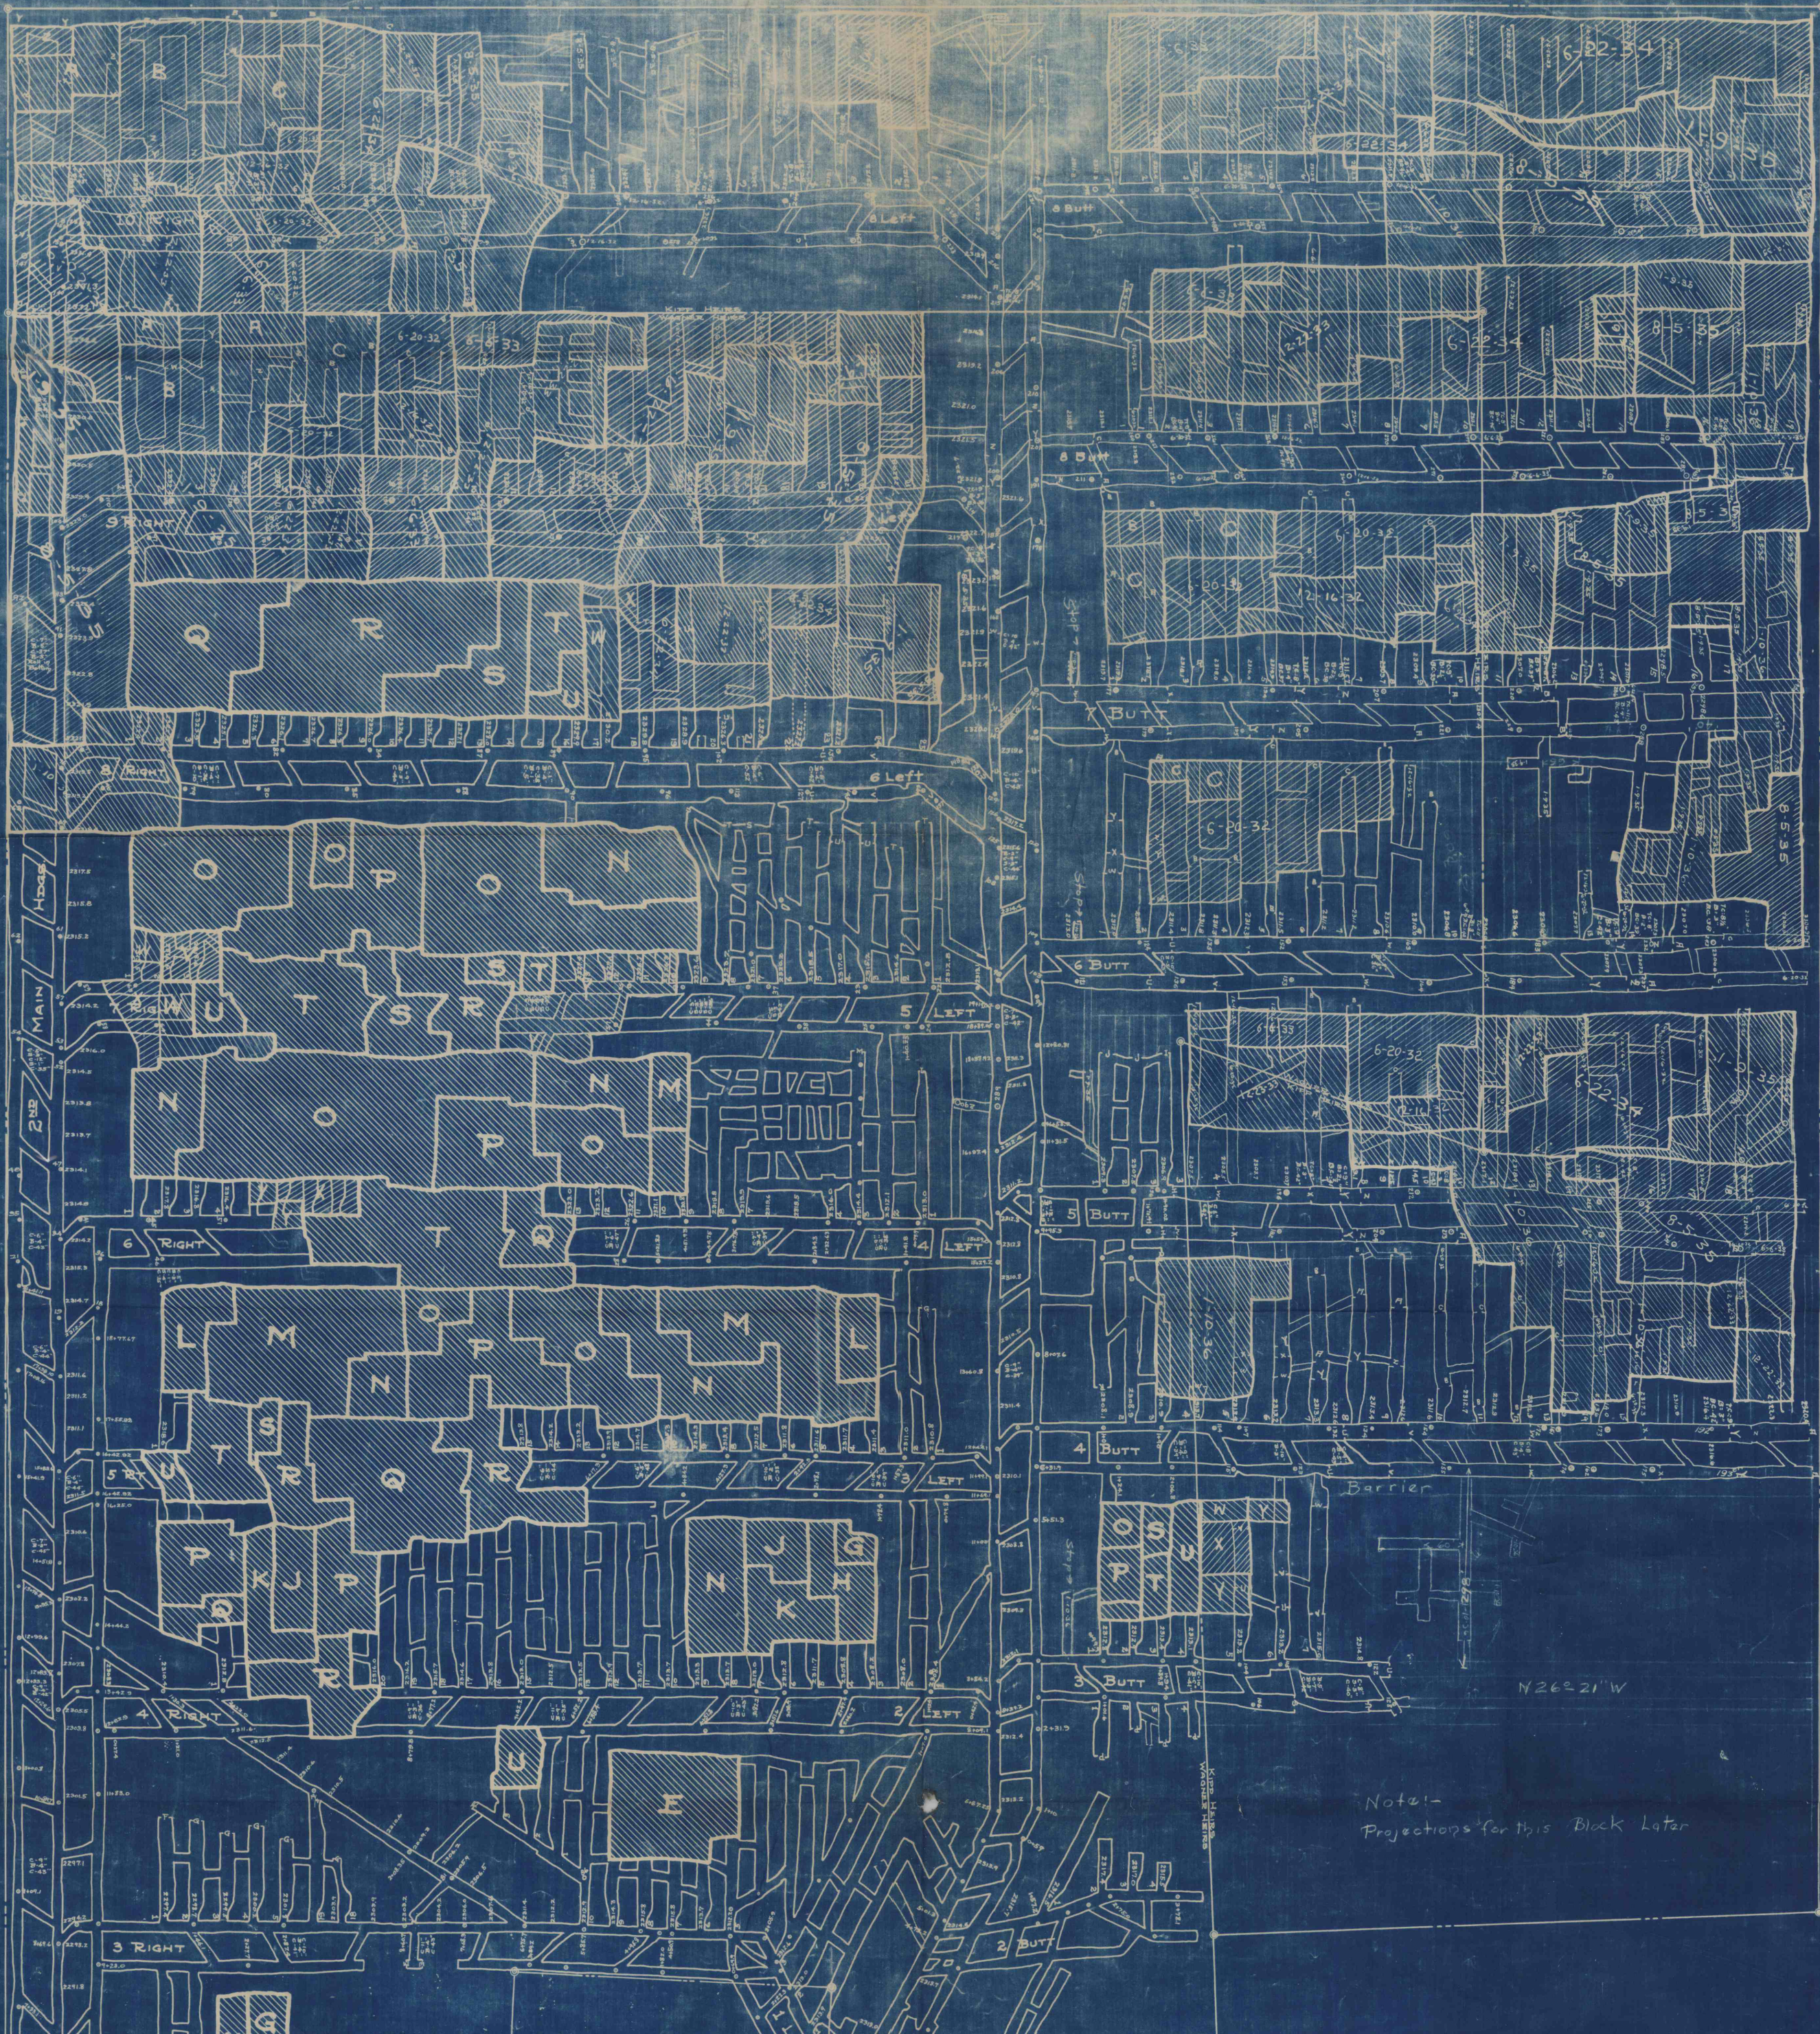

Note:-
Projections for this Block Later