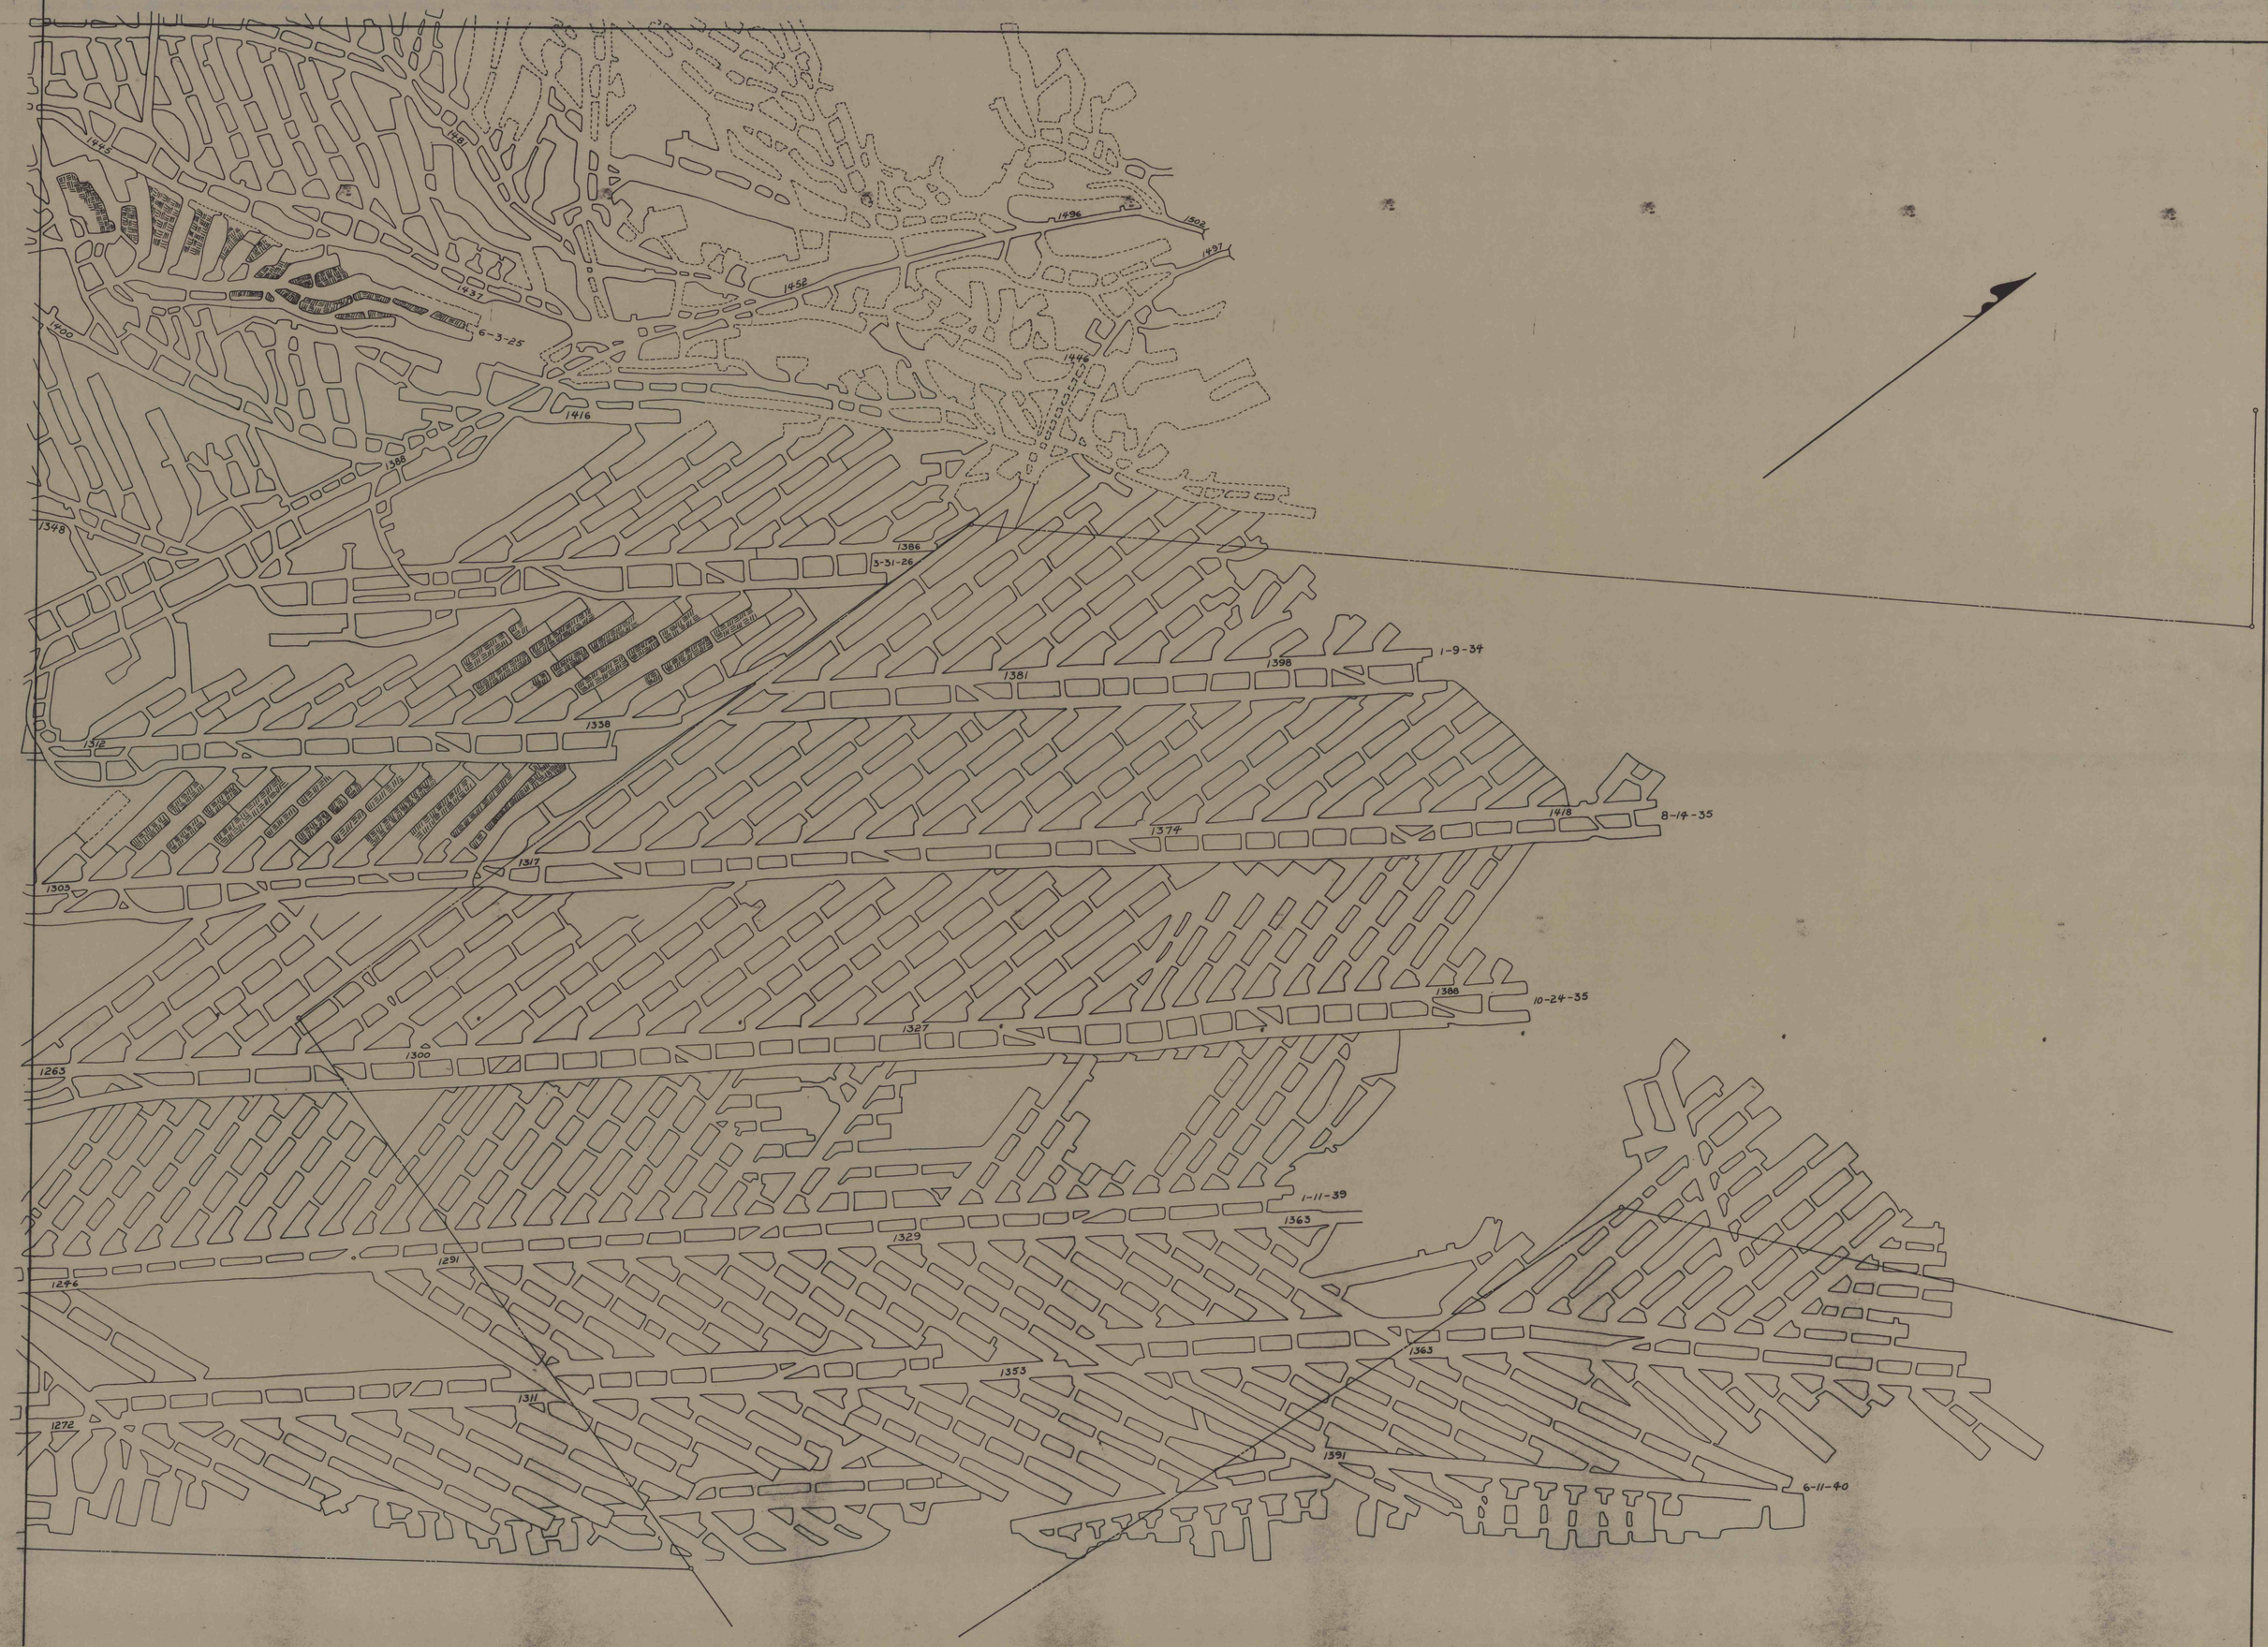
1445
1481
1496
1508
1497
1437
1452
1400
6-3-25
1446
1416
1368
1348
1386
5-31-26
1-9-34
1398
1381
1338
1312
1418
8-14-35
1374
1317
1303
1388
10-24-35
1327
1300
1263
1-11-39
1363
1329
1291
1246
1363
1353
1311
1272
1391
6-11-40