
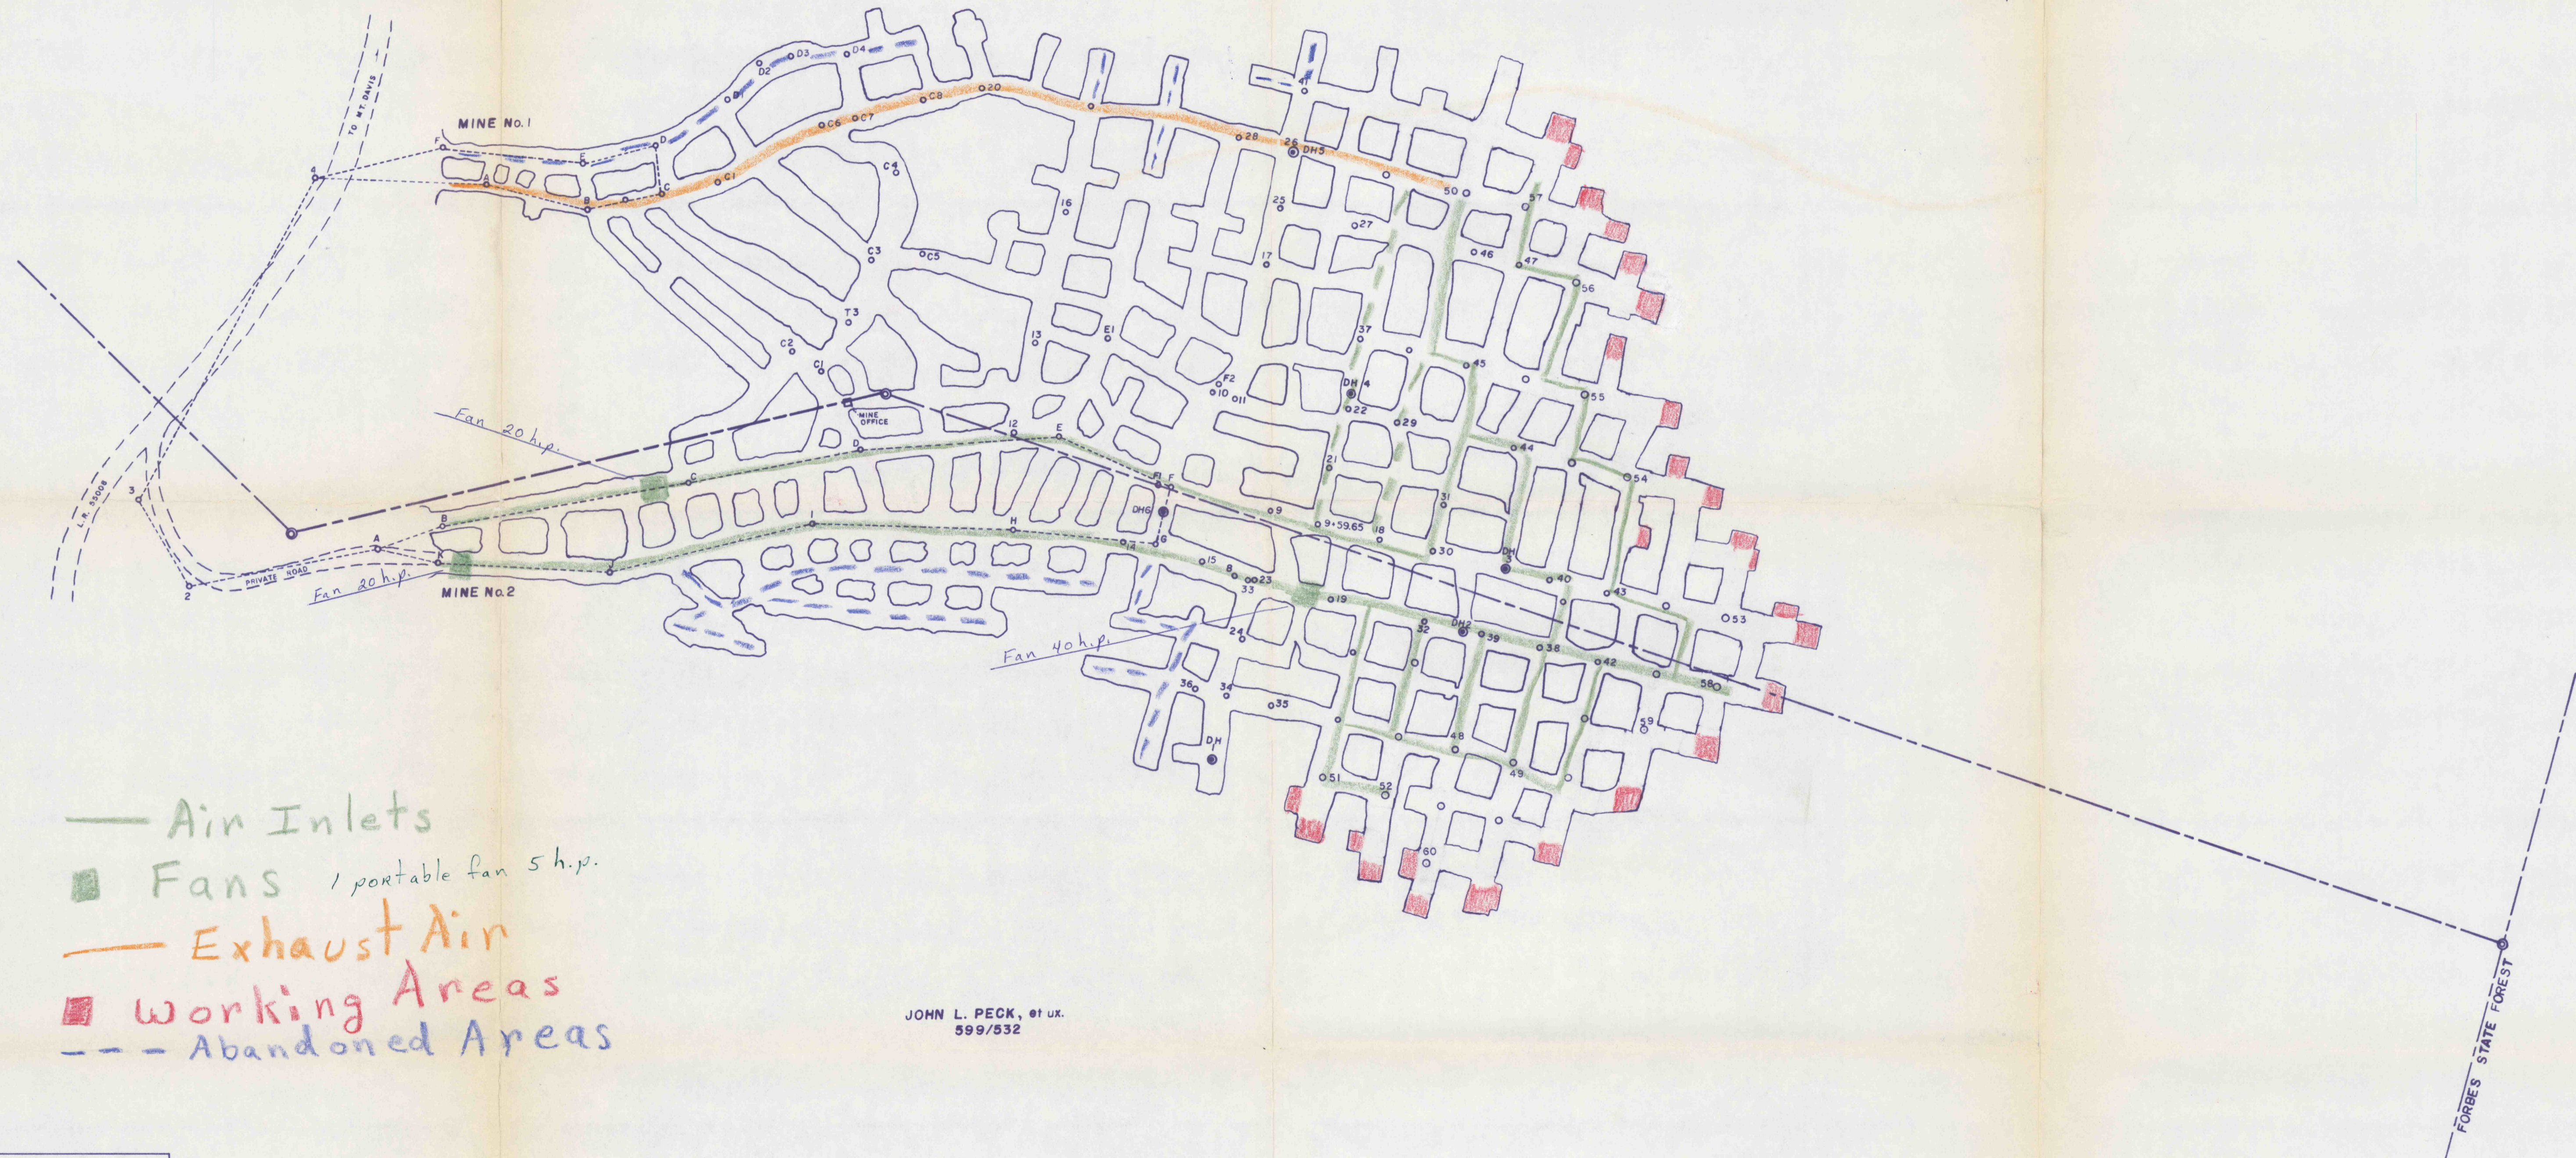


YOUNG MENS CHRISTIAN ASSOCIATION
of
PITTSBURGH, PENNSYLVANIA
451/214

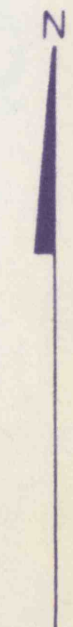

JOHN L. PECK, et ux.
599/532

PLAN OF

Keystone Lime Company, Inc.
Limestone Deep Mine

Location—Eik Lick Township, Somerset
County, Pennsylvania

Date—Sur. B.E.M. 12/6/77
Dwg. KEY. 12/6/77 Scale 1"=100'

- property corner
- proposed drill hole

Blaine E. Miller, Surveyor
Spirings, Pa. 15562

REVISIONS		
1. Revised	12/28/78	M. J. M.
2. Revised	12/18/79	M. J. M.
3.	1/26/81	B. E. M.
4.	2/15/82	B. E. M.
5.	2/7/83	B. E. M.
6.	1/27/84	M. J. M.

