



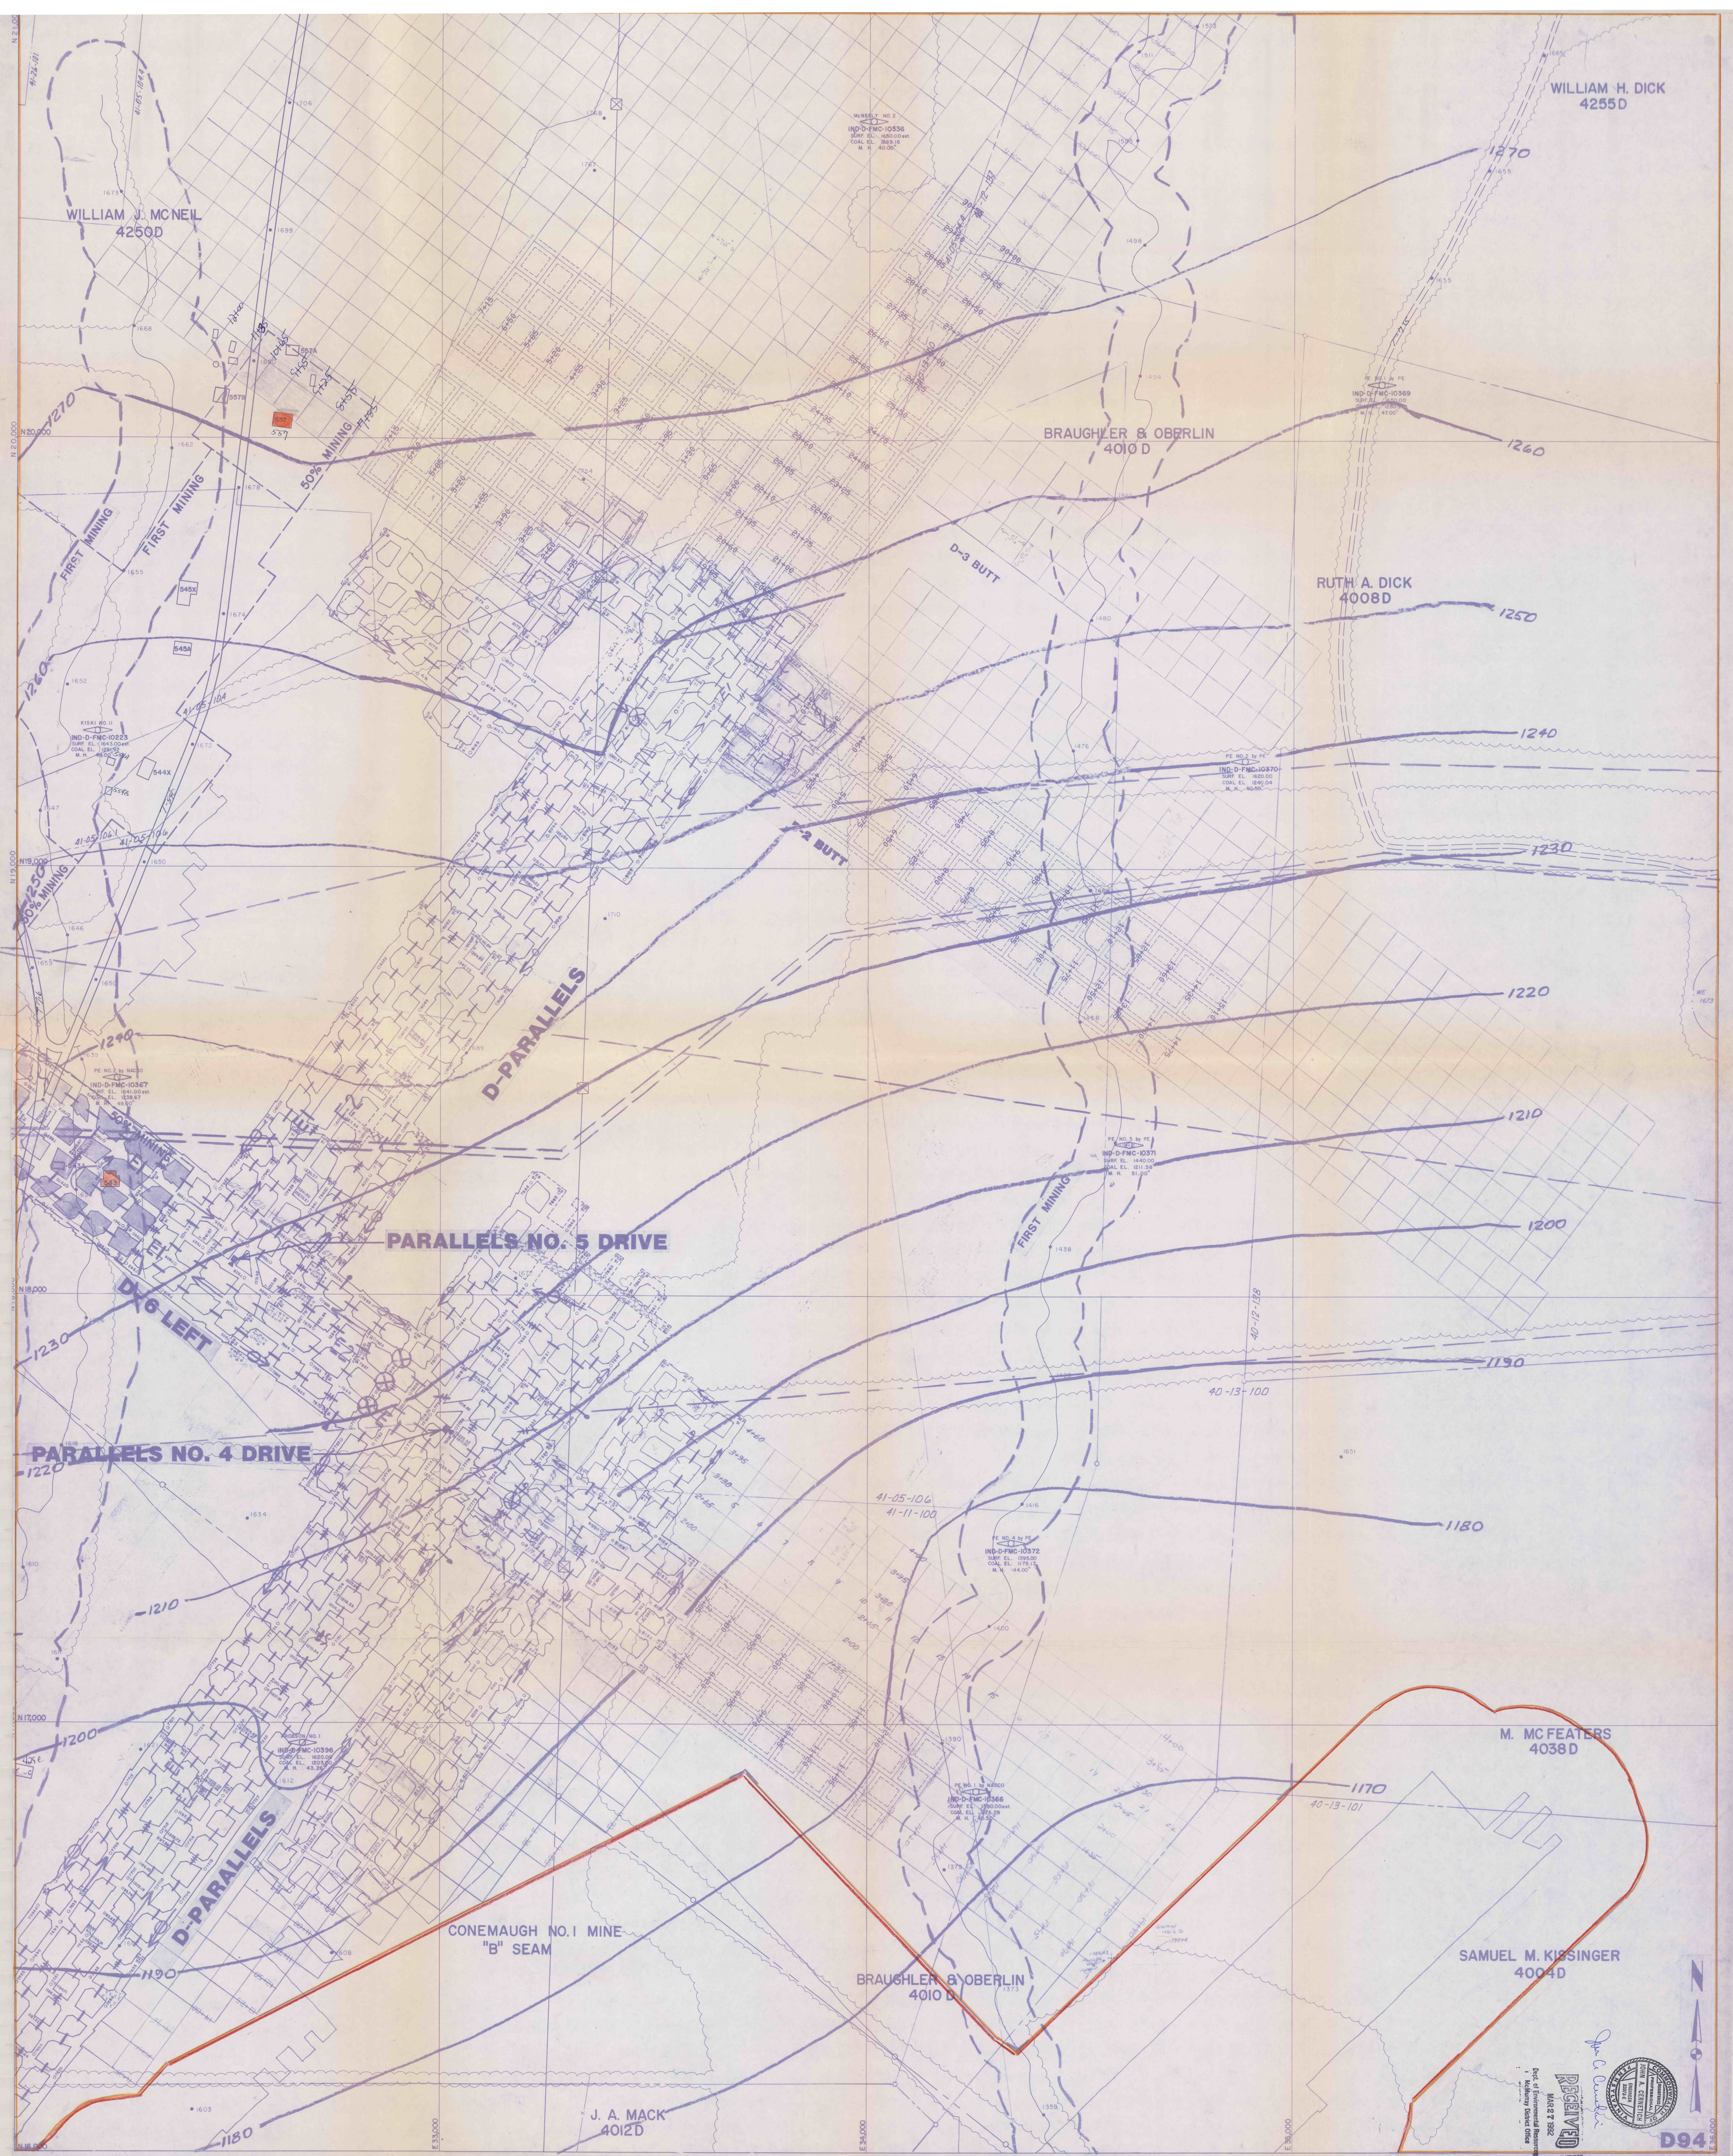

GREENHORNE & O'MARA, INC.
ENGINEERS, ARCHITECTS, PLANNERS
SURVEYORS, PHOTOGRAMMETRISTS
3031 KIMMISTON RD., GREENSBURG, INDIANA 46240
ONE TRIANGLE DR., EXPORT, PA.

3/1/92 TO 9/1/92
Continued Mining

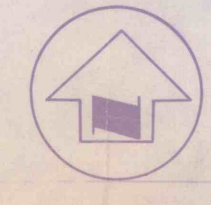


TRACING

POSTED
10/31/91

SHEET INDEX

THE FLORENCE MINING COMPANY
UPPER FREEPORT "1" SEAM, LOWER FREEPORT "2" SEAM
WEST WHEATFIELD TOWNSHIP
INDIANA COUNTY
PERMIT NO. 22831308
SCALE: 1"=100'

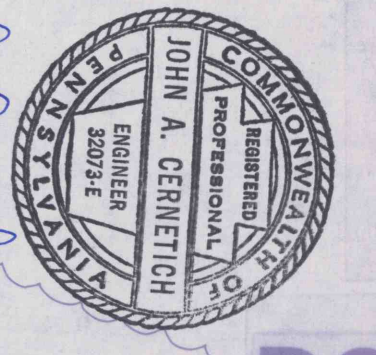

D94