


21

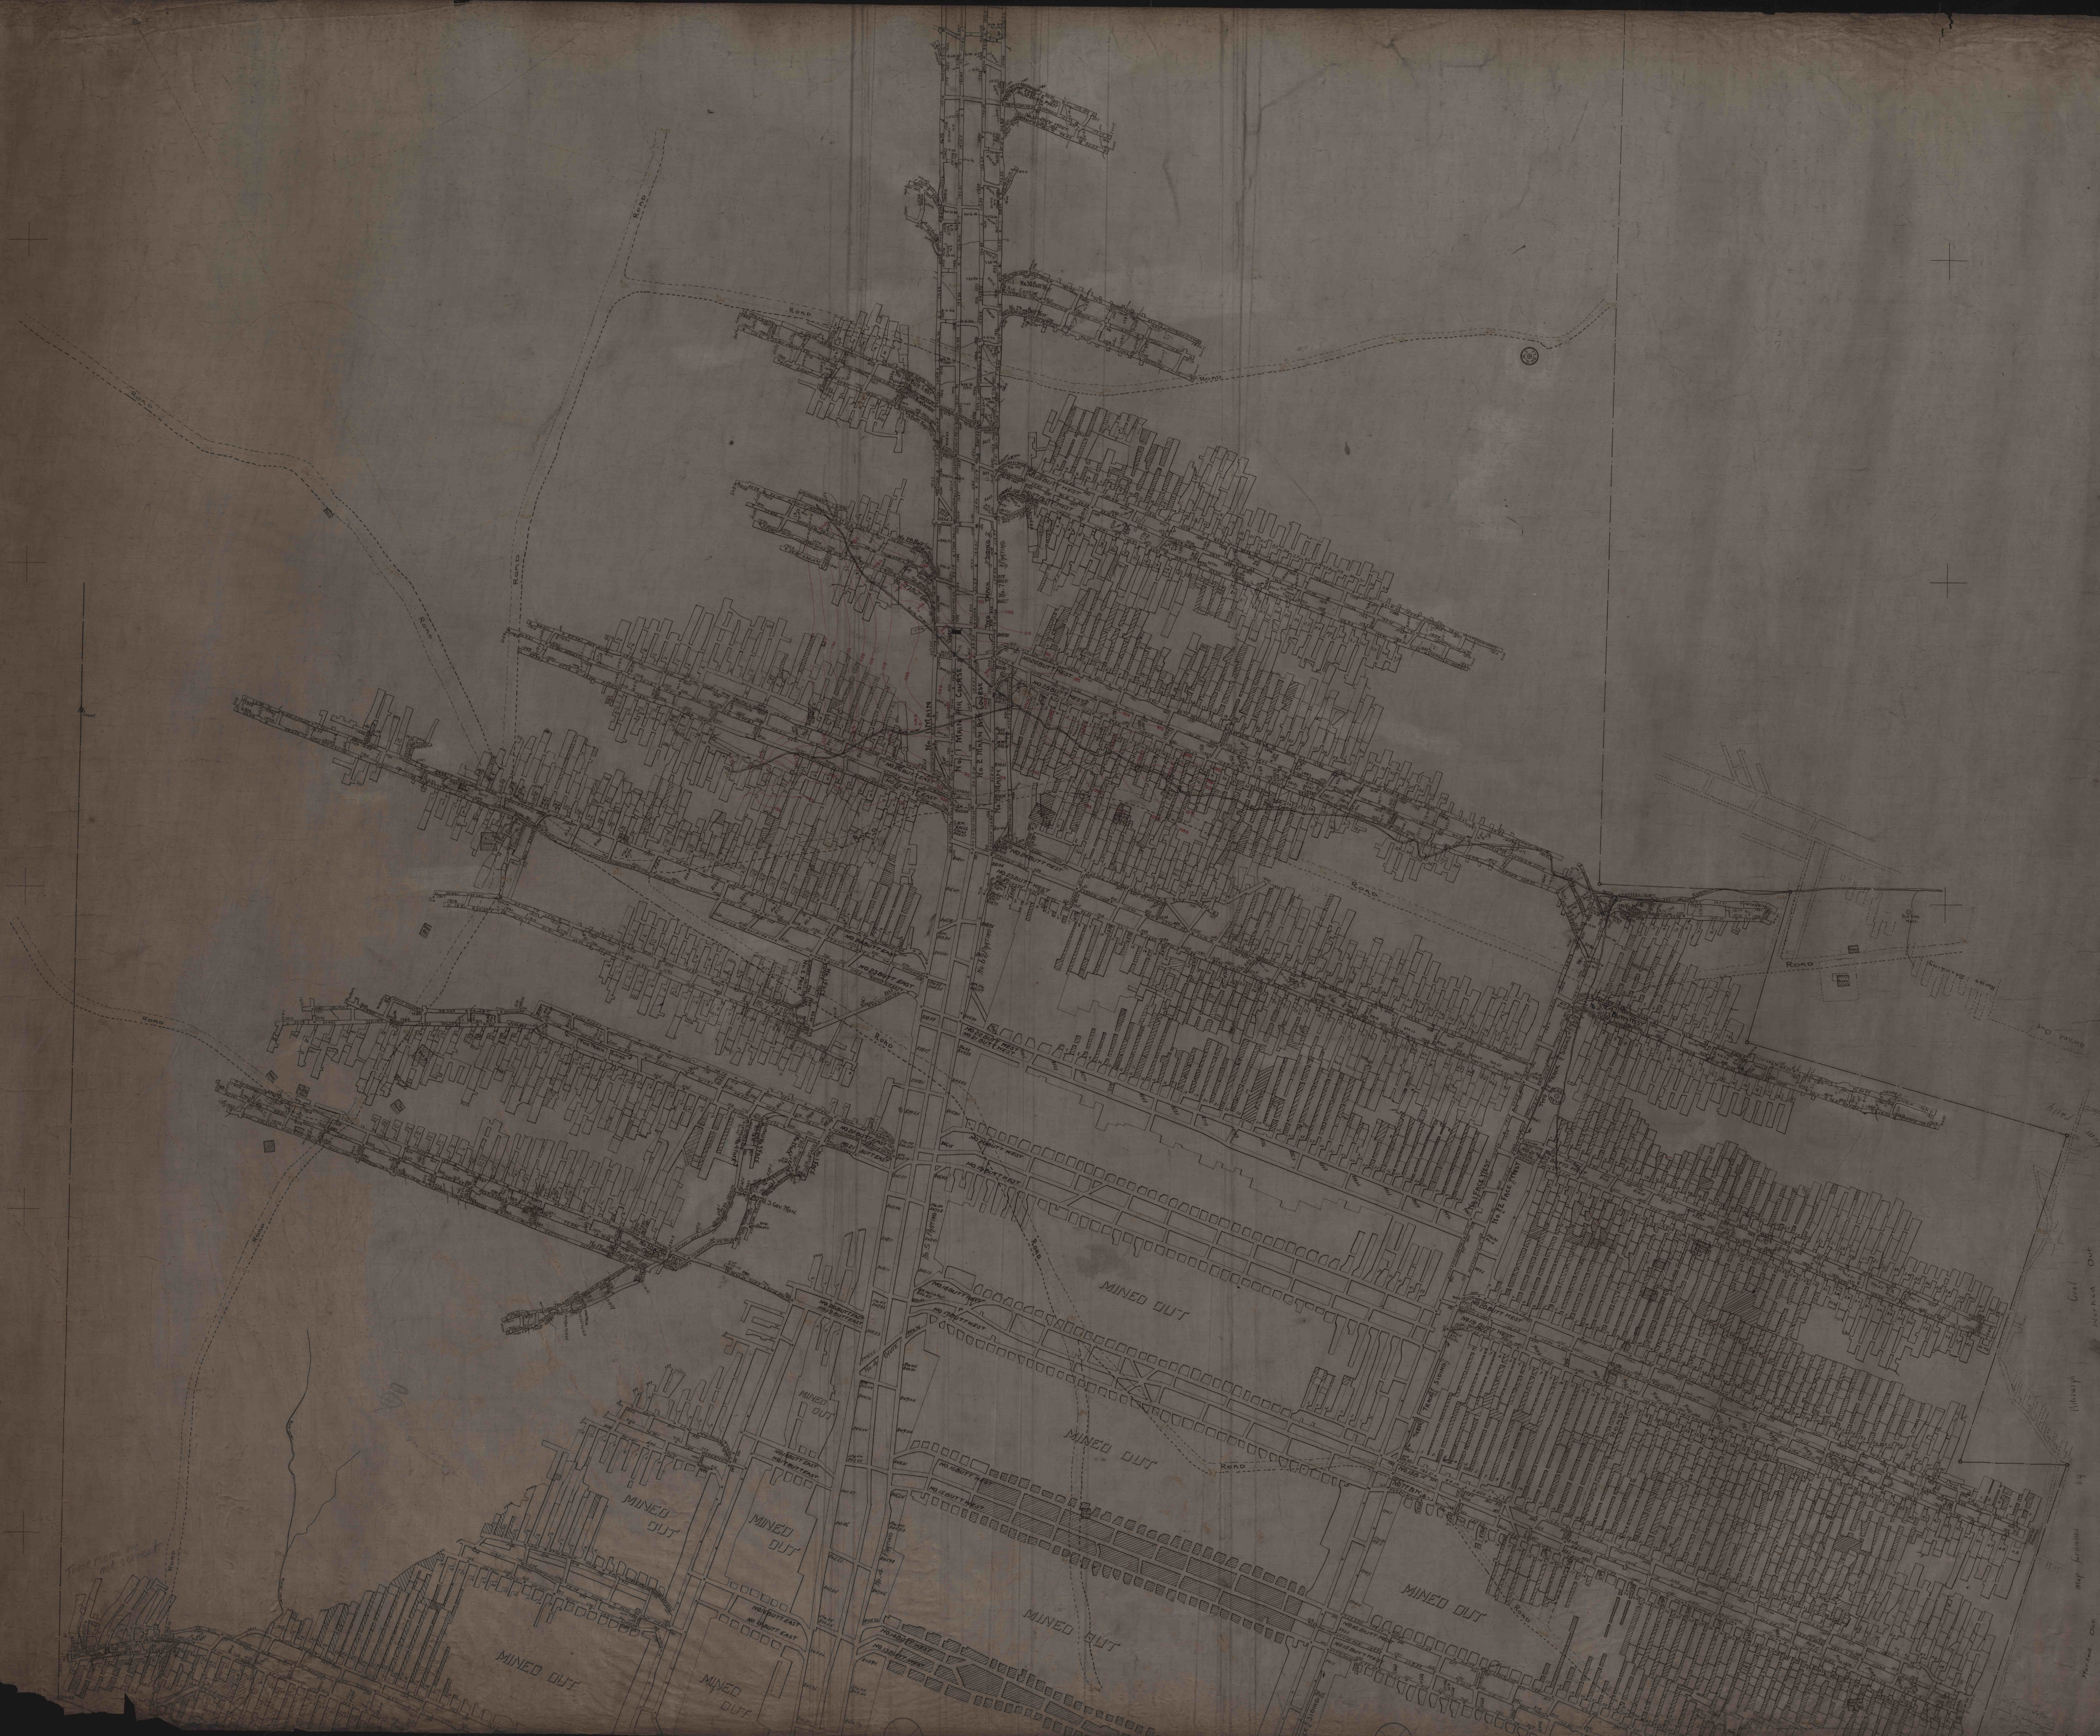

Used
North
Out
by
map
North
One