


Dist. of Survey	
A	4-15-09
B	7-21-09
C	9-21-09
D	10-30-09
E	3-20-10
F	6-10-10

Cod Co. Property
Pittsburg

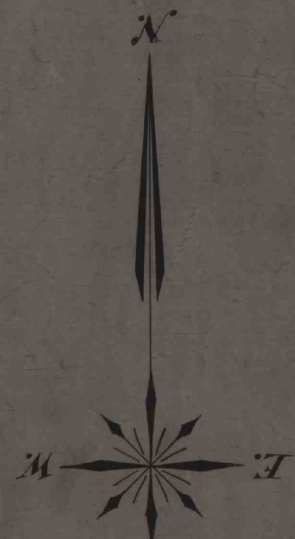

Pittsburg Coal Co.