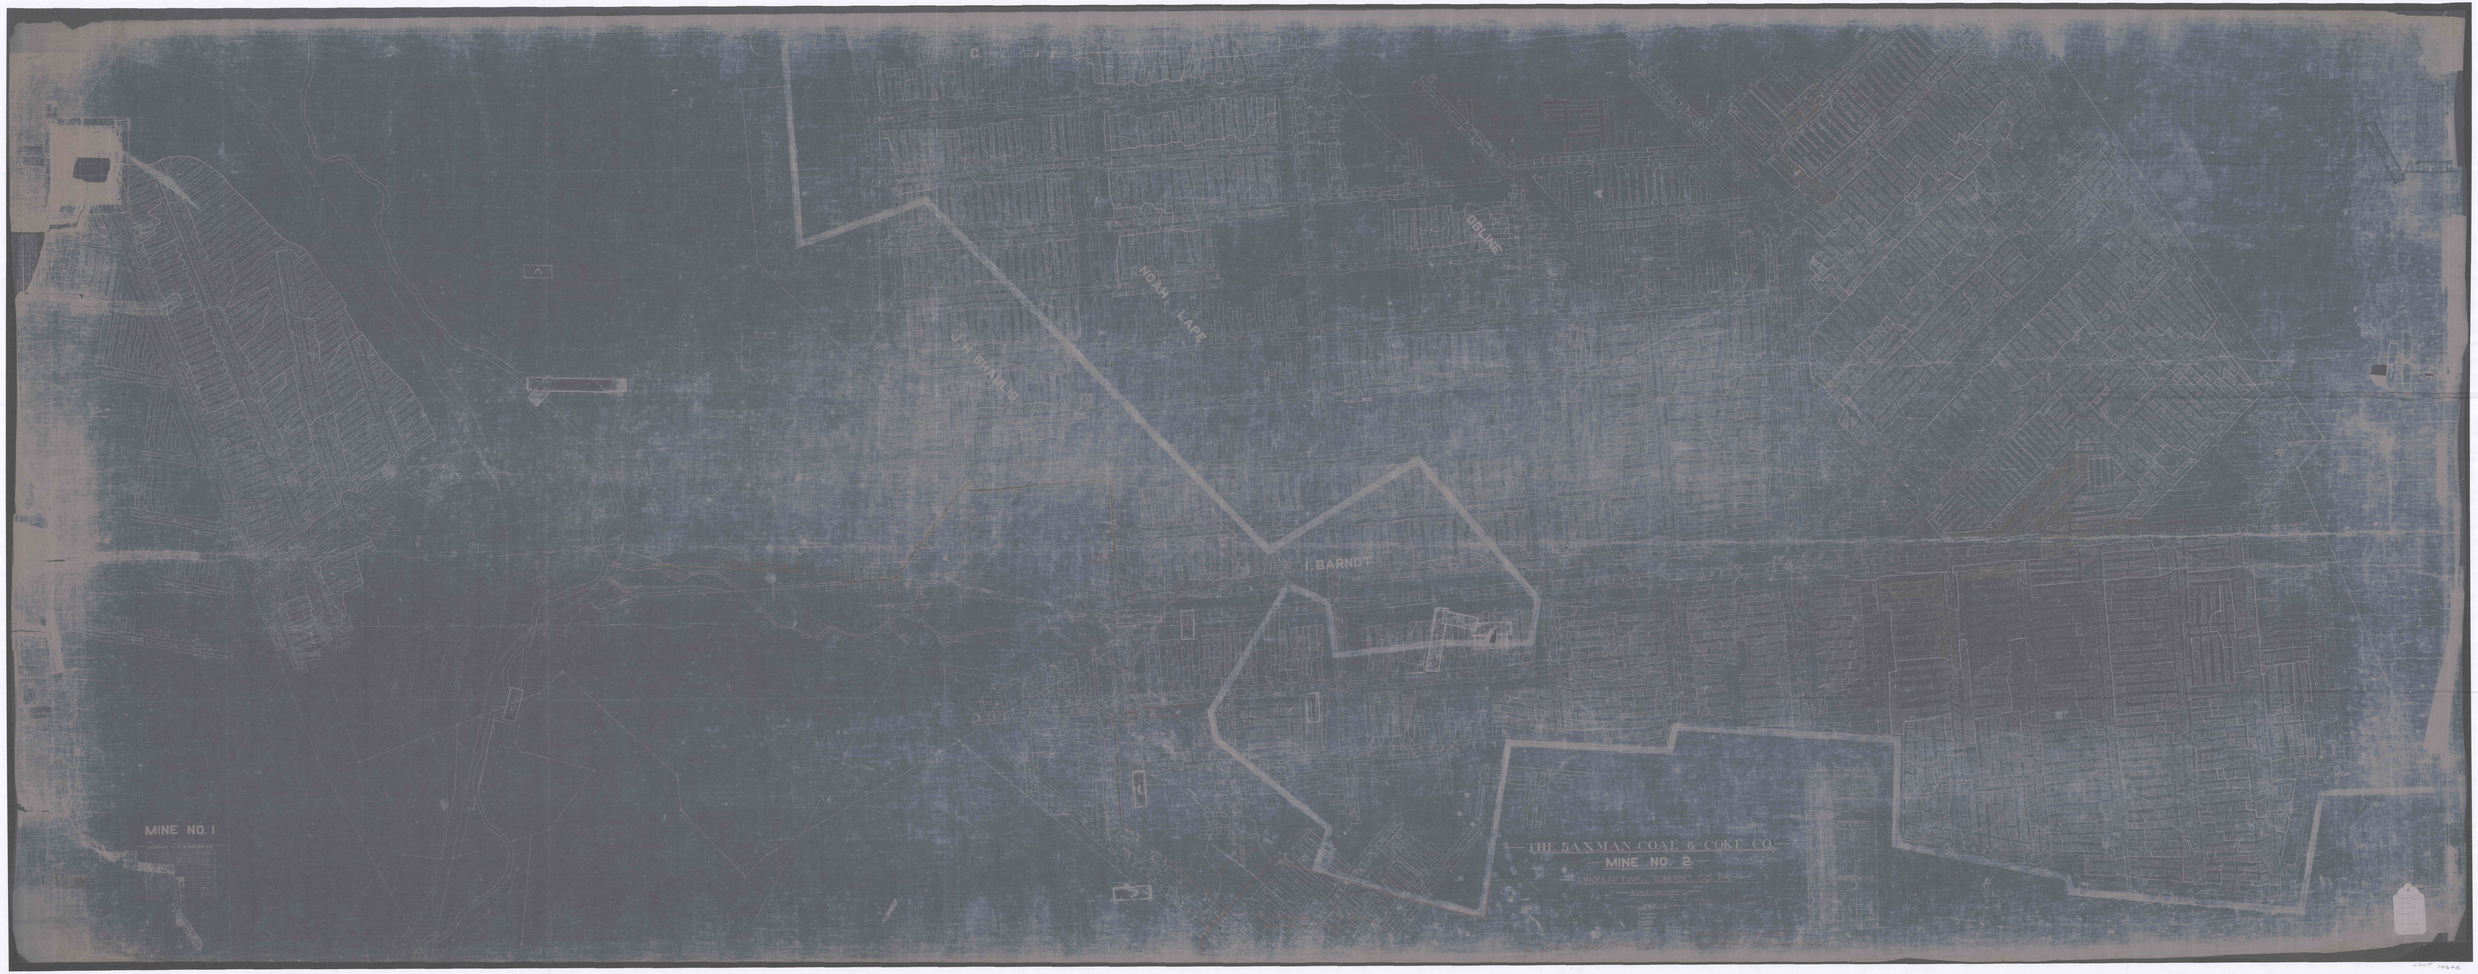
C.
OBLINE
NOAH LAPE
J.M. SHANLIS
I. BARNDT
MINE NO. 1
THE SAXMAN COAL & COKE CO.
MINE NO. 2
SHANKSVILLE TWP., SOMERSET CO., PA.