


ANNANIAS MANGUS
846

JACOB YOUNG
849

50% MINING

50% MINING

50% MINING

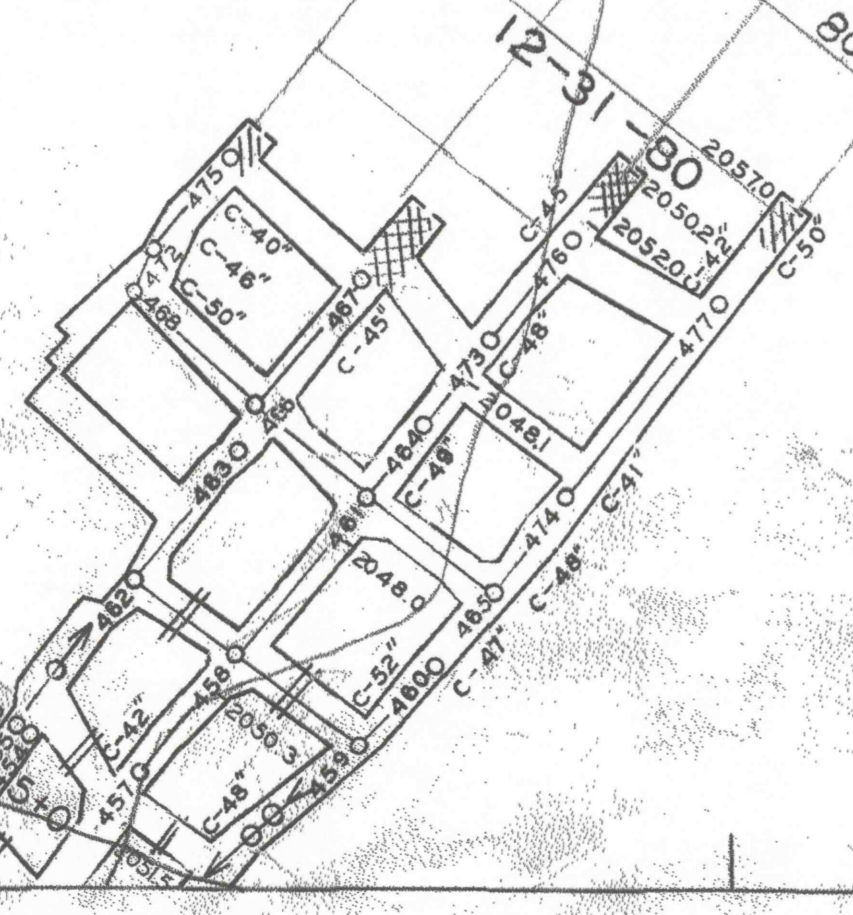

NS-B4

MATCH TO C-4

MATCH TO B-3

MATCH TO B-5

MATCH TO A-4

J-2951

J-2951