


K-2991

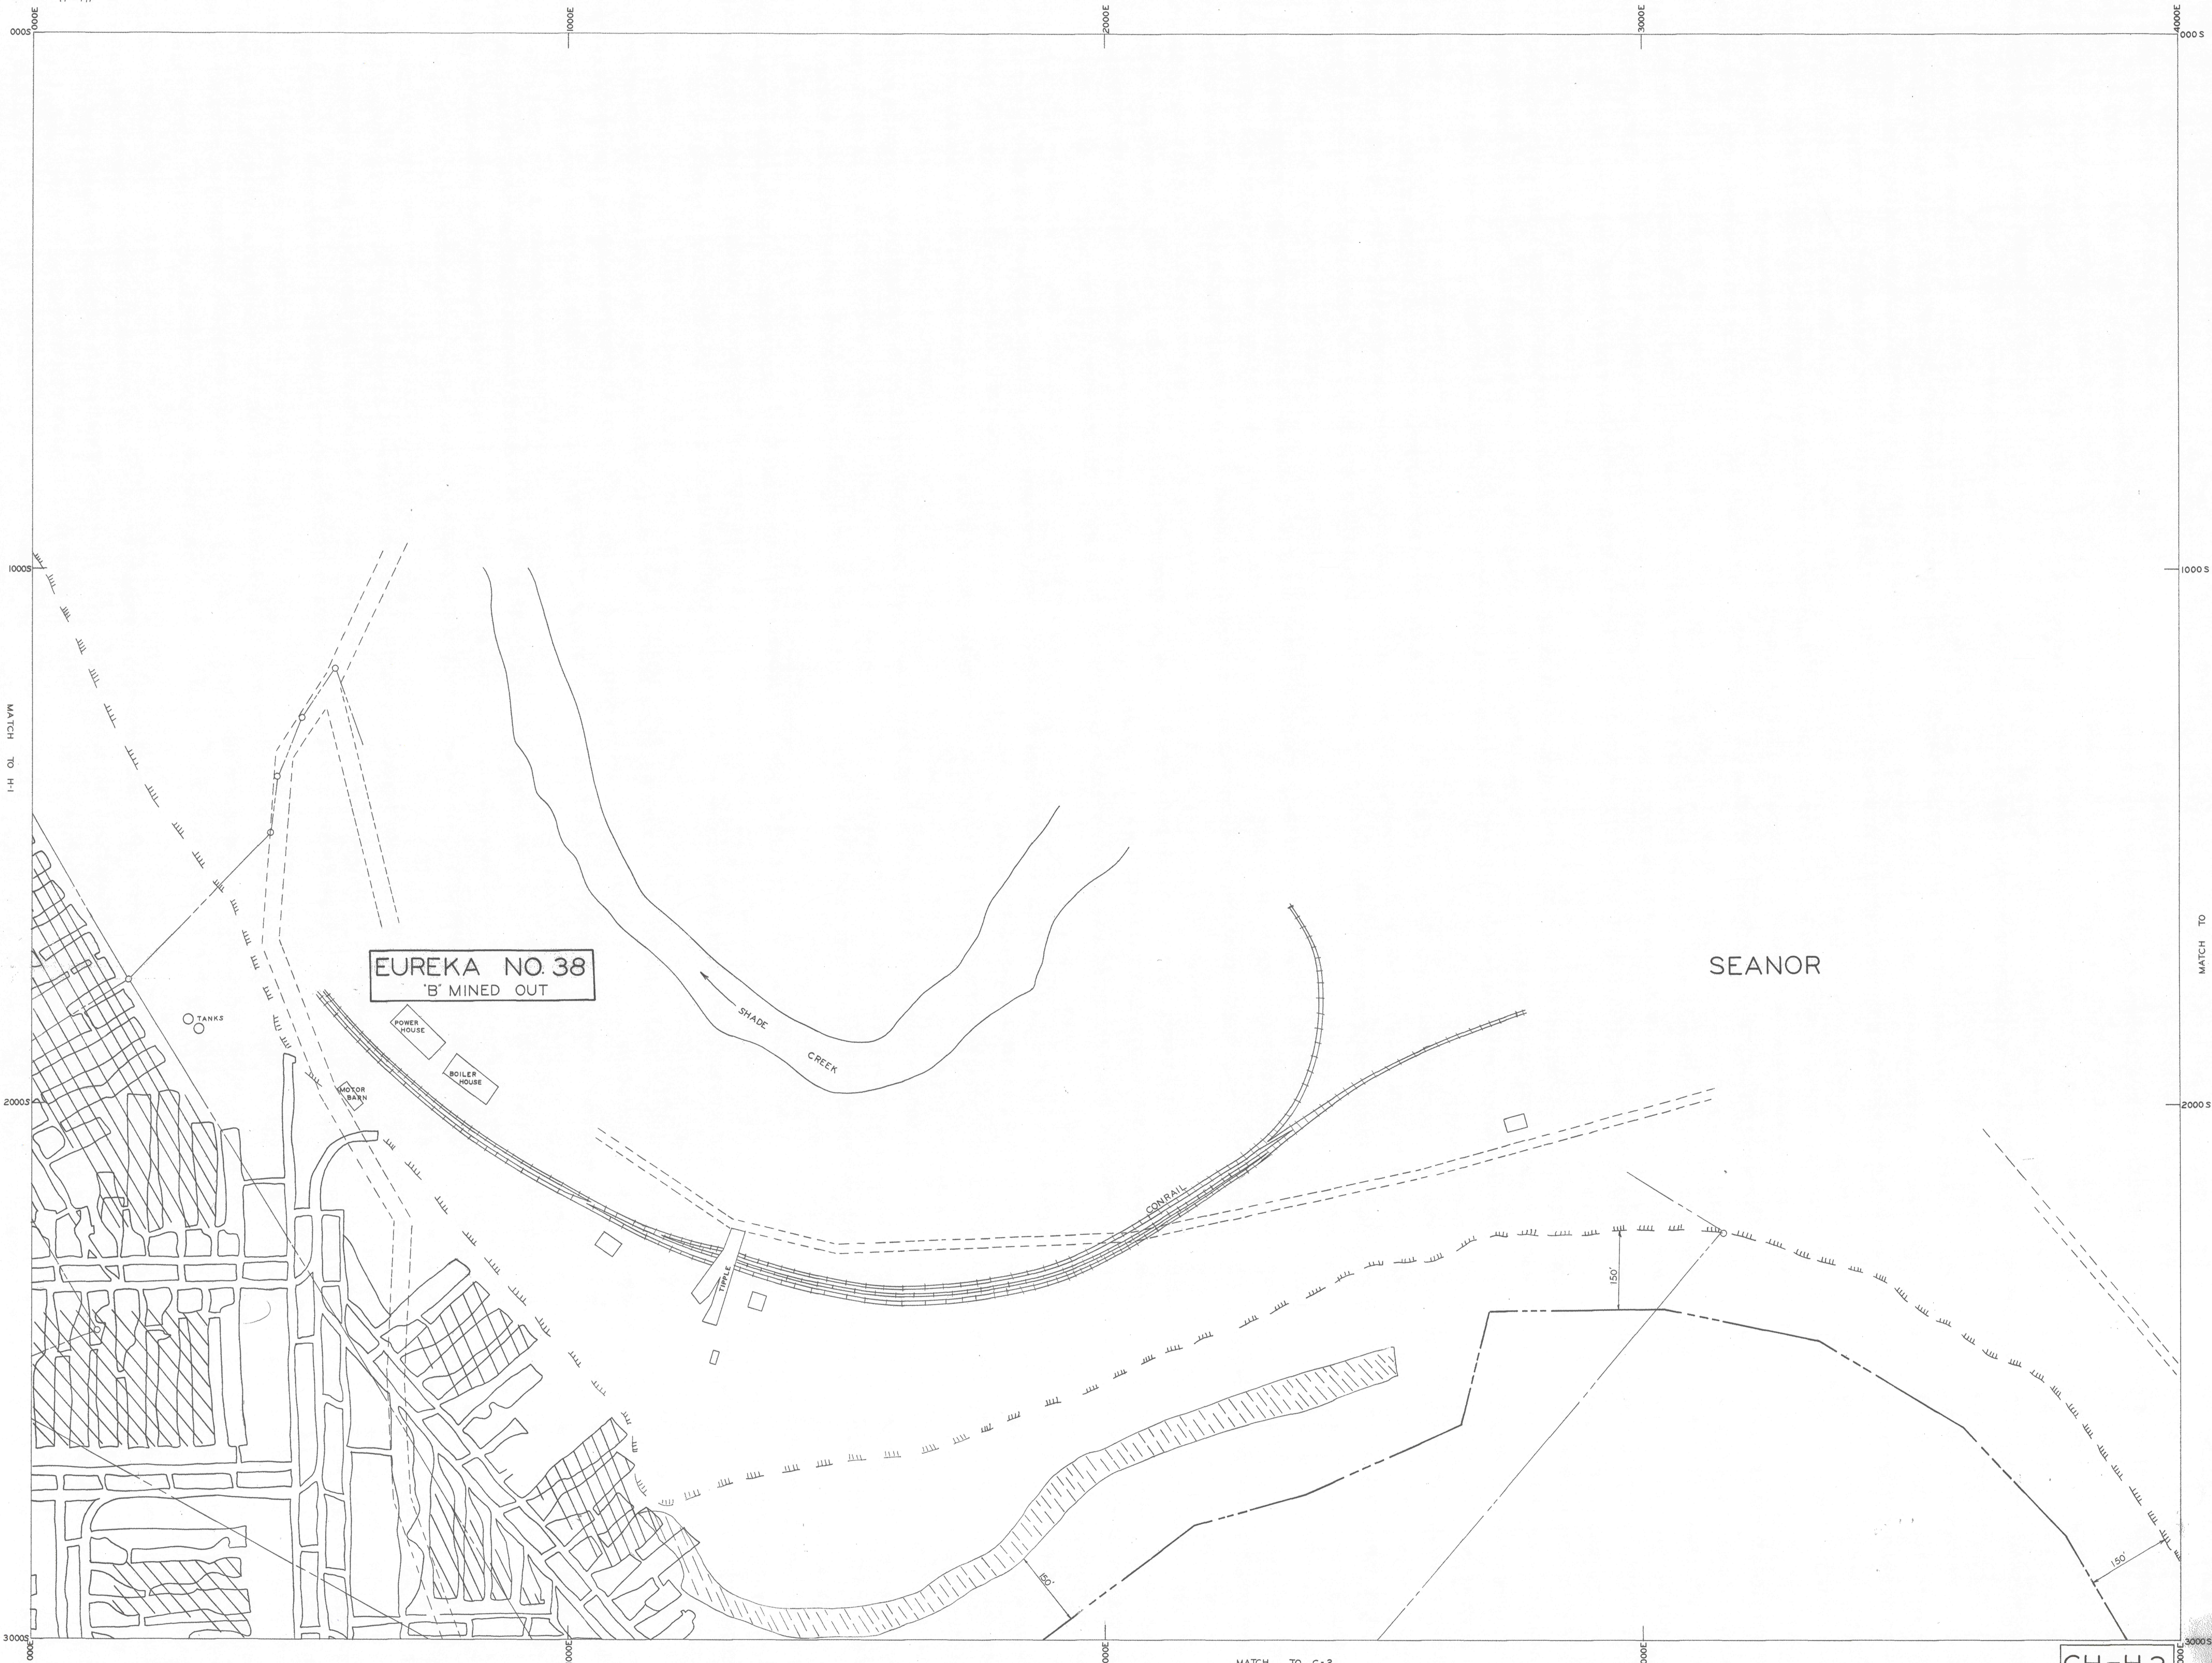

EUREKA NO 38
 'B' MINED OUT

SEANOR

TANKS
 POWER HOUSE
 BOILER HOUSE
 MOTOR BARN

SHADE CREEK

CONRAIL

TURPLE

150'

150'

150'

MATCH TO G-2

CH-H2

K-2991