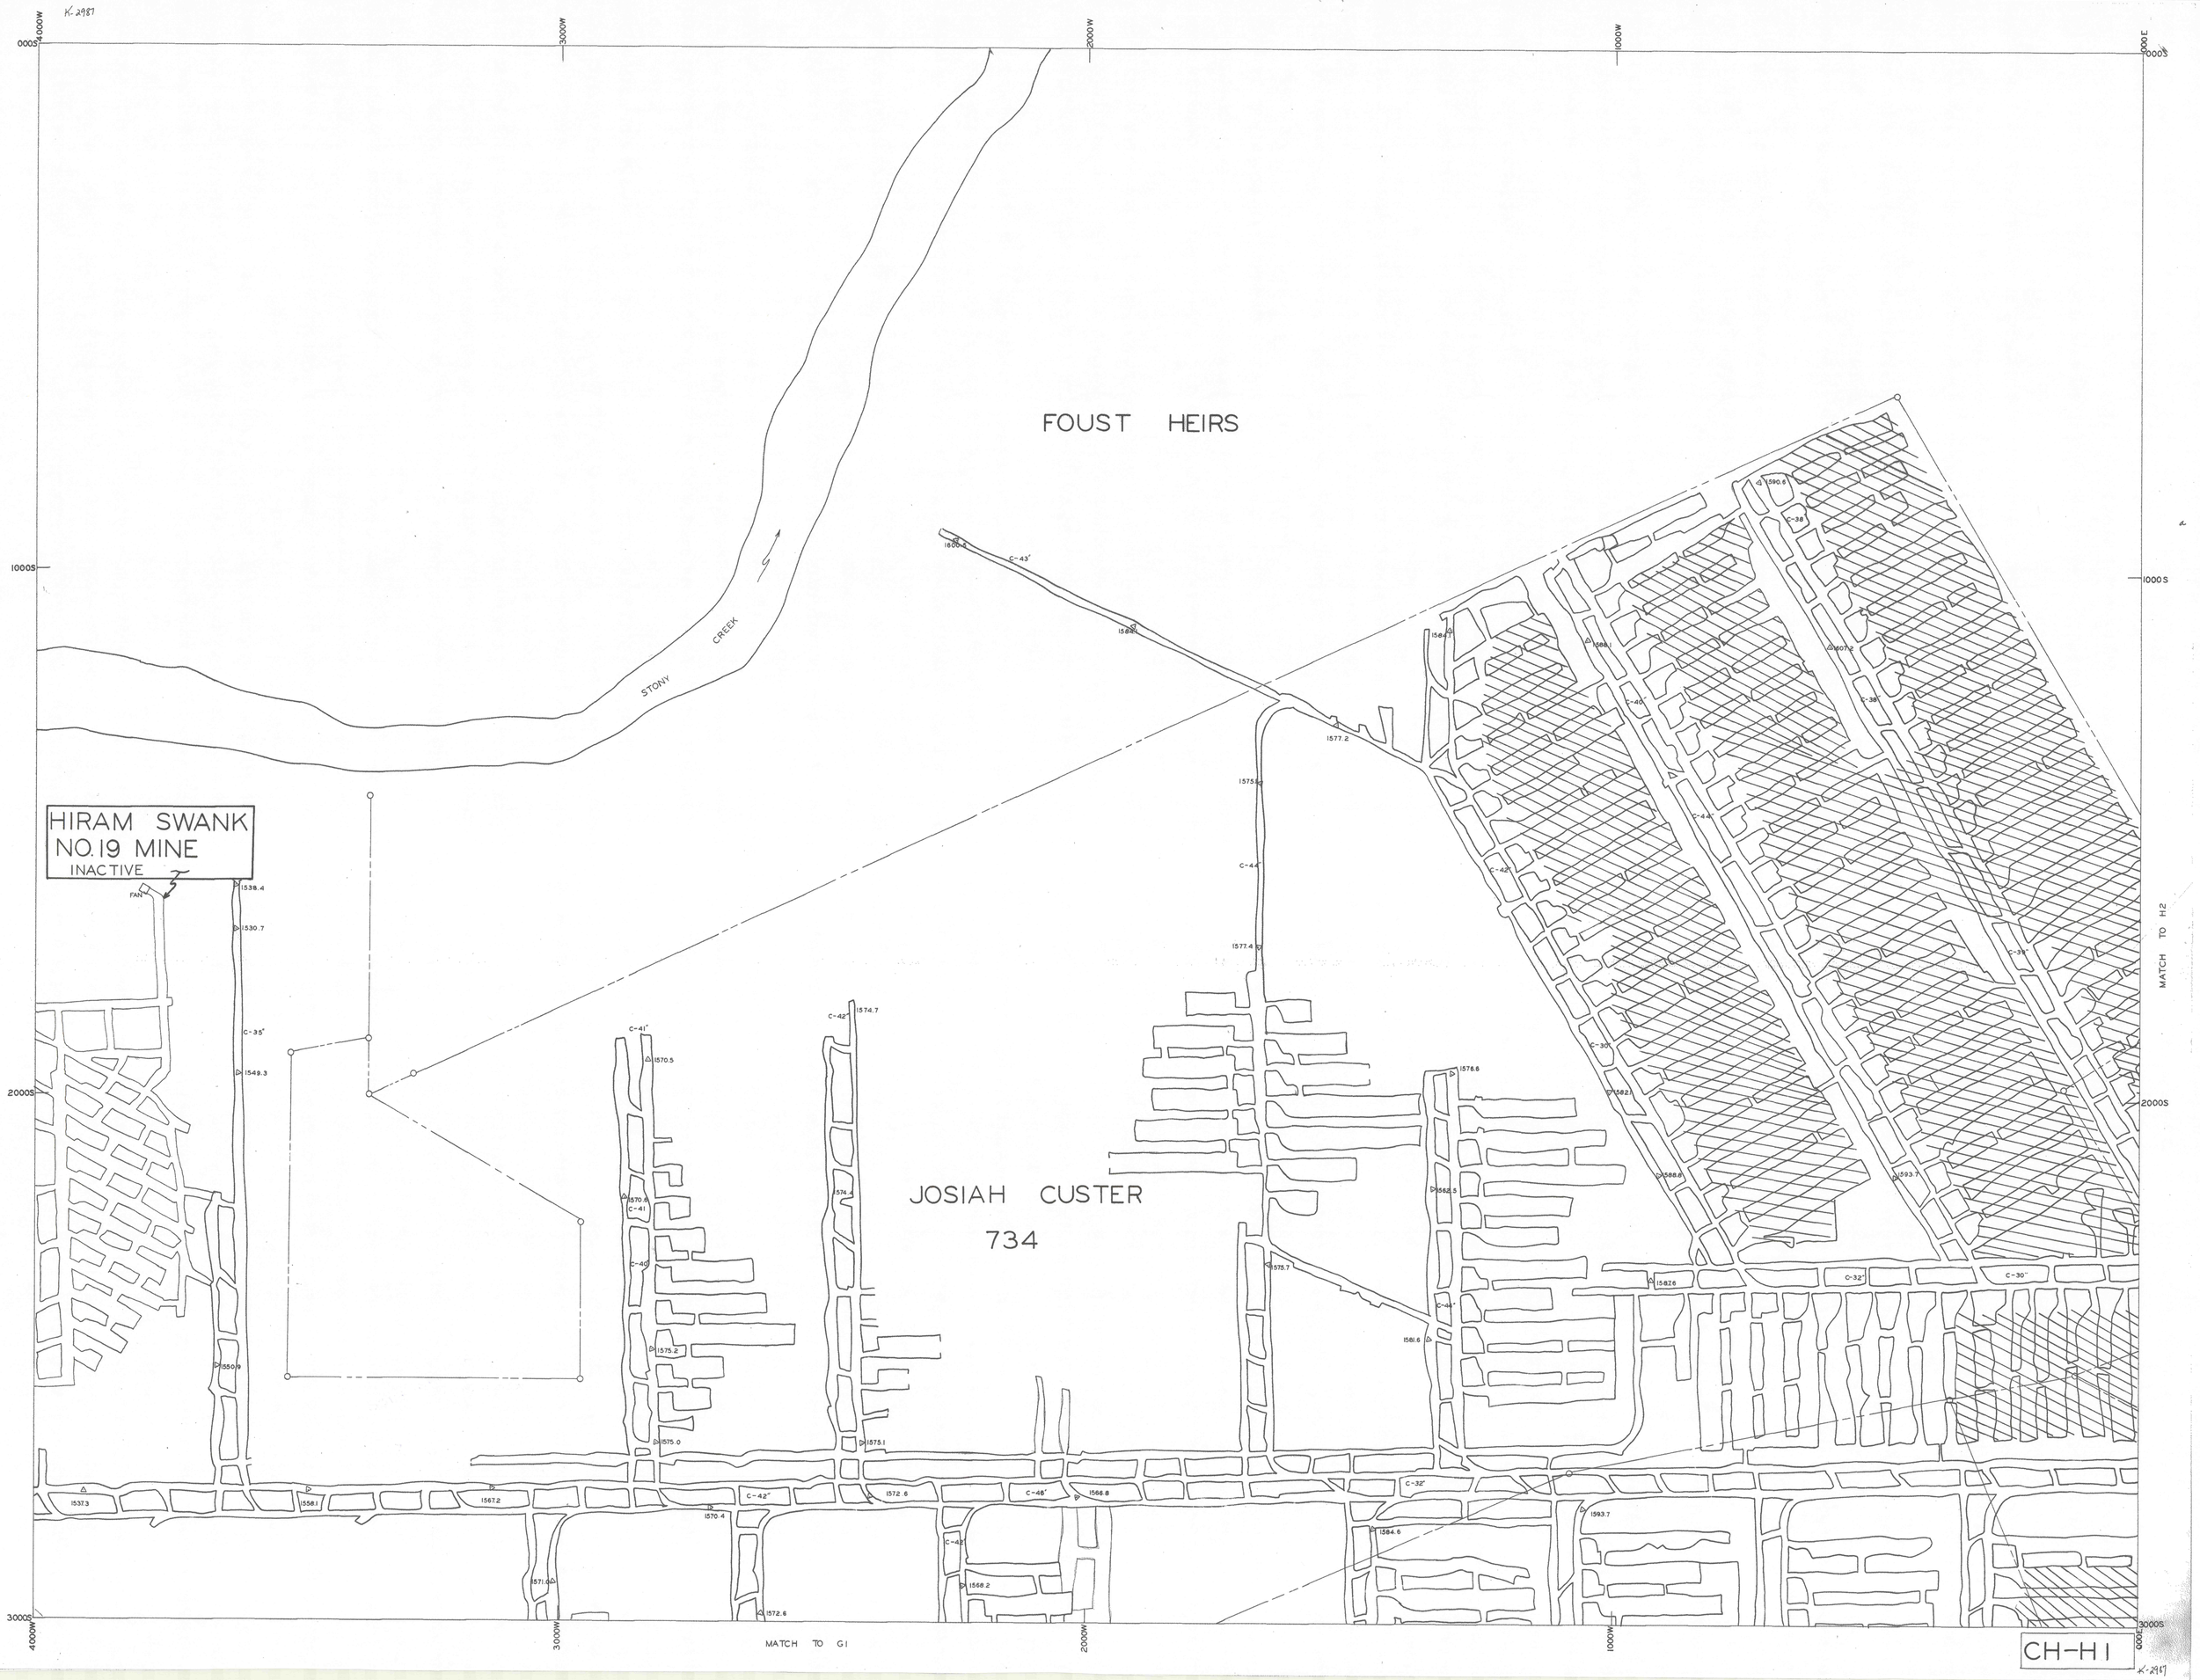

K-2987
FOUST HEIRS
STONY CREEK
HIRAM SWANK
NO.19 MINE
INACTIVE
FAN
JOSIAH CUSTER
734
MATCH TO H2
MATCH TO G1
CH-H1