



HENRY D. NAUGLE

774

ELIZA JANE BERKEY


775

MANION NO. 1
-ABANDONED-

SHADE MINING COMPANY
SHADE NO. 2 JOB

AUGER MINING
4-9-80

JAMES DEITLE

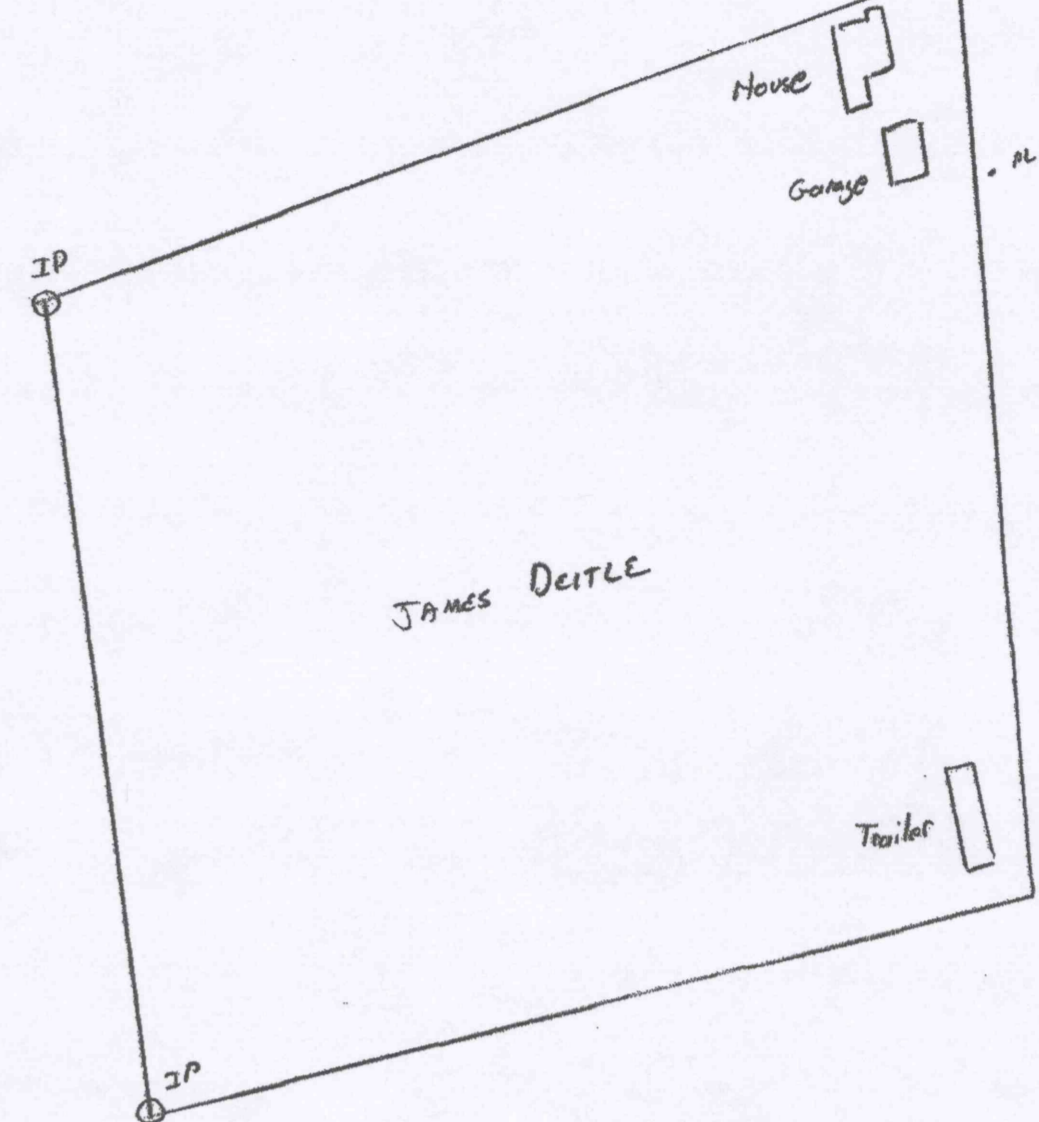

ST-V-02

ST-2-02

ST-D4

J. 2902

