


NORTH

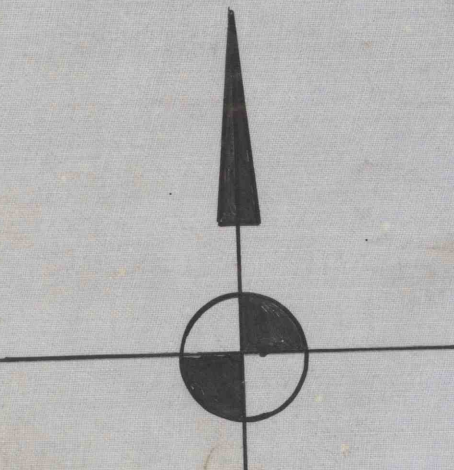

PORTER TOWNSHIP, JEFFERSON COUNTY, PENNA.

SCALE: 1/2"=100'

DORA No. 2 MINE

DOVERSPIKE BROTHERS COAL COMPANY

GAS
WELL


GAS
WELL

BARNETT

L.W. DINGER

L.W. DINGER

PATRICK M. KENNEDY

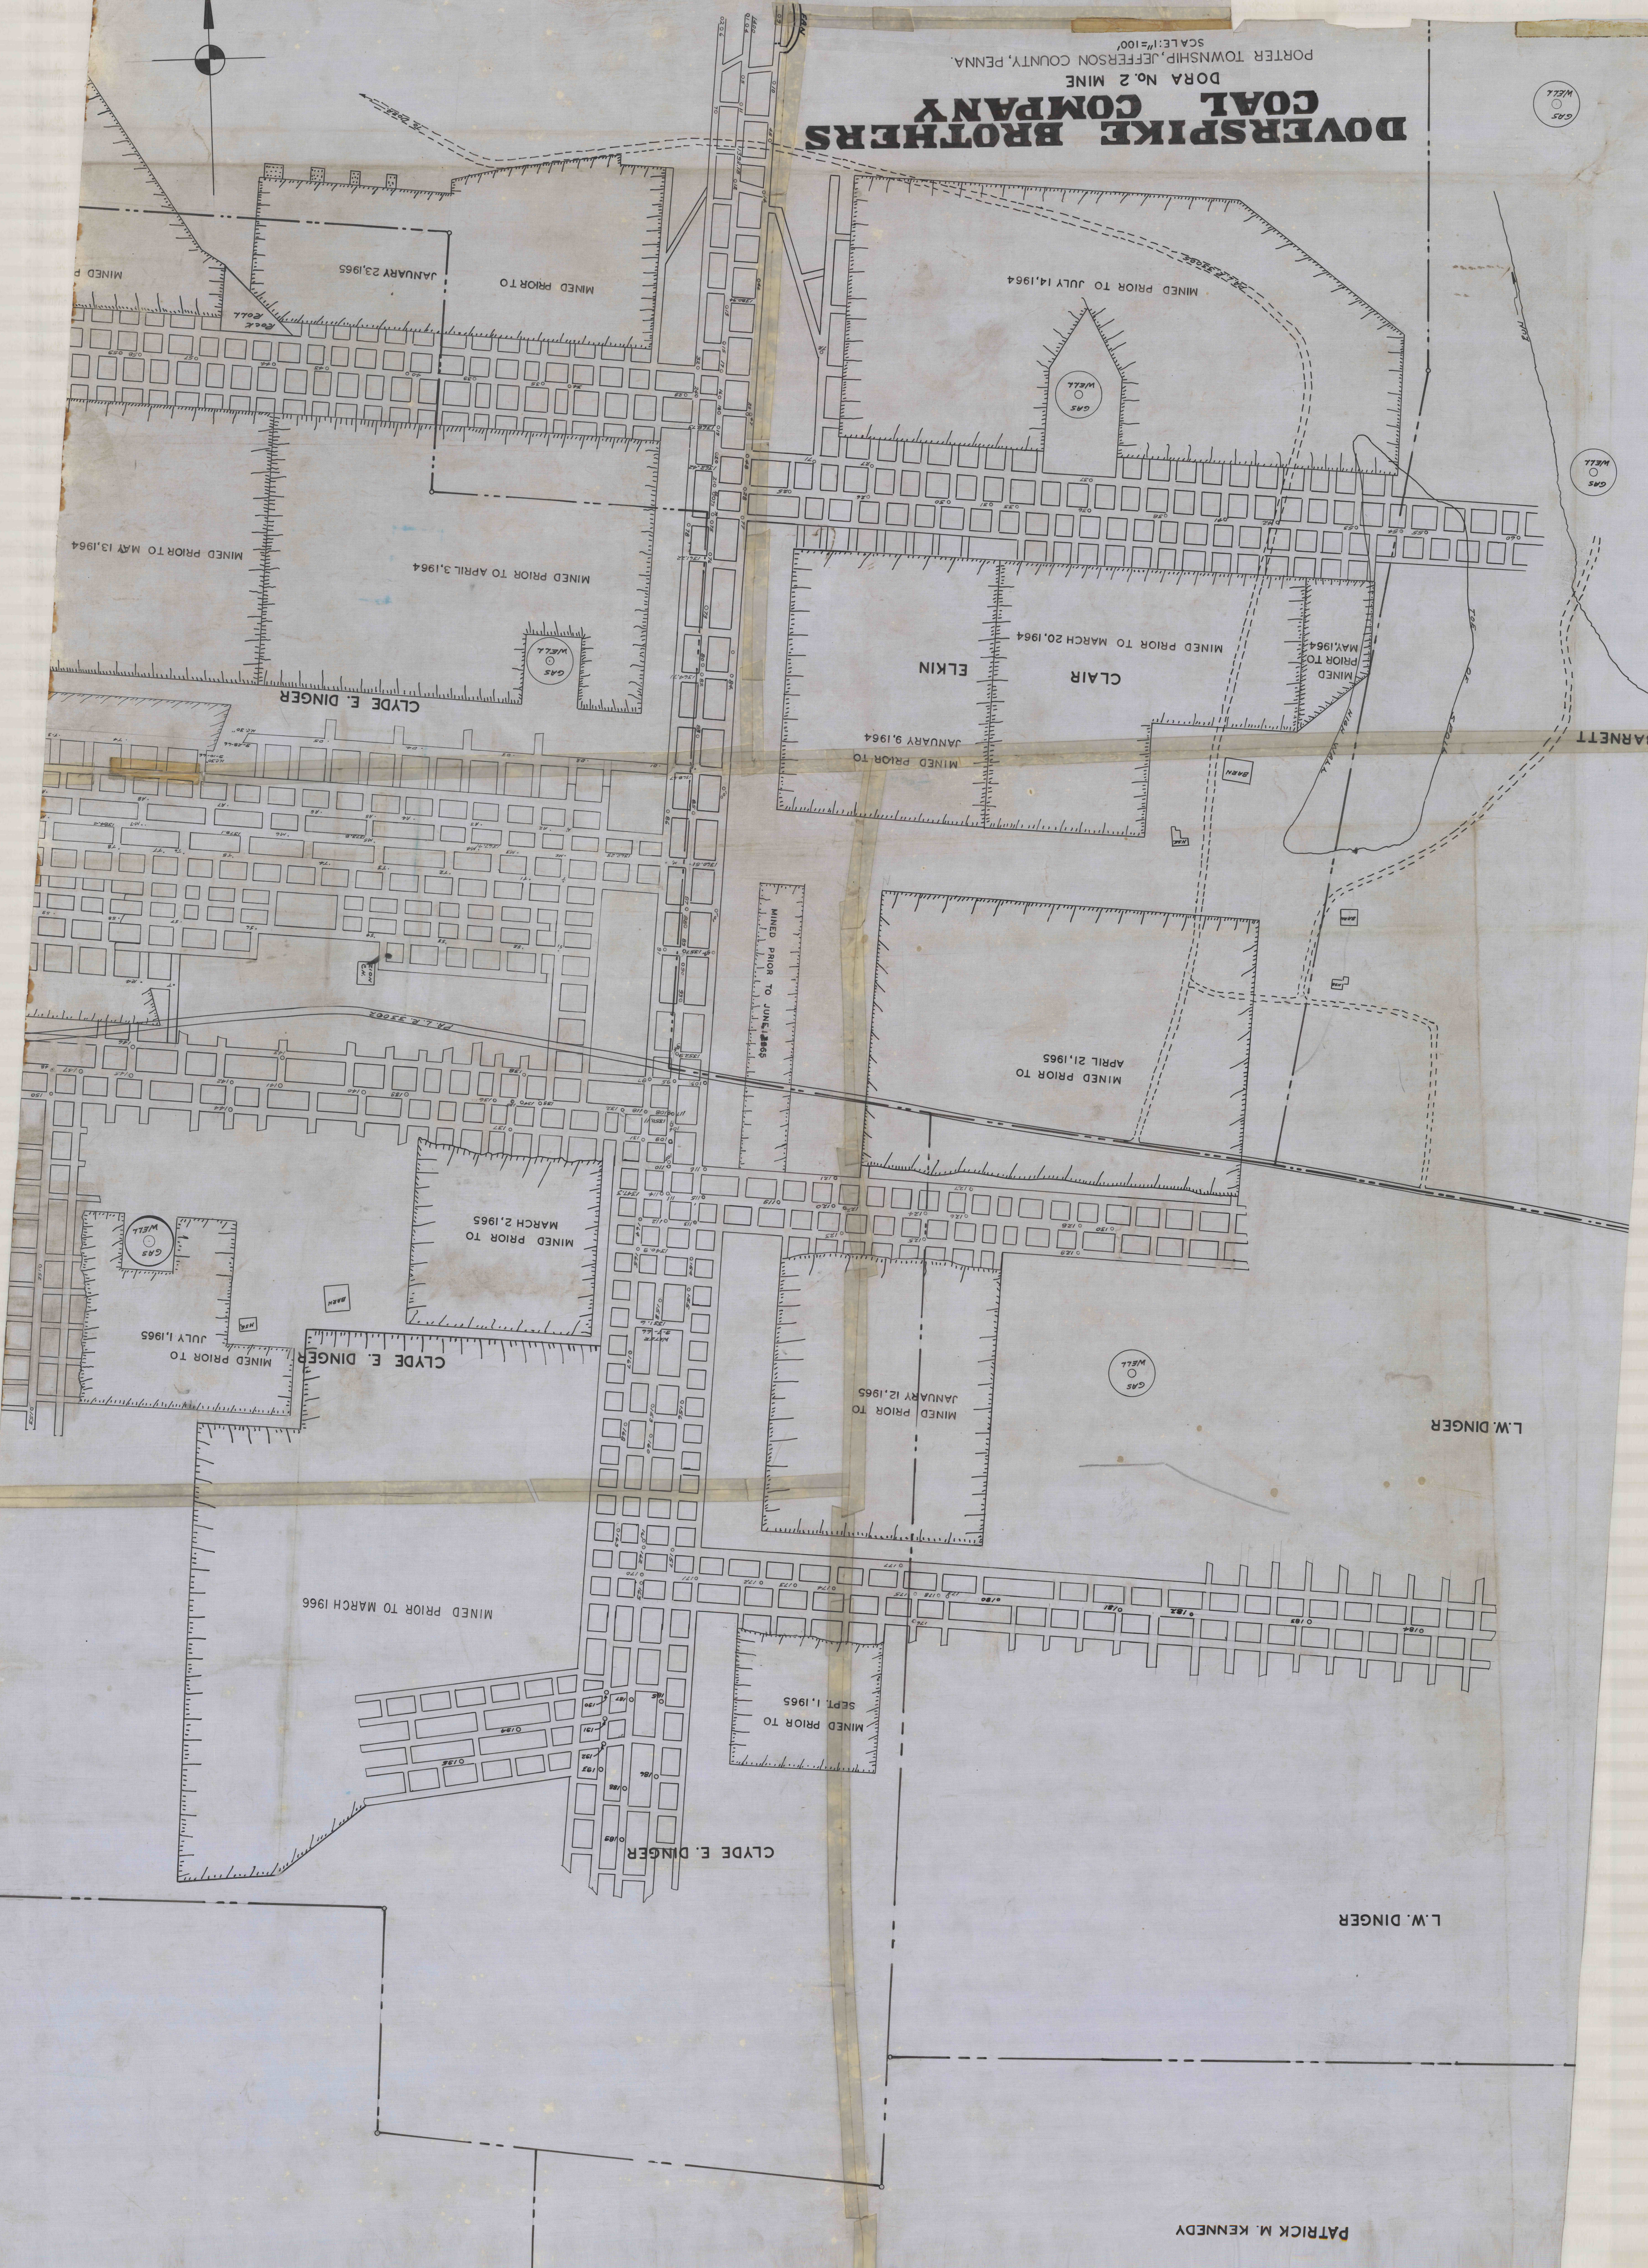

JANUARY 23, 1955
MINED PRIOR TO

MINED PRIOR TO JULY 14, 1964

MINED PRIOR TO MAY 13, 1964

MINED PRIOR TO APRIL 3, 1964

CLYDE E. DINGER

ELKIN
CLAIR

JANUARY 9, 1964
MINED PRIOR TO

MINED
PRIOR TO
MAY, 1964

MINED PRIOR TO JUNE, 1965

MINED PRIOR TO
APRIL 21, 1965

MINED PRIOR TO
MARCH 2, 1965

MINED PRIOR TO
JULY 1, 1965

CLYDE E. DINGER

MINED PRIOR TO
JANUARY 12, 1965

MINED PRIOR TO MARCH 1966

MINED PRIOR TO
SEPT. 1, 1965

CLYDE E. DINGER