



For Information:

Shrock No. 3 Mine
Portal No. 2
 UNITED INDUSTRIES, INC., KEYSTONE BLDG., KITTANNING, PA.
 PORTER TOWNSHIP, JEFFERSON COUNTY, PENNSYLVANIA.
 I.D. No. 36 02613 0 Scale: 1" = 100'
 10/1/70

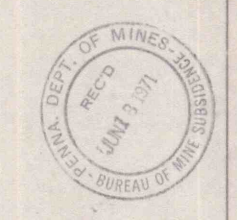

- LEGEND
- CONTEMPLATED MINING To
 - MINING COMPLETED
 - PROTECTED STRUCTURE
 - SUPPORT AREA
 - INTAKE AIR
 - RETURN AIR
 - STOPPING
 - REGULATOR
 - OVERCAST
 - DOOR

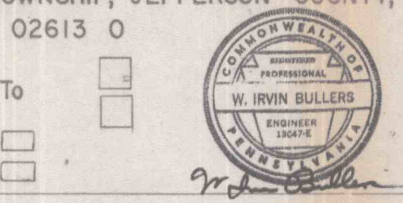

FINAL MAP

MINING COMPLETED AS SHOWN APRIL 22, 1971

closed mine

DELTA ASSOCIATES
 PUNXSUTAWNEY, PA.

w.n.green

50%

See CDO # 2136