


MATCH LINE SHEET 1

BLANEY BOWSER

BLANEY BOWSER

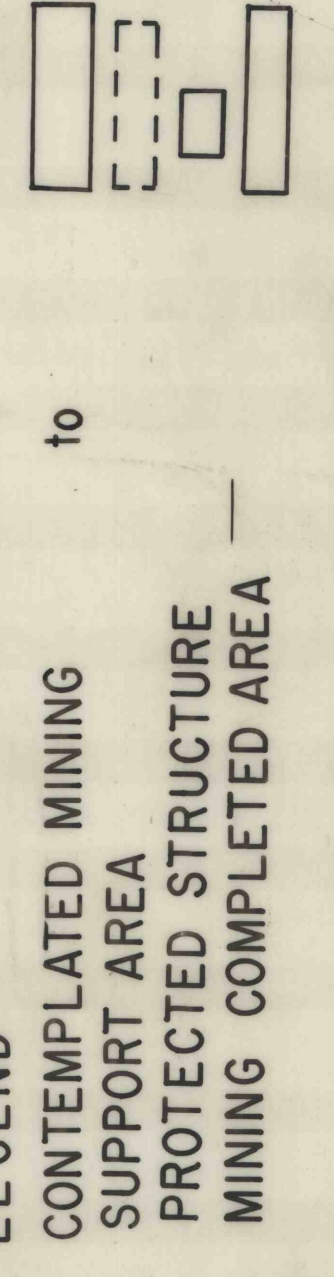

MINE MAP FOR  
 F & E COAL COMPANY, INC.  
 "FONDEROSA MINE"  
 WASHINGTON TWP., ARMSTRONG CO.  
 PENNSYLVANIA  
 SCALE: 1"=100'  
 7-5-1966  
 J.W. HUBBARD, R.P.E.

