


STINEMAN COAL & COKE CO.
Operating Company
Mar. 1, 1941

Carnegie-Illinois Steel Corporation
(LORAIN DIVISION)
Johnstown, Pennsylvania
SUBSIDIARY OF
UNITED STATES STEEL CORPORATION

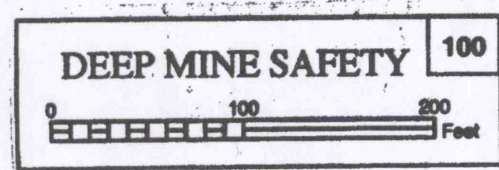

October 1, 1935

MAP SHOWING MINING OPERATIONS OF
INGLESIDE MINE No. 5 B SEAM
SITUATE IN RICHLAND AND STONYCREEK TOWNSHIPS
CAMBRIA COUNTY, PA.

The Lorain Steel Company
Johnstown, Pa.
SUBSIDIARY OF
UNITED STATES STEEL CORPORATION

Scale 1 inch = 100 ft.

July 18, 1938