MAP SHOWING MINING OPERATIONS OF
INGLESIDE MINE No. 5 "B" SEAM
Situate in Richland and Stonycreek Townships
Cambria County, Pa.

The Lorain Steel Company
Johnstown, Pa.
SUBSIDIARY OF
UNITED STATES STEEL CORPORATION

Scale 1 Inch = 100 ft. September 16, 1922

DEEP MINE SAFETY 120

MAP OF VALLEY SMOKELESS COAL C

MINING OPERATIONS

LOCATED IN

STONY CREEK TWP. CAMBRIA CO. PA.

MAR 25 1918 FETTERMAN ENG. CO. JOHNSTOWN, PA.

SCALE 1" = 100 FT.

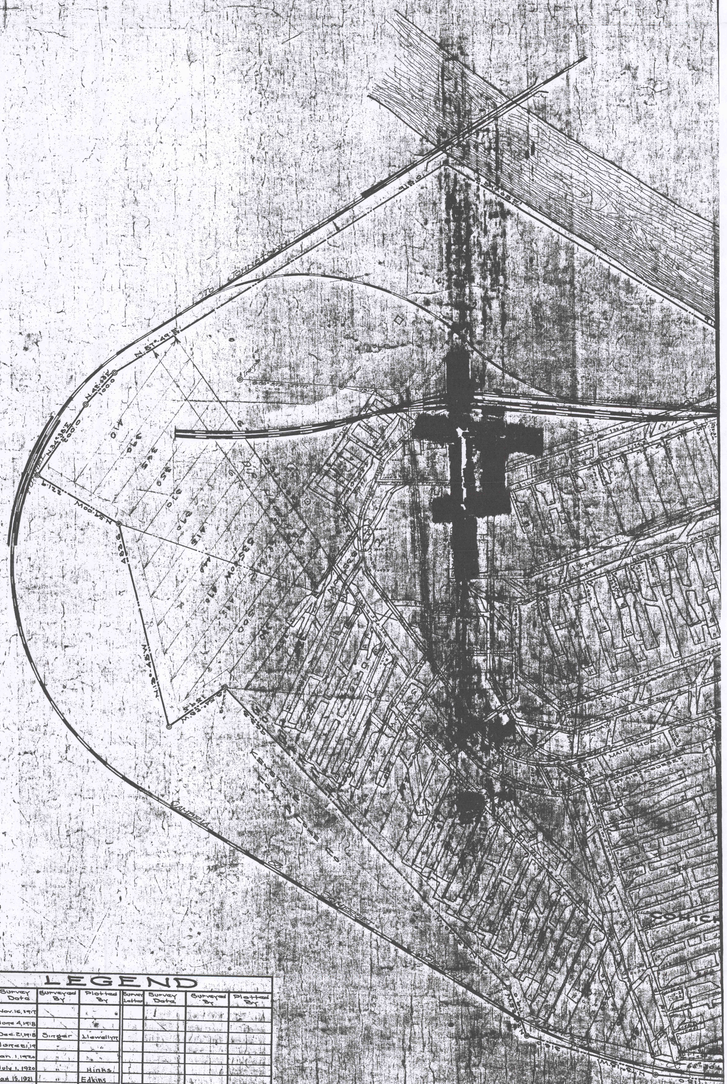

LEGEND

Mine Letter	Survey Date	Surveyed by	Work Test by	Borrow Letter	Survey Date	Surveyed by	Shadowed by
A	Nov. 16, 1917						
B	June 4, 1918		"				
C	Dec. 21, 18	Swigart	Llewellyn				
D	June 6, 19	"	"				
E	Jan. 1, 1920	"	"				
F	July 1, 1920	"	Hinks				
G	Jan 15, 1921	"	Eakins				
H	July 2, 1921	"	"				
I	Jan 17, 1922	"	"				
J	Sept 26, 1922	"	"				
K	Sept. 27	"	"				
L	July 6-23	Galbraith					
M	Jan 6-24	"	"				
N	Nov 4-25	"	A. Hinks				
O	March 26	"	"				

57
CA