


Match to Sheet 2

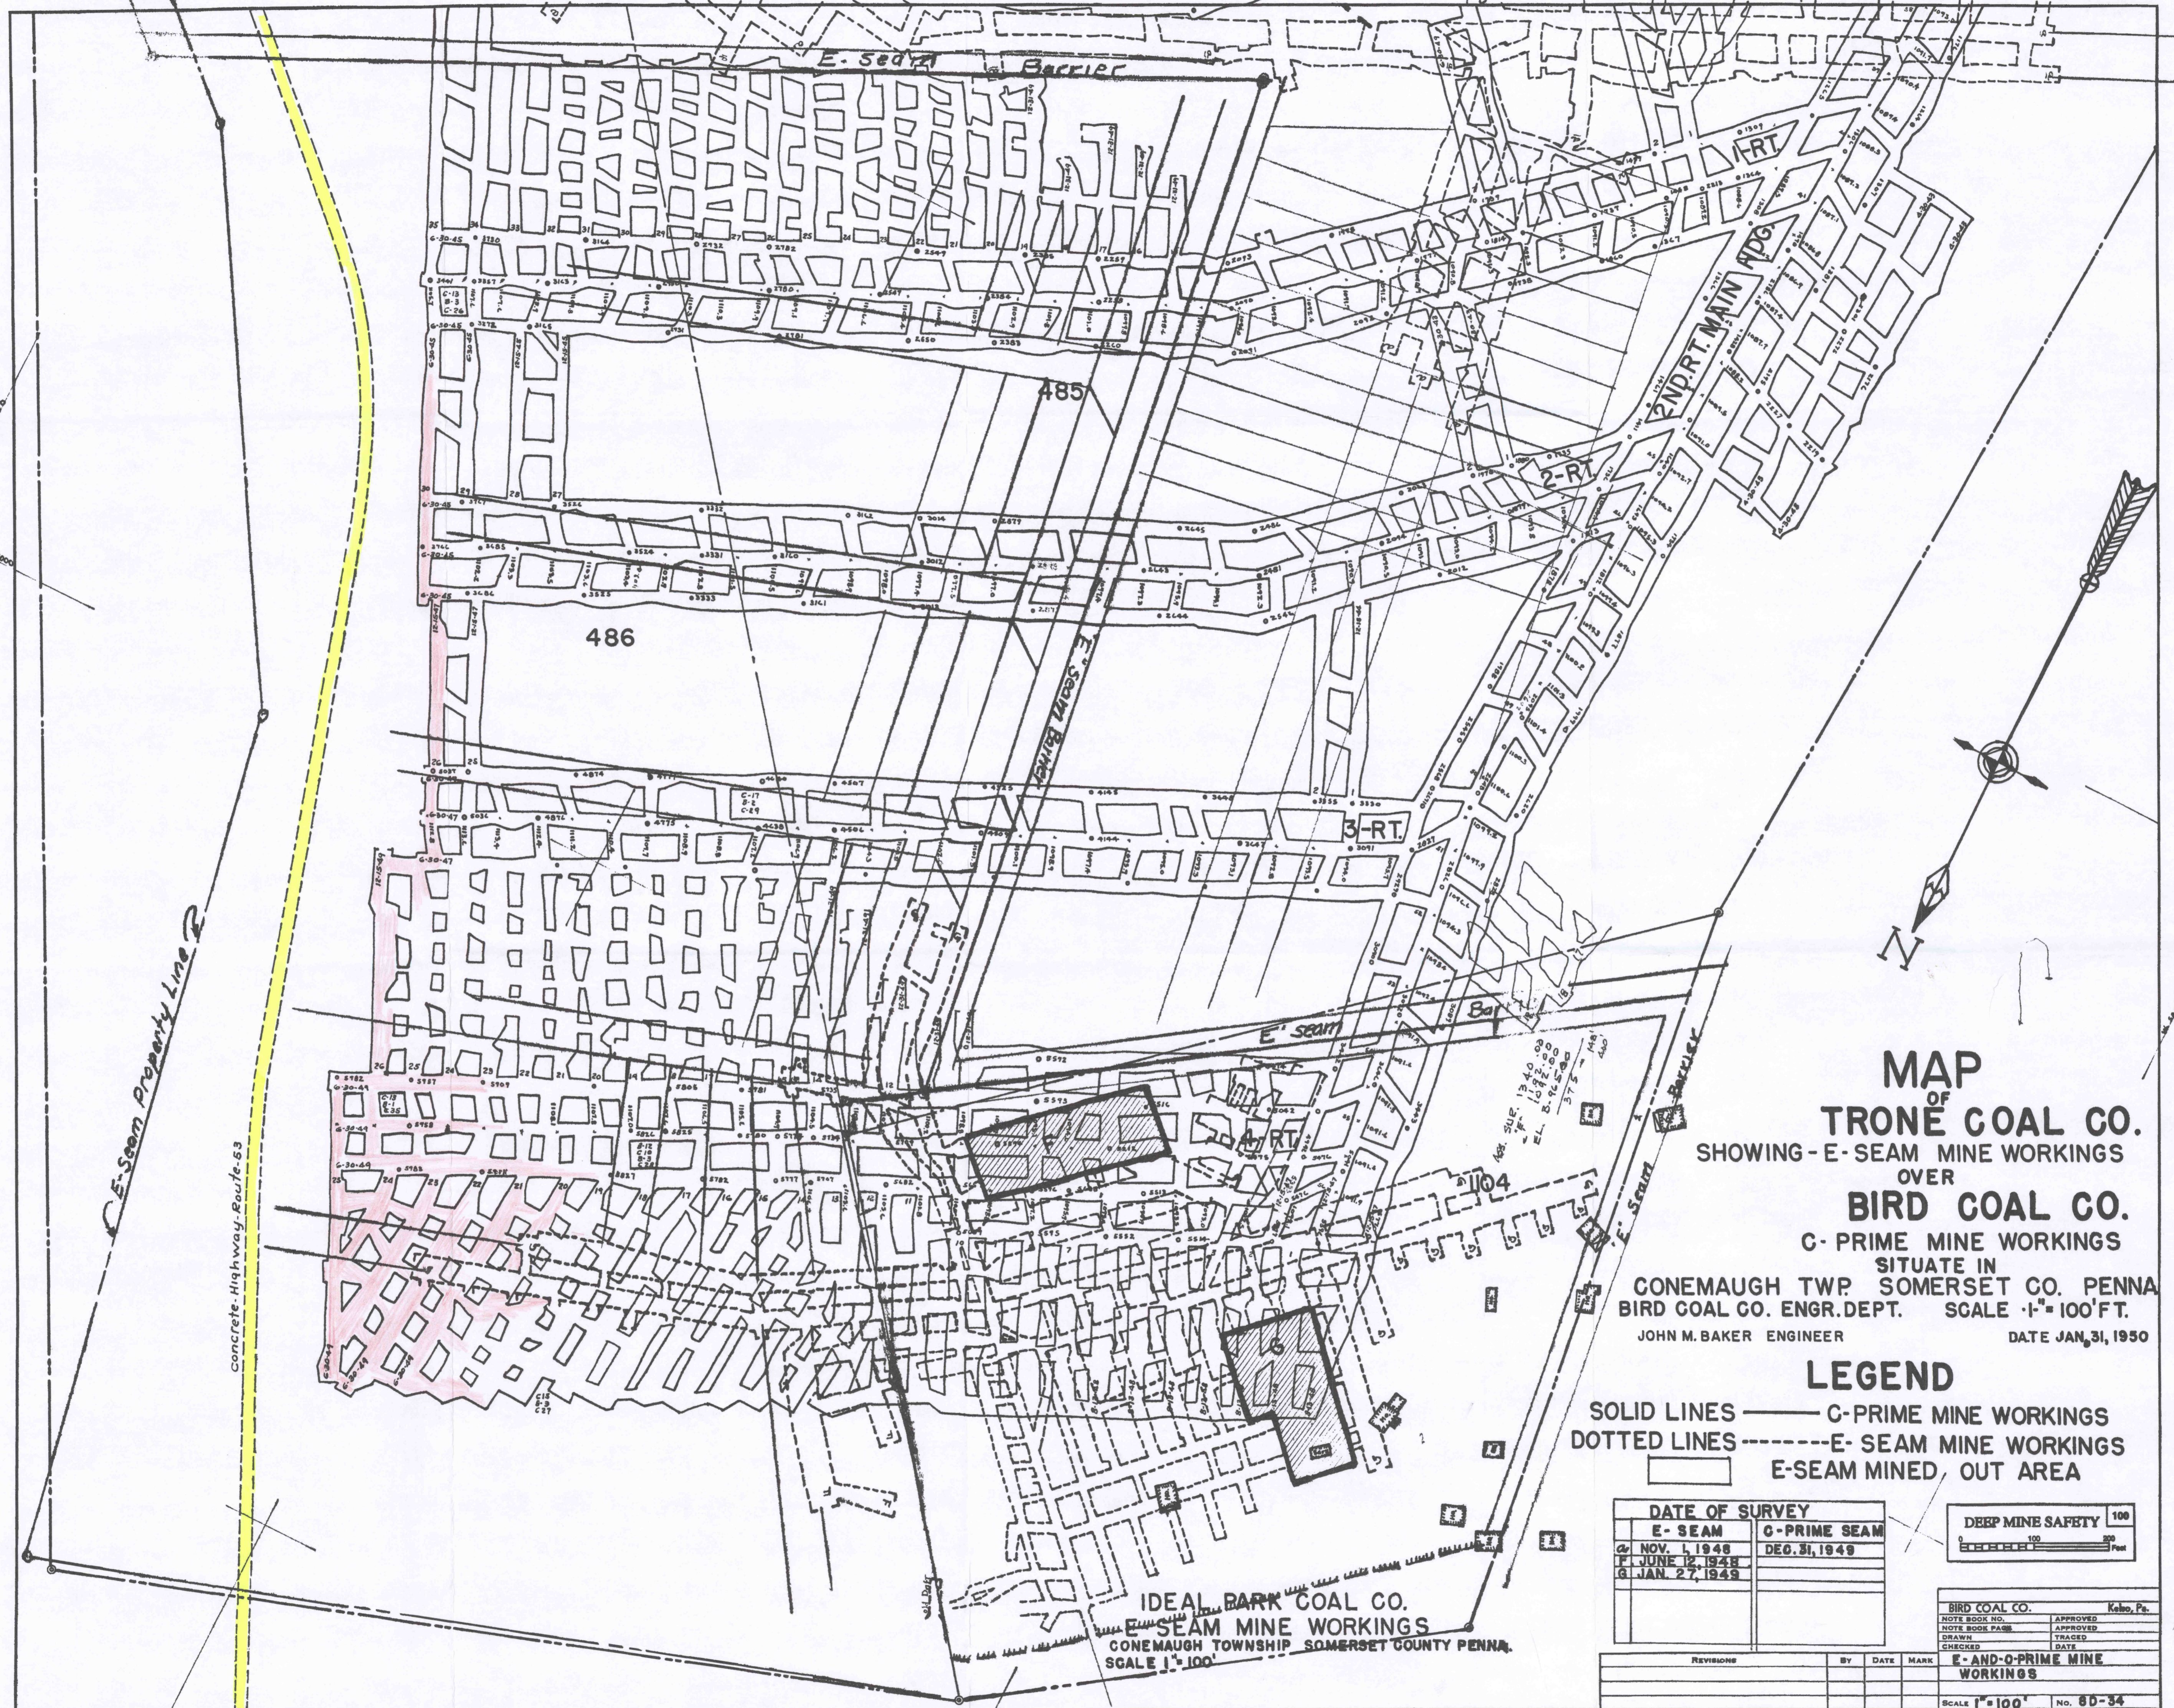

MAP
OF
TRONE COAL CO.
 SHOWING - E-SEAM MINE WORKINGS
 OVER
BIRD COAL CO.
 C-PRIME MINE WORKINGS
 SITUATE IN
 CONEMAUGH TWP. SOMERSET CO. PENNA
 BIRD COAL CO. ENGR. DEPT. SCALE 1" = 100' FT.
 JOHN M. BAKER ENGINEER DATE JAN. 31, 1950

LEGEND
 SOLID LINES — C-PRIME MINE WORKINGS
 DOTTED LINES - - - - E-SEAM MINE WORKINGS
 [] E-SEAM MINED, OUT AREA

DATE OF SURVEY	
E-SEAM	C-PRIME SEAM
2 NOV. 1, 1948	DEC. 31, 1949
F. JUNE 12, 1948	
G. JAN. 27, 1949	

DEEP MINE SAFETY 100
 0 100 200 Feet

BIRD COAL CO. Keno, Pa.
 NOTE BOOK NO. APPROVED
 NOTE BOOK PAGE APPROVED
 DRAWN TRACED
 CHECKED DATE

REVISIONS	BY	DATE	MARK

E-AND-C-PRIME MINE WORKINGS
 SCALE 1" = 100' No. 8D-34