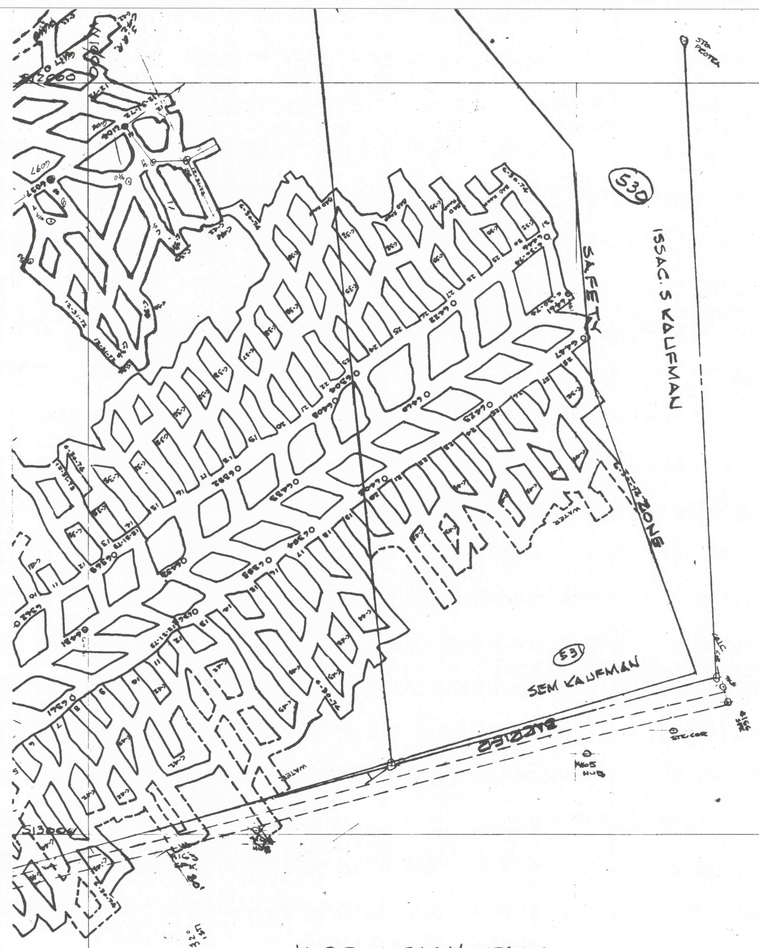

JACOB C. EASH TRACT
BIED COAL CO.

SLT. MAIN

E 1000
E 2000
513000
514000
515000
516000