

16


14

NO-3-MINE
BIRD COAL CO

B-SEAM MINING OPERATIONS

CONEMAUGH TWP SOMERSET COUNTY PENNA.
STONYCREEK TWP CAMBRIA COUNTY PENNA.
SCALE 1"=100' — BIRD COAL CO. ENGR. DEPT. —

STONY
CREEK
RIVER

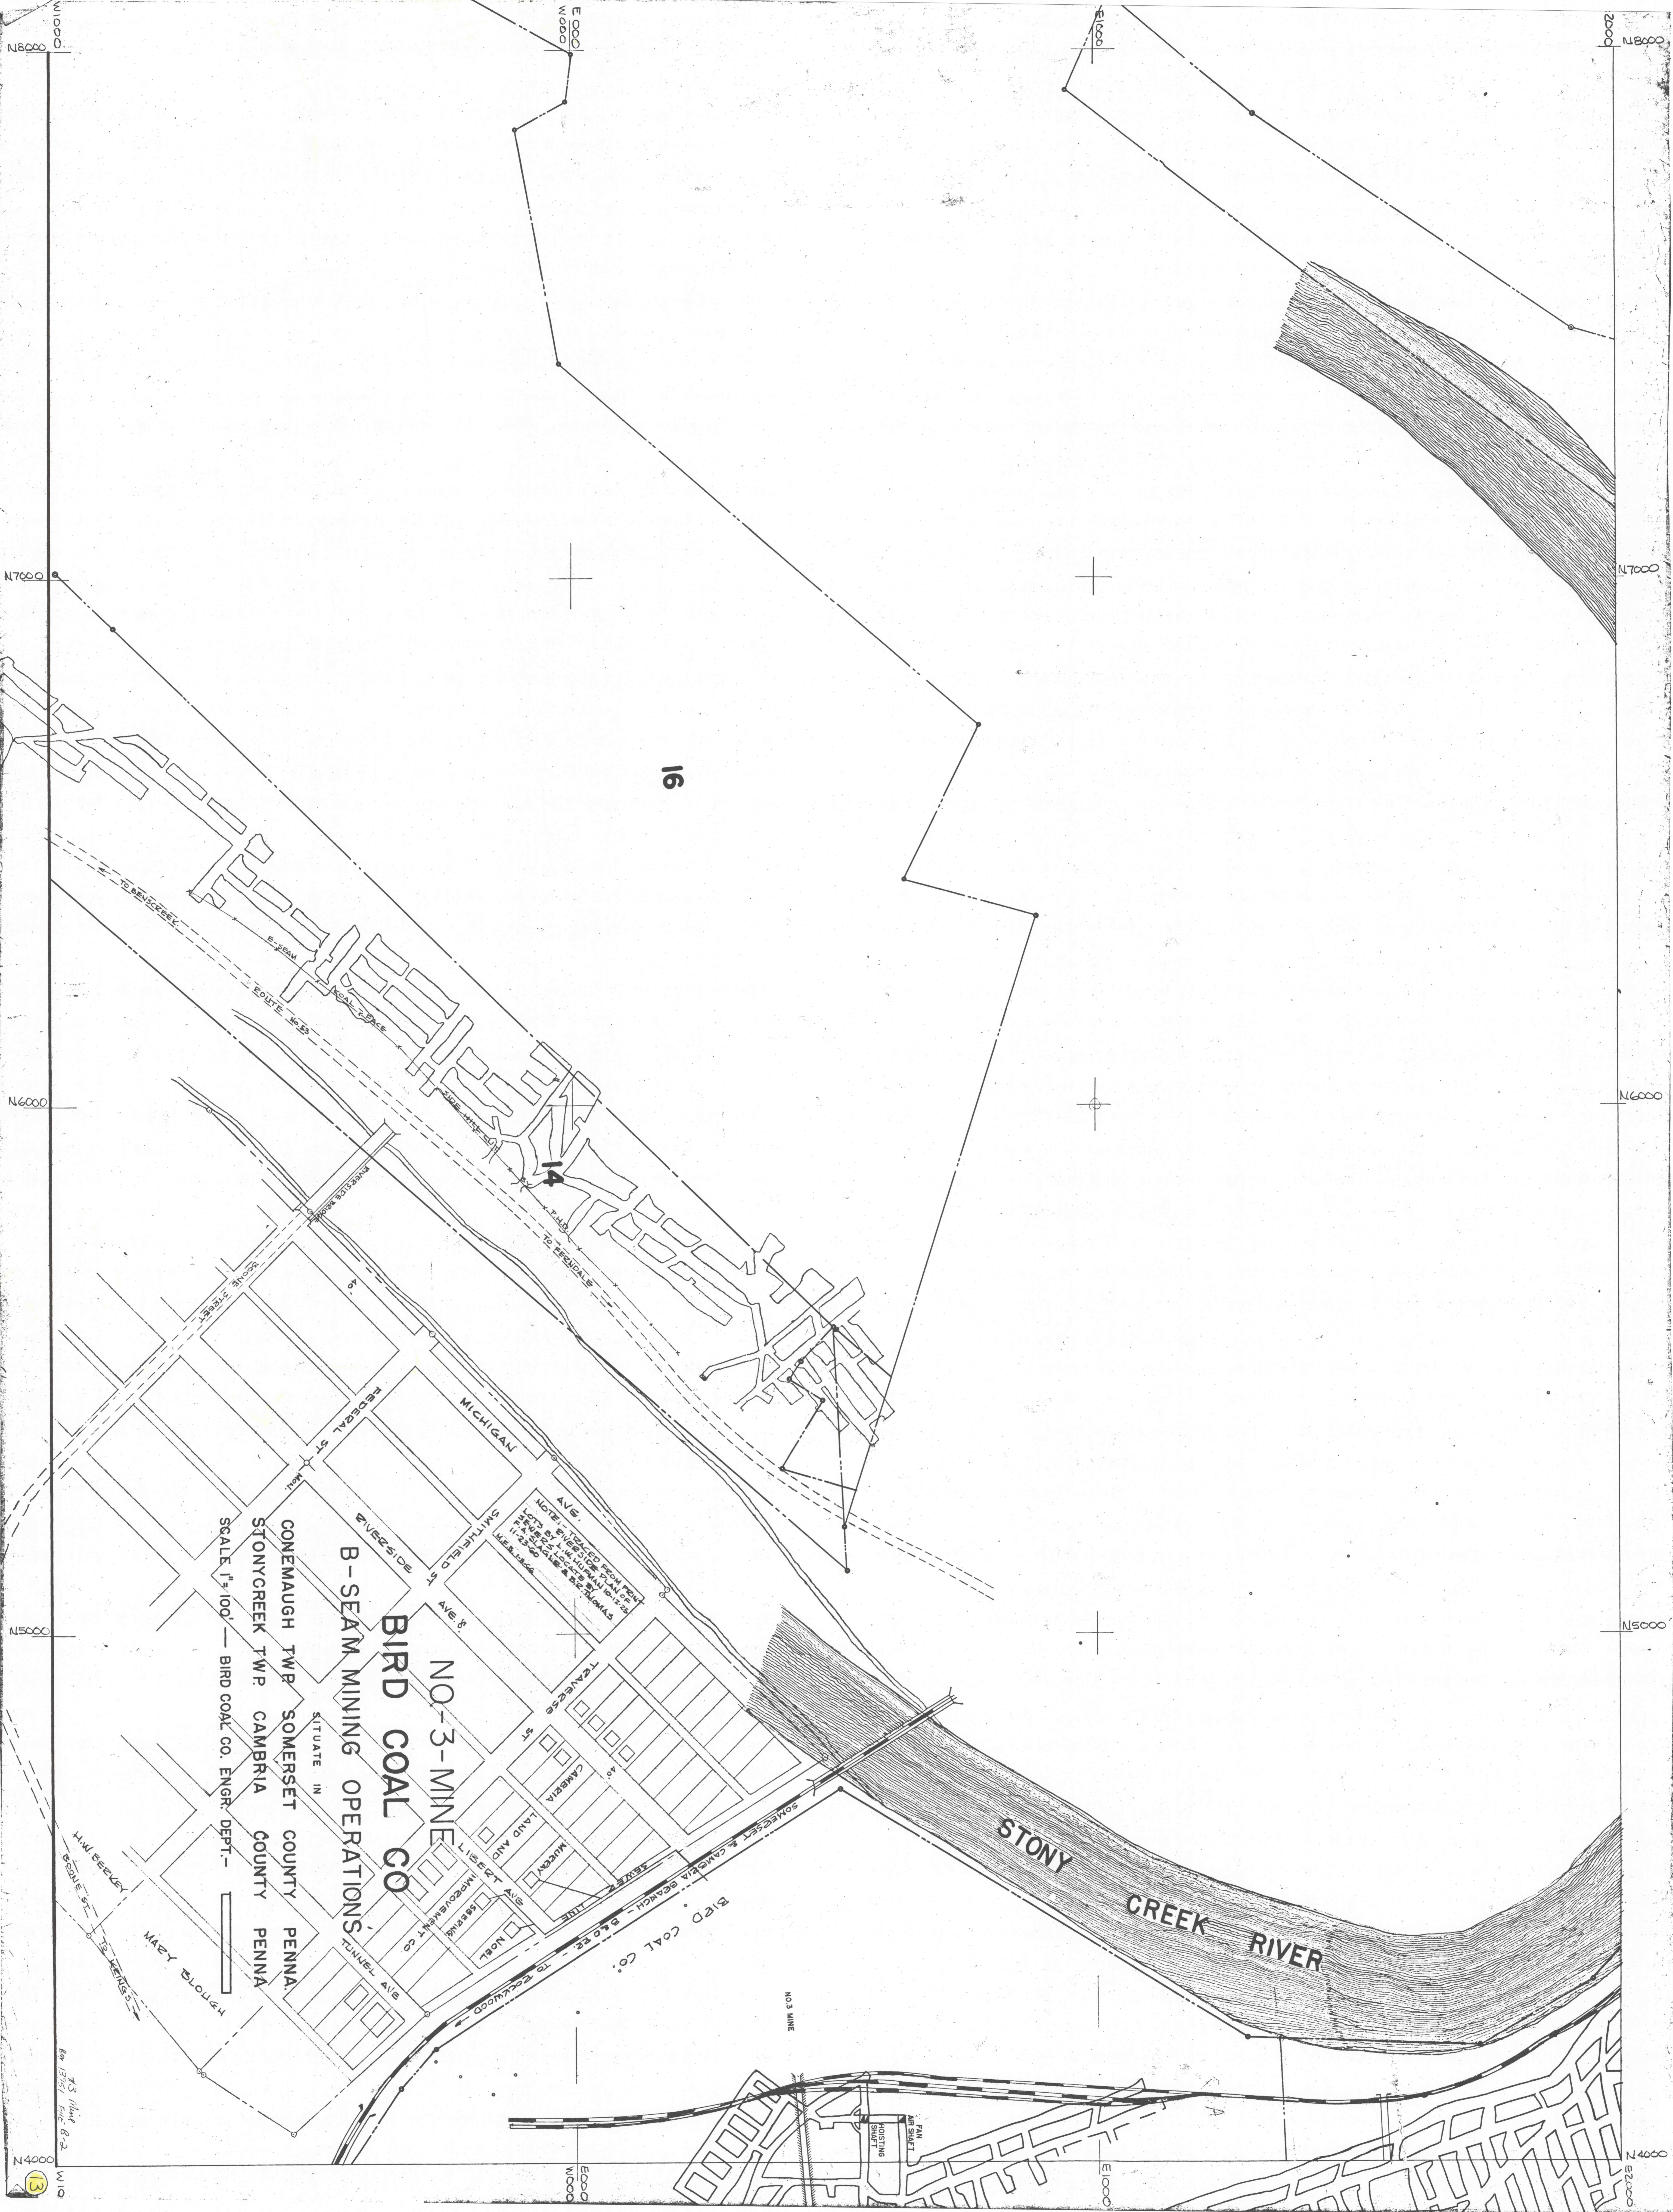

16

14

NO-3-MINE
BIRD COAL CO

B-SEAM MINING OPERATIONS

CONEMAUGH TWP SOMERSET COUNTY PENNA.
STONYCREEK TWP CAMBRIA COUNTY PENNA.
SCALE 1"=100' — BIRD COAL CO. ENGR. DEPT. —

STONY
CREEK
RIVER