


5000
0000
0000
0000
0000
0000

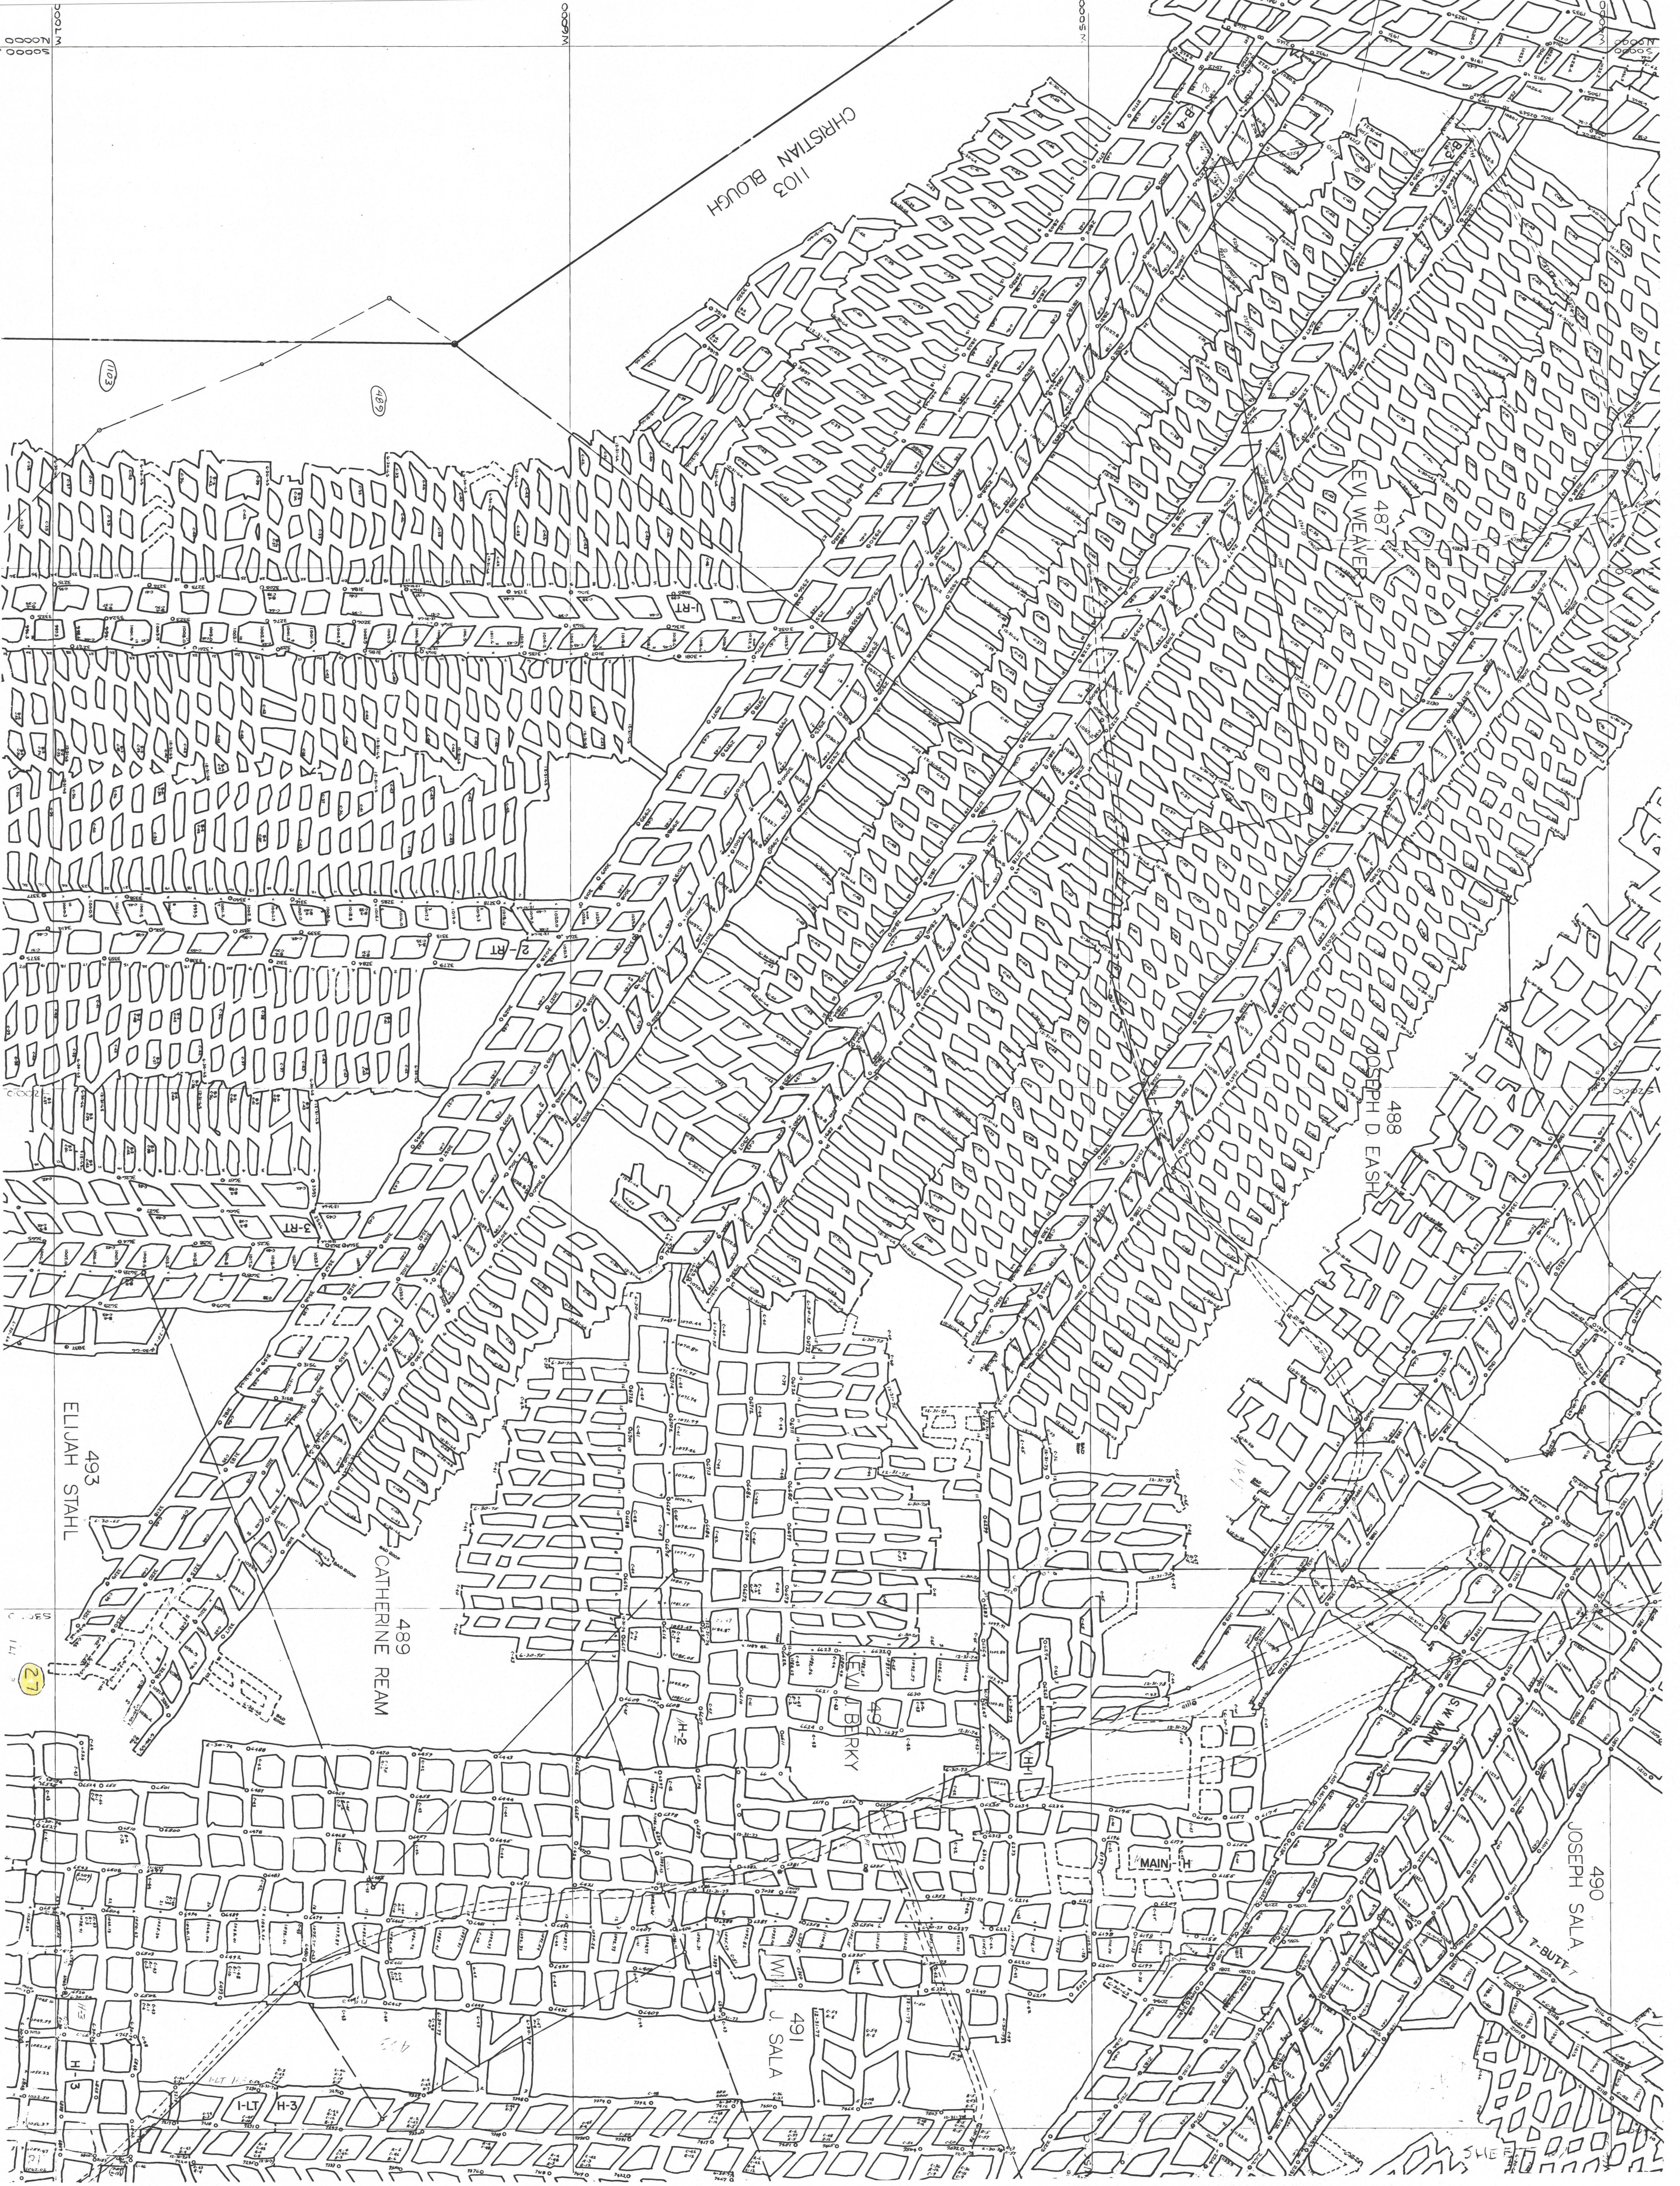

1103
CHRISTIAN BLOUGH

487
LEW WEANER

488
JOSEPH D EAST

493
ELIUAH STAHL

489
CATHERINE REAM

492
LEW BERKY

491
J SALA

490
JOSEPH SALA

H-3
I-LT

546