


Raridan East Brady Coal Co. Lands.

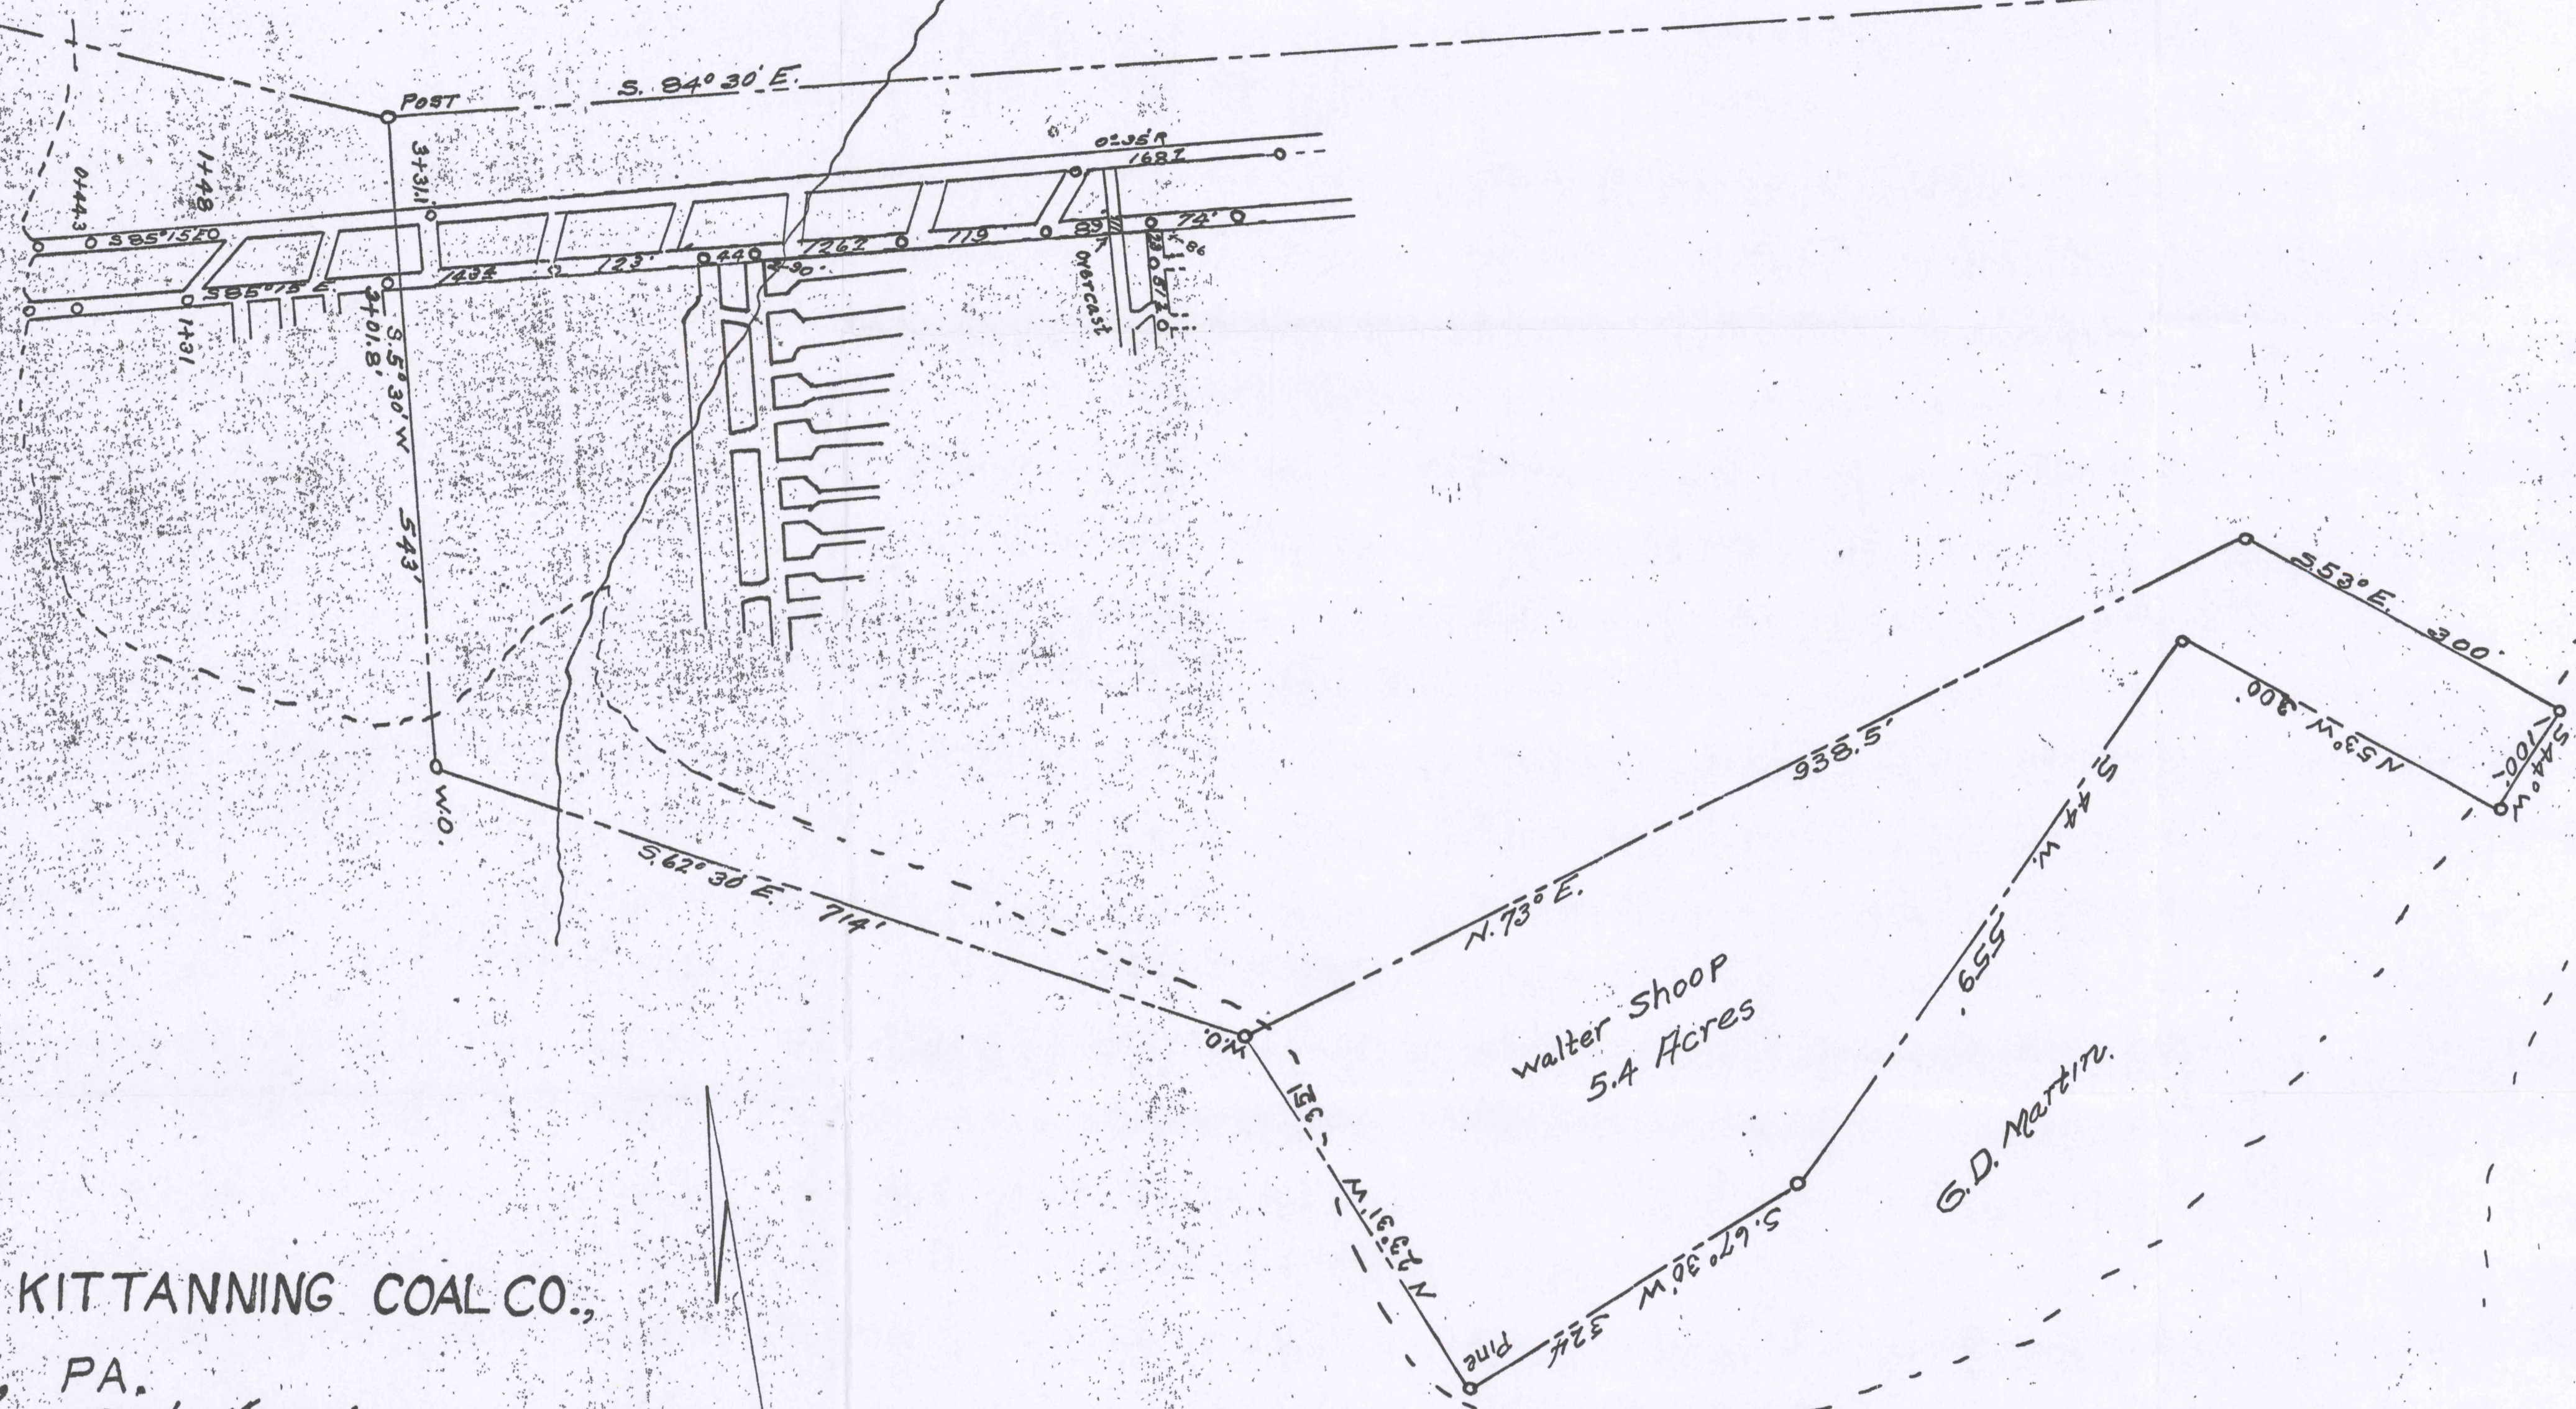

STAUFFER KITTANNING COAL CO.,

KELLY, PA.

Wm. H. Kelly, Eng.
Harrisburg Pa.

Scale 1" = 100'
July 15, 1921.
Mar. 15, 1923.